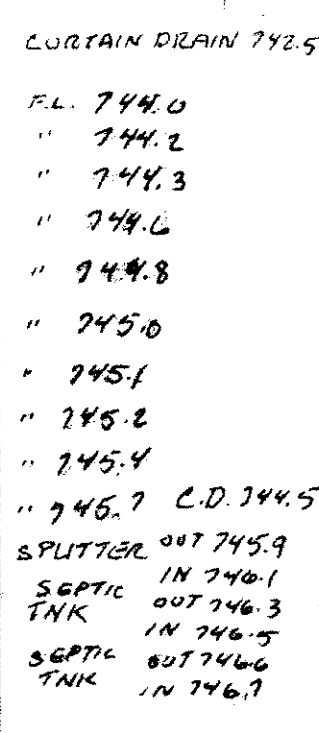
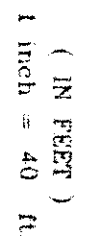


John C. Spencer

John Thompson

Name the respondent

MIT NO. 667
G INSPECTOR

IRZU1510US
JUN. 21. 55 ADD COUNTERS & HW REL. ADD W.L.
B.R.S. ELU. 4007. 00.

44-38861-908

Reviewed and Accepted _____

 LAKE COUNTY GENERAL HEALTH DISTRICT
 Date 6-22-95

 JOEL LUCIA, R. S., M. P. H.
 Health Commissioner
 BY J. Lucia _____

- A. To be brought to finished grade
1. Septic tank manhole covers
2. Splitter box cover
3. Distribution box cover
- B. No footer drains or downspouts
to be discharged into septic tanks
- C. All waste water to be discharged in
septic tanks

THE COUNTY OF LAKE
THE STATE OF OHIO

DRAWN BY:	SRL	DATE:	2/95
CHECKED BY:	JCS	DRAWING NO.:	A2T-091

Drive Culvert