
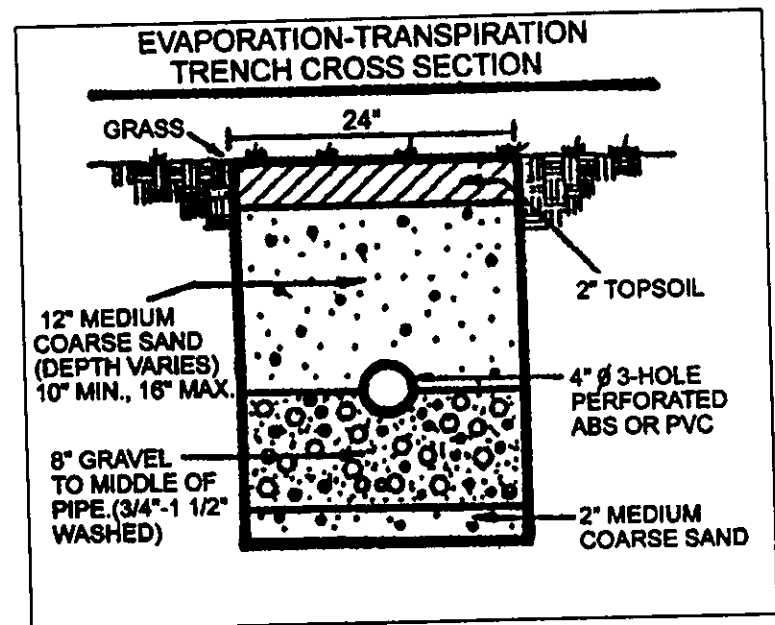


REVIEWED AND ACCEPTED
LAKE COUNTY GENERAL
HEALTH DISTRICT

5-11-99
S. H. Jones

SEWAGE DISPOSAL PERMIT MUST BE
OBTAINED BY A LAKE COUNTY LICENSED
INSTALLER BEFORE INSTALLATION IS
STARTED

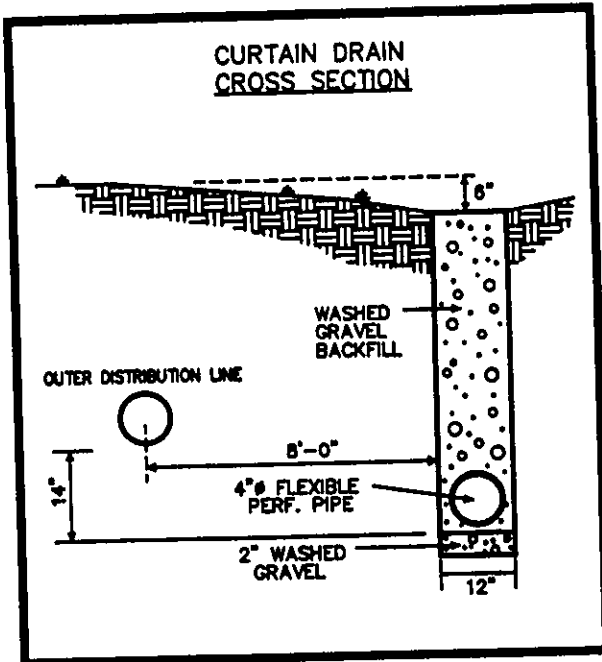

S/L 11
(vacant)


S/L 12
2.976 AG.

S/L 13
(vacant)

ZONING CONTINGENT
ON PREVIOUSLY
APPROVED SIDE LINES
587 BAC PERRY TWP
ZONING PERMIT # 6512

By TAM 5/11/99
MIN 12" DRIVE CULVERT
MAX 12" DRIVE CULVERT BE 10'
CONTINGENT ON
REVISION AND PERRY TWP
ZONING

LAKE COUNTY ENGINEER

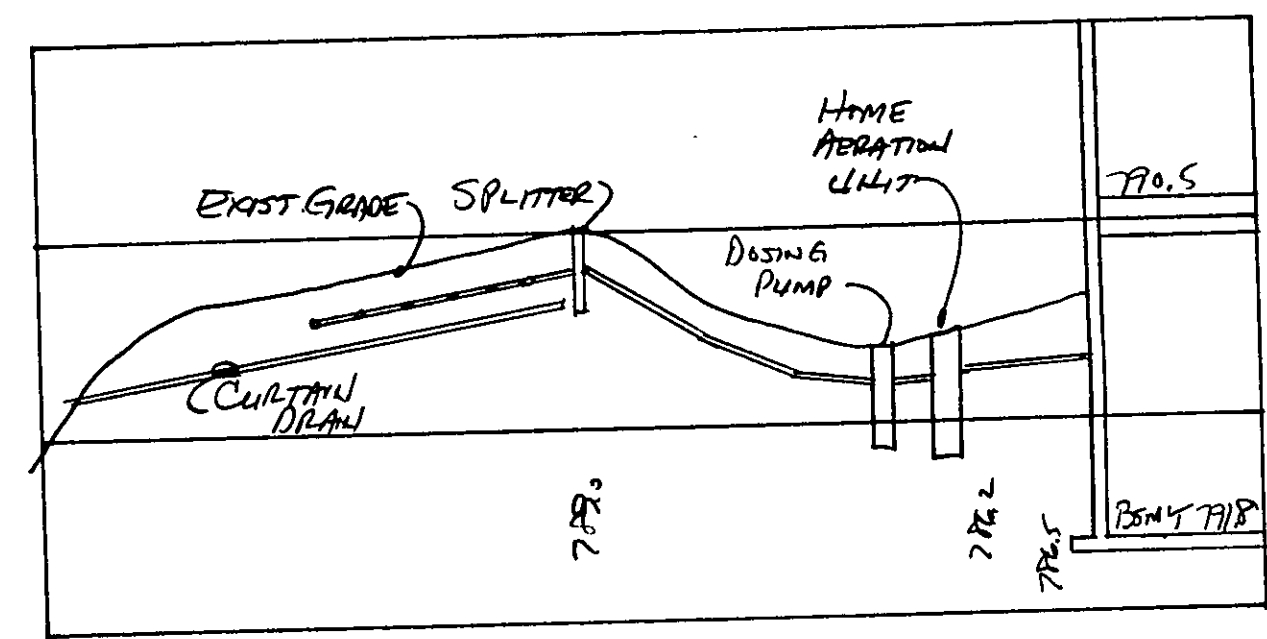


HYDRAULIC PROFILE
HORIZ: 1"=30' VERT: 1"=5'

"I, the undersigned hereby certify that
this topography indicated by 5', 1', or 2'
contours, and elevations shown hereon
represent an actual field survey made by
me on the 1st day of May, 1999
and that the elevations were taken at
appropriate intervals and that as of that
date they existed as indicated hereon."

Harry S. Jones #6343
Name Reg. No.

TBM-RADIUS POINT
ELEV.=785.41

C1:R=80.00'
L=53.33'
T=27.70'
D=38'11"50"
C=52.35'
S29°58'44"W

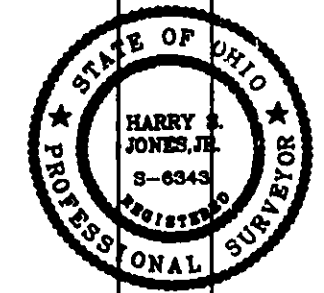

REV NO.	DESCRIPTION	DATE	BY	CHK'D
1	Revised house location & added wetlands	5/7/99	T.R.	H.J.

babcock, jones and associates, inc
CIVIL ENGINEERS - SURVEYORS - LAND PLANNERS
PAINESVILLE OHIO 44077

DATE 5/2/99
DESIGN BY H.J.
DRAWN BY T.R.
APPROVED BY H.J.

SITE PLAN
FOR
MERKOSKY
S/L 12 RIVERWOOD SUB.
PERRY TOWNSHIP LAKE COUNTY

SCALE: 1"=30'
JOB NO. 96-272-12
SHEET 1 OF 1