
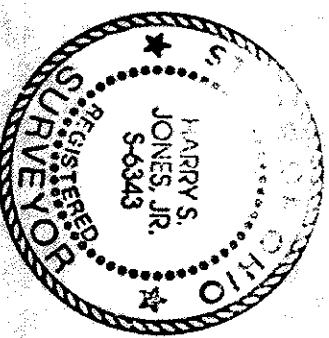


HYDRAULIC PROFILE

Horizontal: 1" = 30' Vertical: 1" = 5'

Grading Plan Approved
as shown and noted
THOMAS P. GILLES, P.E.
Lake County Engineer

Eliminate drive culvert
and replace roadside
ditch to catch basin

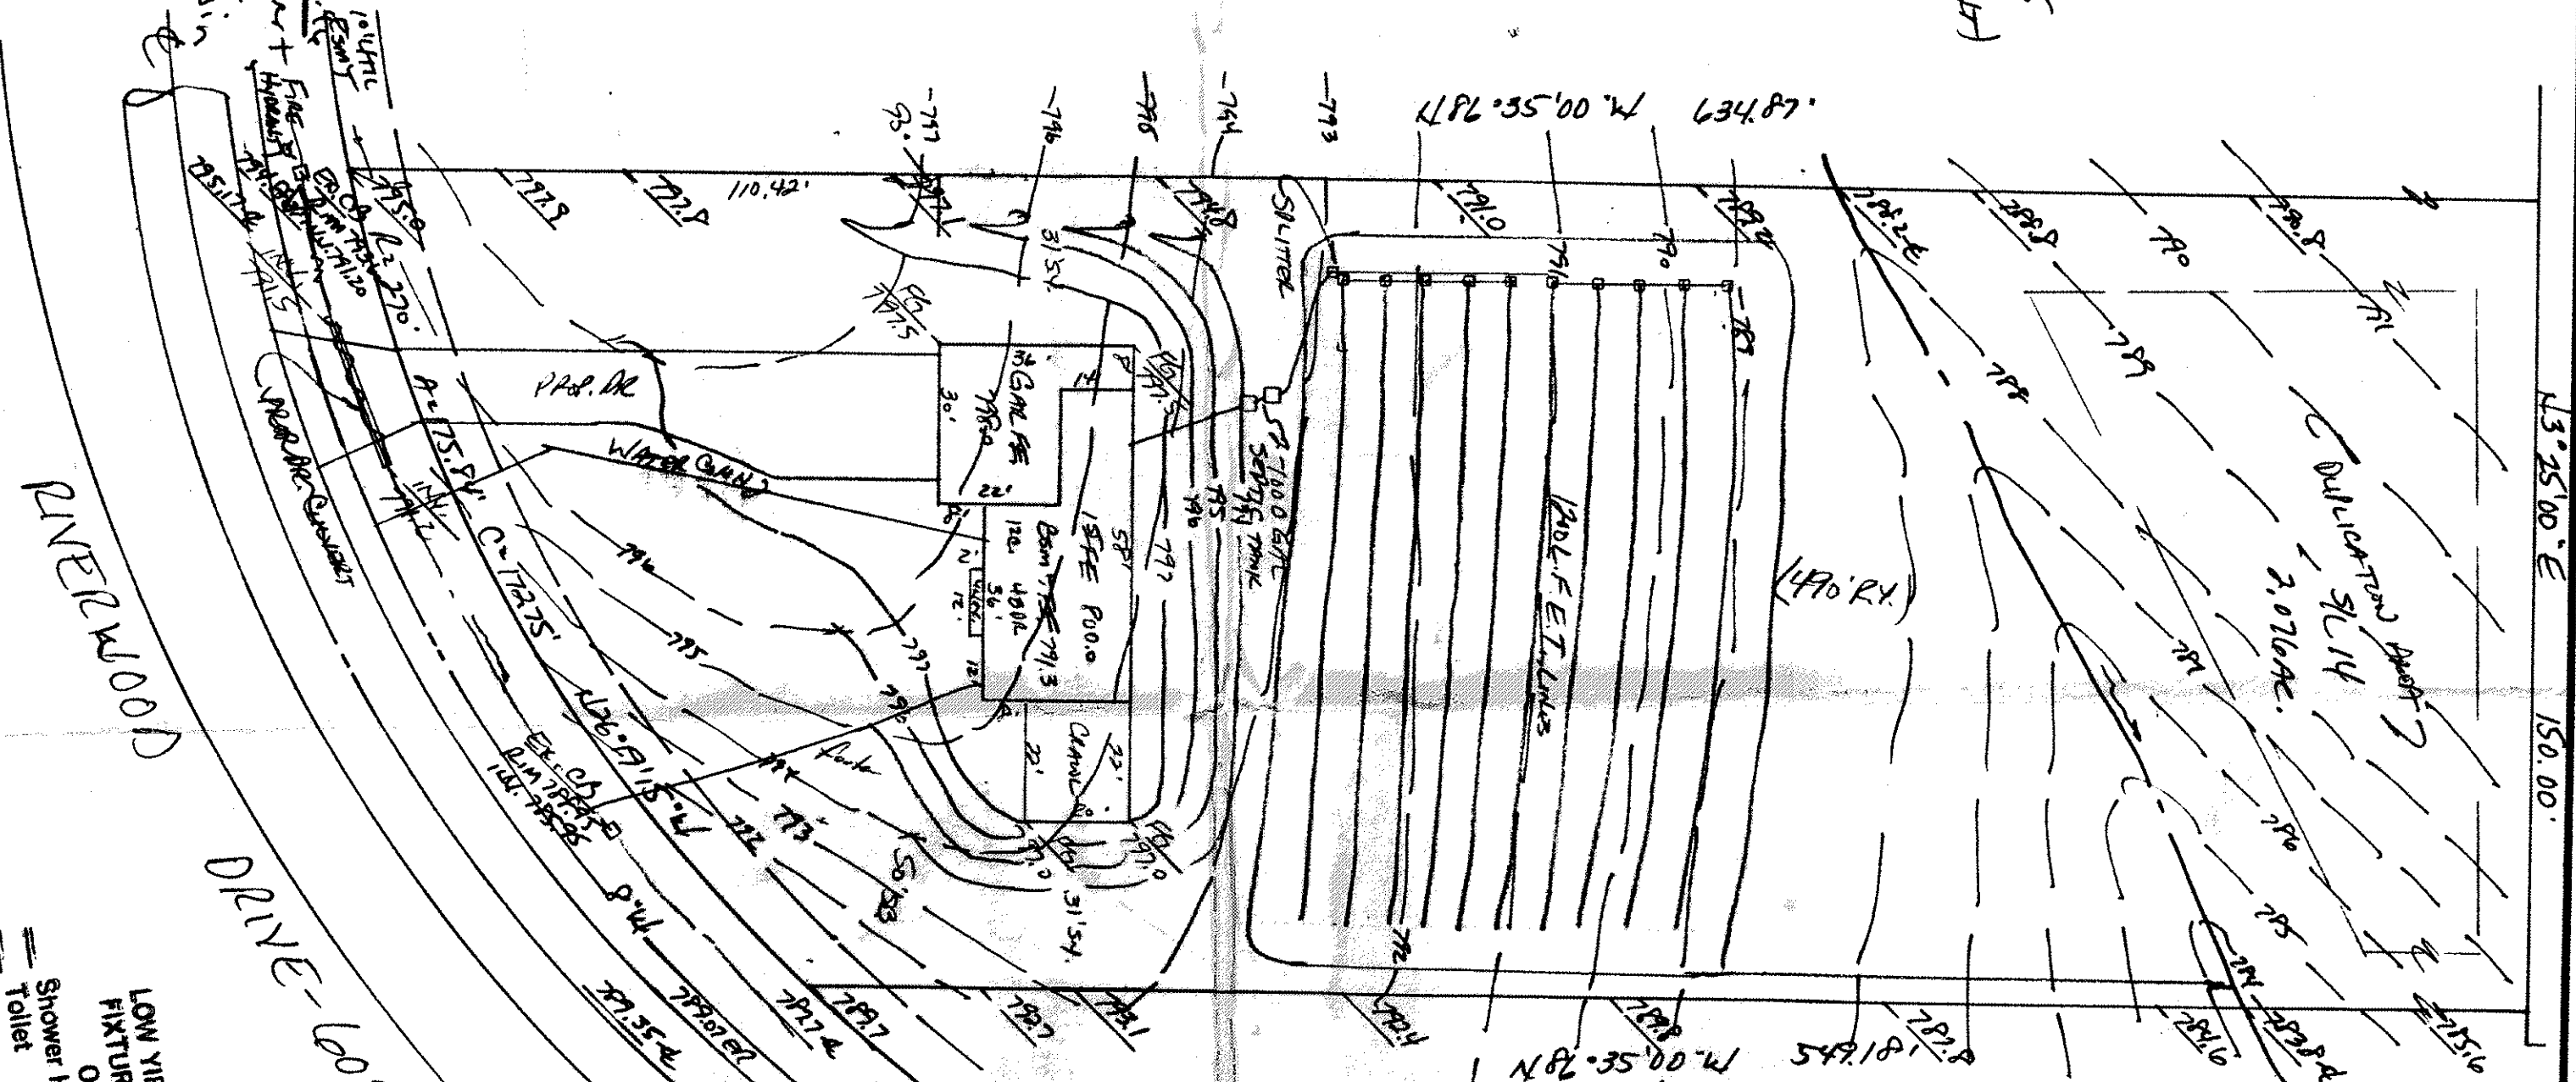

SEWAGE DISPOSAL PERMIT MUST BE
OBTAINED BY A LAKE COUNTY LICENSED
INSTALLER BEFORE INSTALLATION IS
STARTED.

Reviewed and Accepted, HEREBY CERTIFY THAT THE CIRCLED GRADES ARE EXISTING
LAKE COUNTY GENERAL HEALTH INSPECTOR
JOEL LUCIA, R.S.M.P.H.
Health Commissioner
J. L. Lucia, Jr.
10-23-96
REGISTERED SURVEYOR

APPROVED
SIDE LINES & SET BACK
PERRY TOWNSHIP ZONING
PERMIT NO. 6343
ZONING INSPECTOR

LOW YIELD WATER
FIXTURES REQUIRED
ON ALL:
Shower Head
Toilet

SITE PLAN

Perry Township, Lake County, Ohio

For: Harry McCaskey

ADDRESS STREET CITY ZIP

Subdivision 23-28 NAME LOT TRACT
14 VOLUME PAGE
SUBLOT NO. 14 PERM. PARCEL NO. STREET

LEGEND	
SANITARY MANHOLE	○
STORM MANHOLE	●
INLET OR CATCH BASIN	□
HYDRANT	⊕
EXISTING CONTOURS	---
PROPOSED CONTOURS	---
EXIST. ELEV.	1000.0
PROP. ELEV.	1000.0
INDICATES DIRECTION OF SURFACE DRAINAGE	→

REMARKS
ALL BOUNDARY DATA SHOWN WAS OBTAINED FROM IDEEDS, RECORDED
SUBDIVISION PLAT OR OTHER PUBLIC RECORDS
LOCATIONS AS SHOWN OF ADJACENT WELLS AND SEPTIC TANKS OBTAINED FROM
LAKE COUNTY HEALTH DEPARTMENT

DESIGN CERTIFICATION
THIS PLAN WAS PREPARED BY ME, AND IS CORRECT
TO THE BEST OF MY KNOWLEDGE AND BELIEF.

NAME SURVEYOR REGISTRATION NO.

NO. OF BEDROOMS	NO. OF BATHS	NO. OF GARAGES	NO. OF POOLS	NO. OF OTHER STRUCTURES
1	1	1	1	1
2	2	2	2	2
3	3	3	3	3
4	4	4	4	4
5	5	5	5	5

PLAN PREPARED BY:
BABCOCK & JONES & ASSOCIATES, INC.
PAINESVILLE, OHIO

NO.	DATE	BY	SCALE	PHONE NO.
1	10-23-96	HT	1" = 30'	357-1811
2	11-19-96	HT	1" = 30'	357-1811
3	12-14-96	HT	1" = 30'	357-1811
4	12-14-96	HT	1" = 30'	357-1811
5	12-14-96	HT	1" = 30'	357-1811

"AS BUILT" CERTIFICATION

HEREBY CERTIFY THAT THE CIRCLED GRADES ARE EXISTING
FINISH GRADES CHECKED IN THE FIELD ON 19
LAKE COUNTY GENERAL HEALTH INSPECTOR
JOEL LUCIA, R.S.M.P.H.
Health Commissioner
J. L. Lucia, Jr.
10-23-96
REGISTERED SURVEYOR

REG. NO.
A. To be brought to finished grade
1. Septic tank manhole covers
2. Splitter box cover
3. Distribution box cover
B. No footer drains or downspouts
to be discharged into septic tanks
C. All waste water to be discharged into
septic tanks

"I, the undersigned, hereby certify that this topographic map, showing contours, and the survey made by me on the 20th day of October, 1996, and that the elevations were taken at appropriate intervals and that as of that date they existed as indicated hereon."

Name Harry McCaskey Reg. No. 6343