


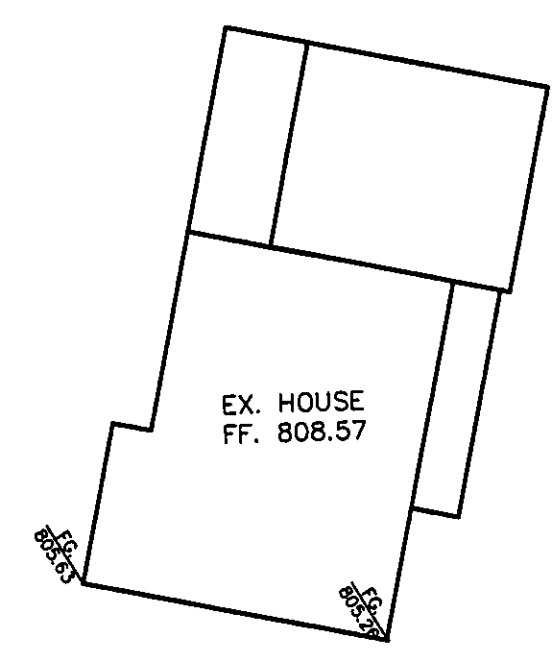


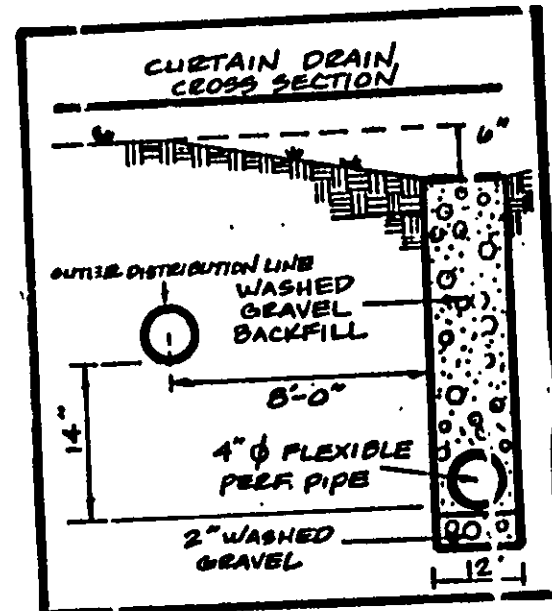

REVIEWED AND ACCEPTED  
LAKE COUNTY GENERAL  
HEALTH DISTRICT  
Date 8/18/98 BY Daniell  
SEWAGE DISPOSAL PERMIT MUST BE  
OBTAINED BY A LAKE COUNTY LICENSED  
INSTALLER BEFORE INSTALLATION IS  
STARTED.

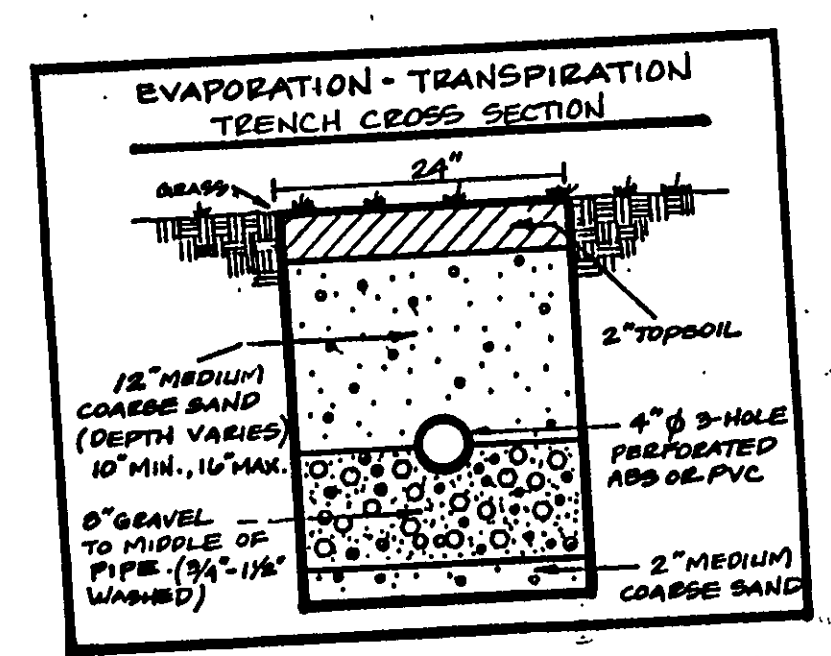

"I, the undersigned hereby certify that  
this topography indicated by 6", 1" or 2"  
contours, and elevations shown hereon  
represent an actual field survey made by  
me on the 14 day of Aug, 1998  
and that the elevations were taken at  
appropriate intervals and that as of that  
date they existed as indicated hereon."  
Name Harry Jones Reg. No. 6343

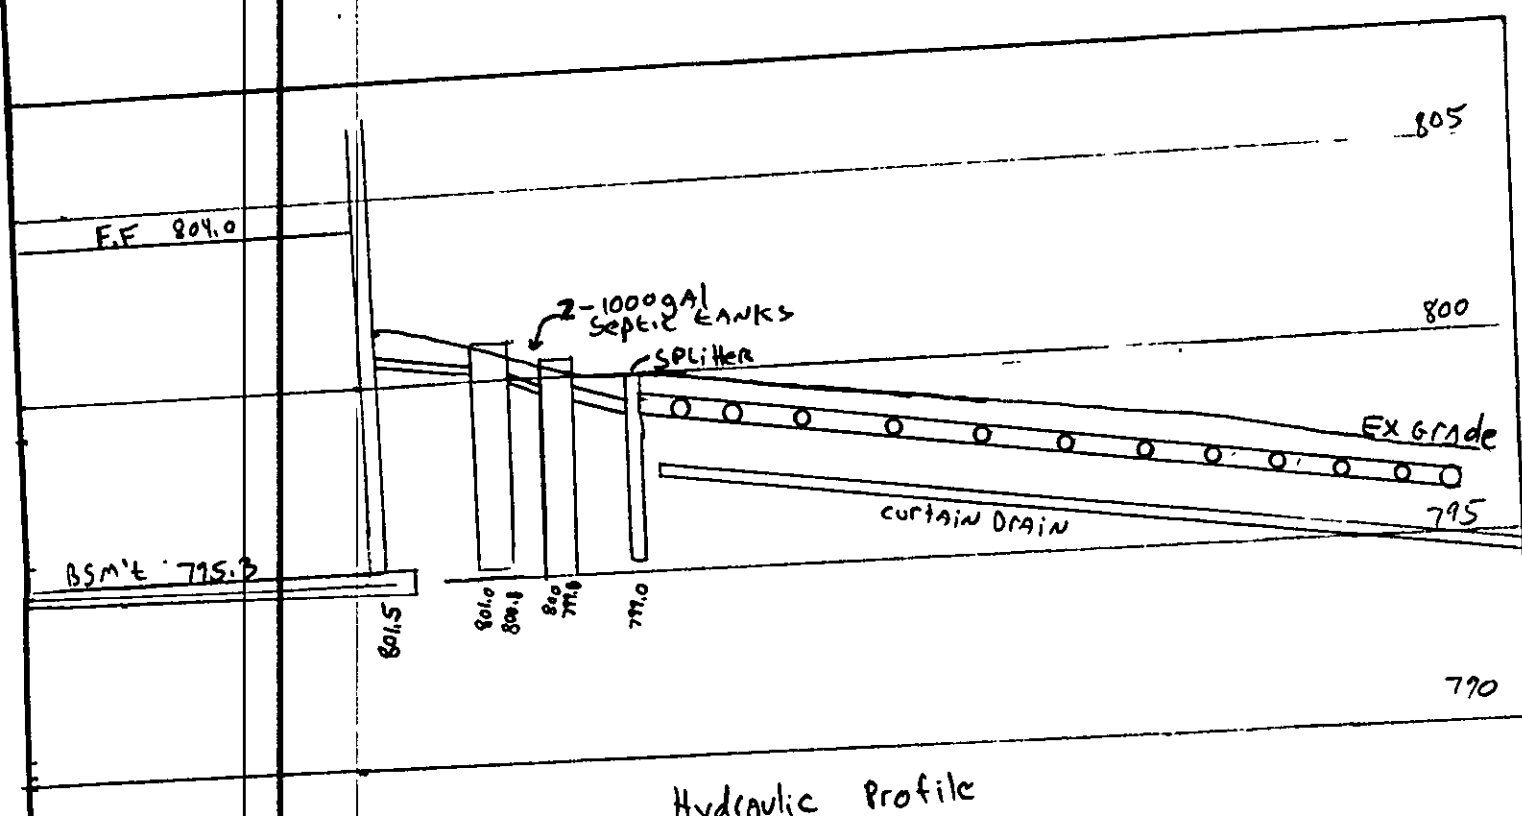

Grading Plan  
Thomas P. Gilles, P.E.  
Lake County Engineer  
By GJA Date 8.19.98

TBM-TOP HYDRANT  
ELEV.=797.64

C1: R=330.00'  
D=01°50'37"  
A=10.62'  
C=10.62'  
N02°29'42"E  
C2: R=530.00'  
D=07°41'51"  
A=71°20'  
C=71.15'  
N07°15'56"E

| REV NO. | DESCRIPTION | DATE | BY | CHK'D |
|---------|-------------|------|----|-------|
|         |             |      |    |       |
|         |             |      |    |       |
|         |             |      |    |       |
|         |             |      |    |       |

**bj** BABCOCK, JONES AND ASSOCIATES, INC  
CIVIL ENGINEERS - SURVEYORS - LAND PLANNERS  
PAINESVILLE OHIO 44077

DATE 8/14/98  
DESIGN BY H.J.  
DRAWN BY T.R.  
APPROVED BY H.J.

**SITE PLAN**  
FOR  
MILESTONE HOMES  
PERRY TOWNSHIP  
LAKE COUNTY

SCALE: 1"=20'  
JOB NO. 96-272-06  
SHEET 1 OF 1