

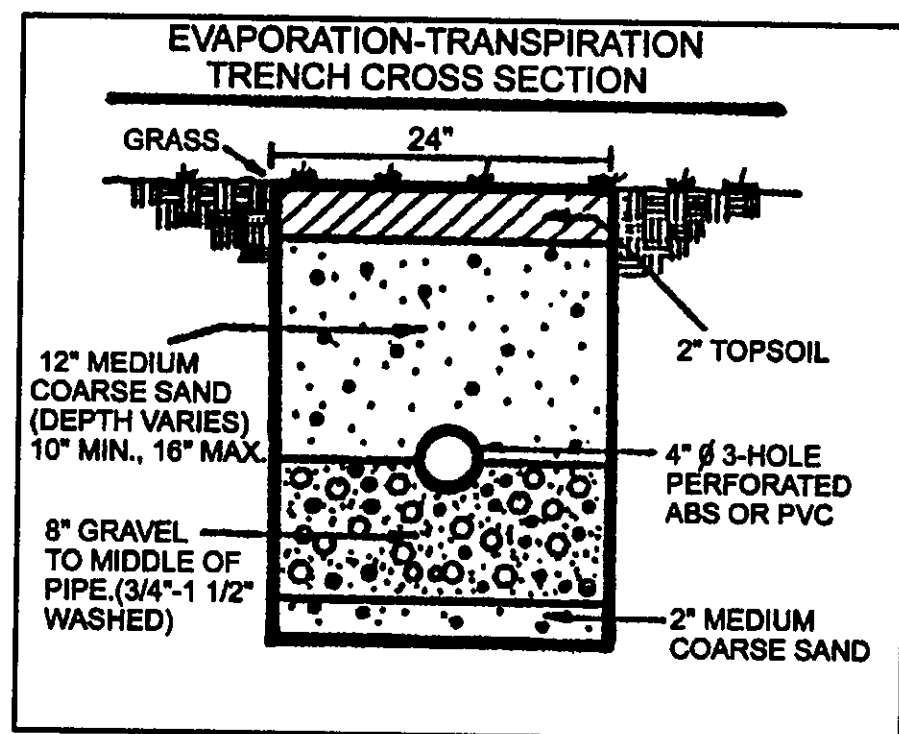
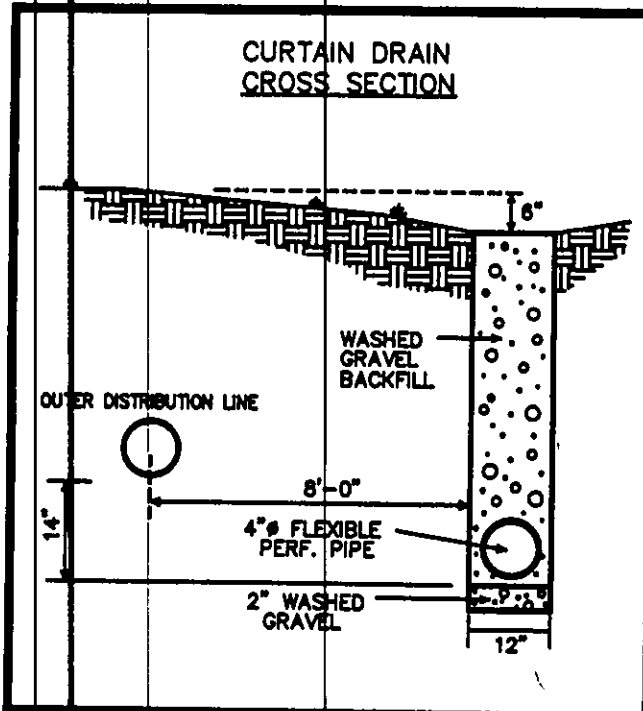


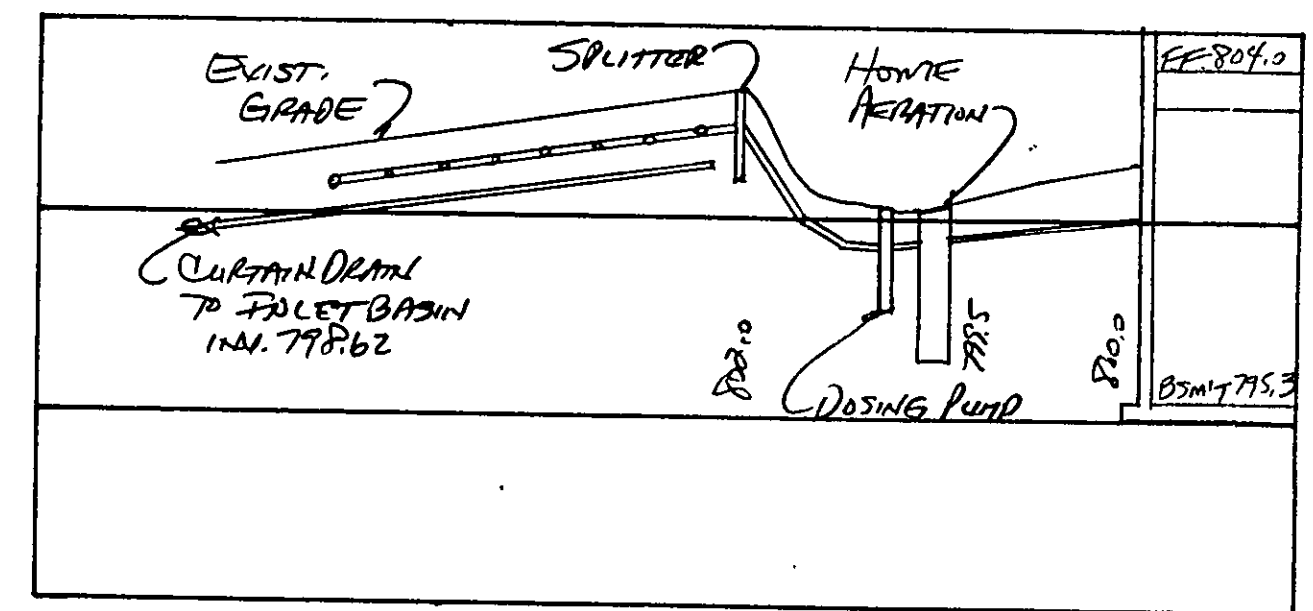

REVIEWED AND ACCEPTED
LAKE COUNTY GENERAL
HEALTH DISTRICT

DATE 1-31-00
SIGNED BY [Signature]

SEWAGE DISPOSAL PERMIT MUST BE
OBTAINED BY A LAKE COUNTY LICENSED
INSTALLER BEFORE INSTALLATION IS
STARTED

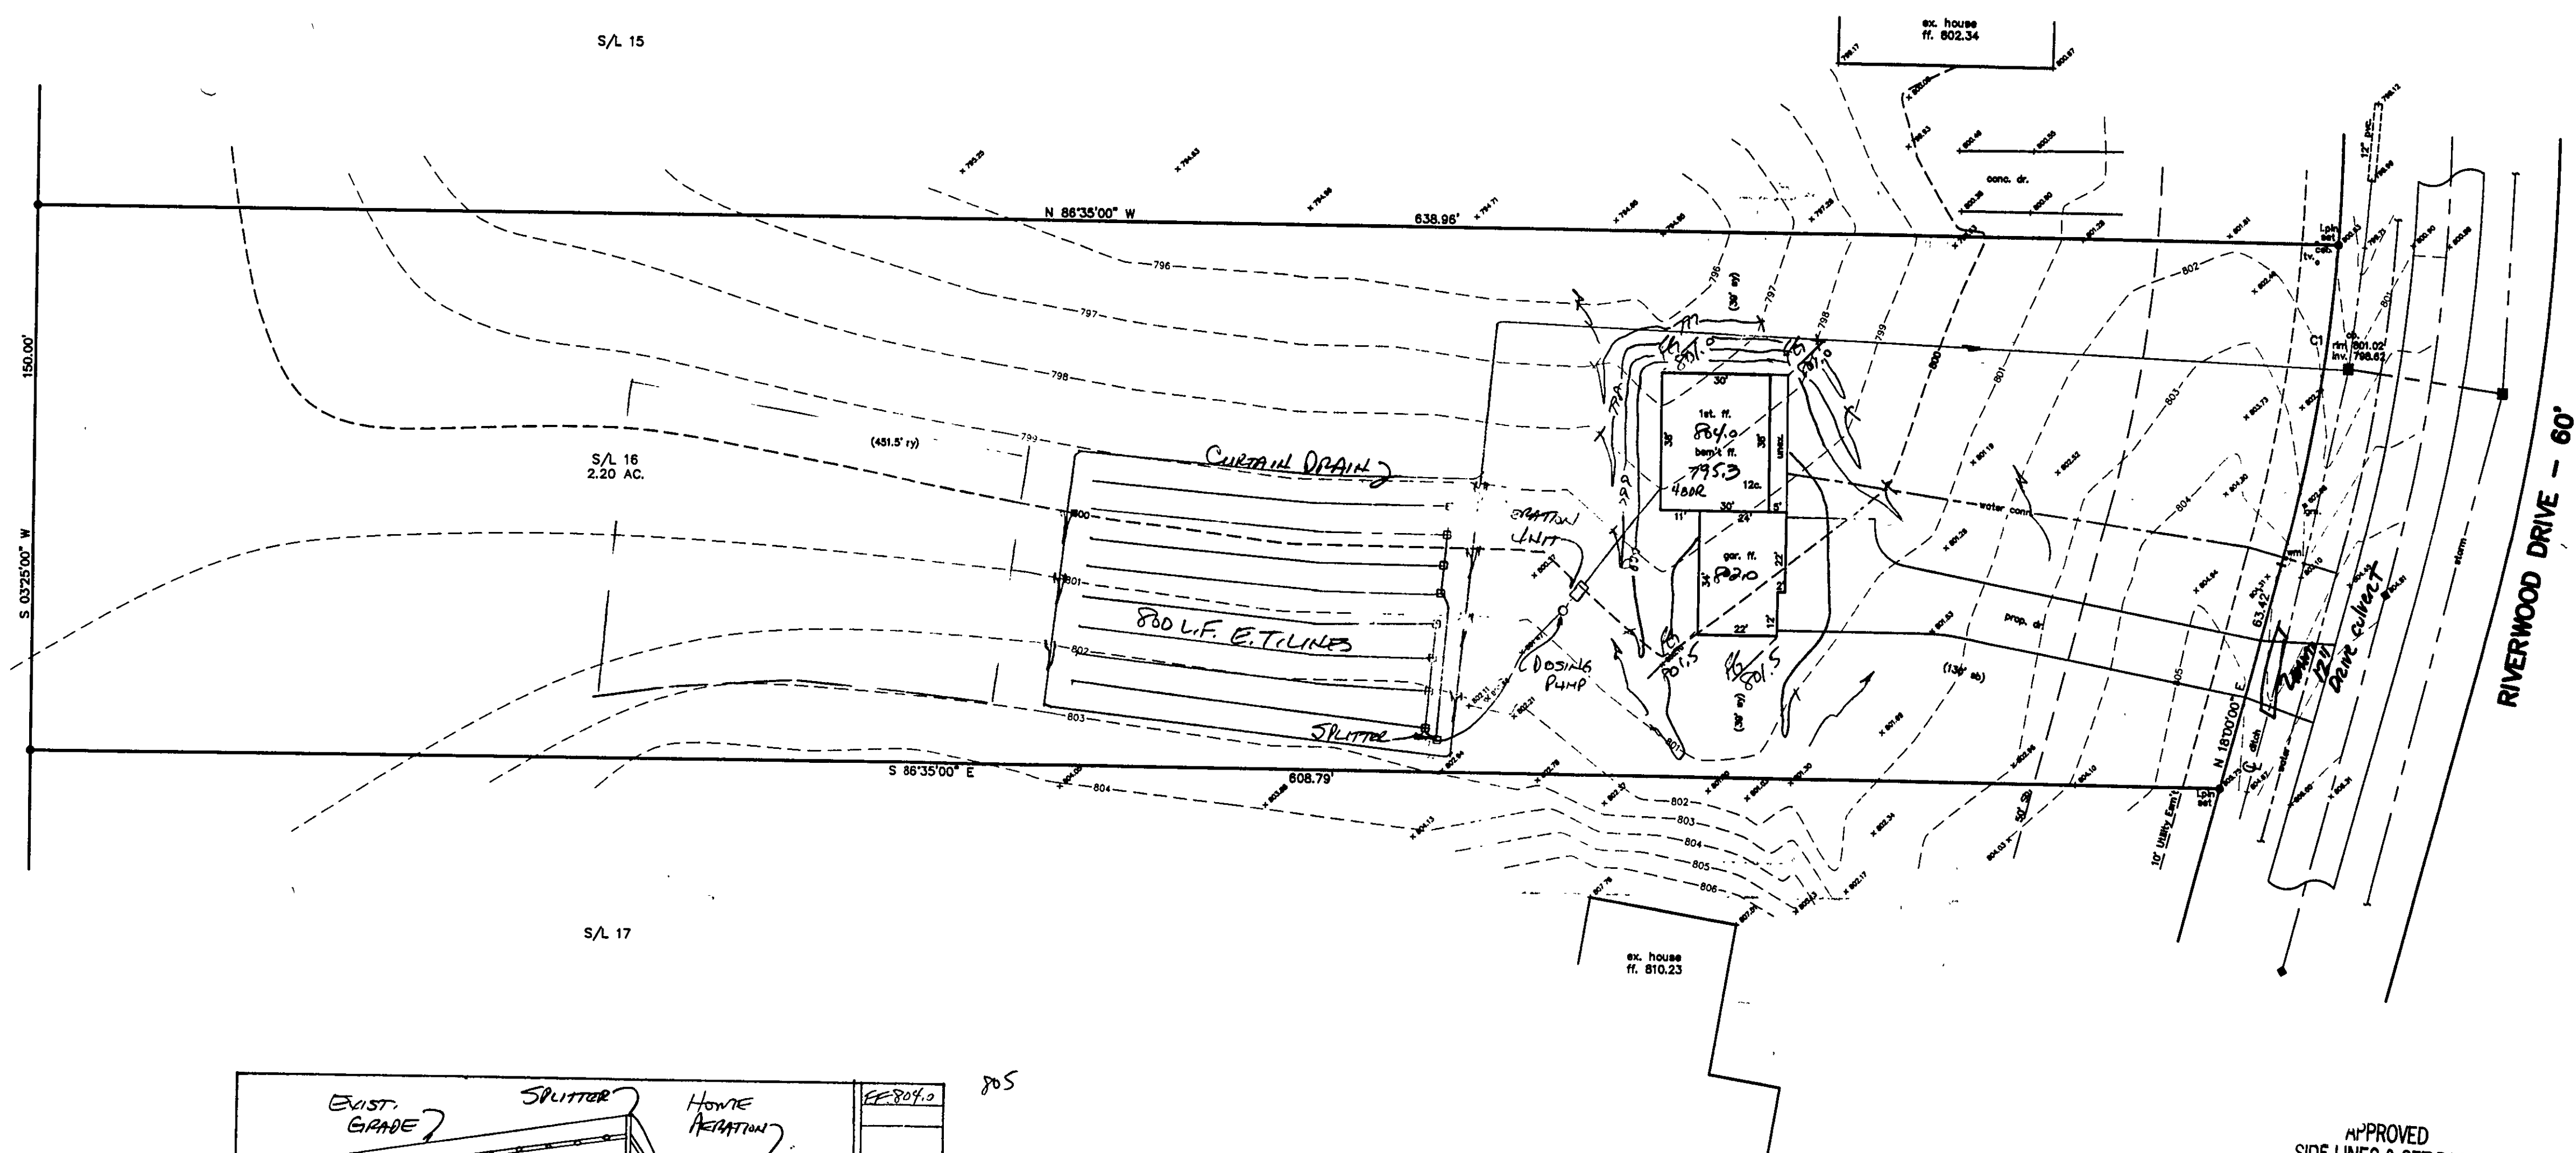

HYDRAULIC PROFILE
HORIZ: 1"=30' VERT: 1"=5'

TBM-TOP OF HYDRANT S/L 17,18
ELEV.=809.76

C1: R=470.00'
L=89.89'
T=45.08'
D=10°57'30"
C=89.75'
N12°31'15"E

"I, the undersigned hereby certify that this topography indicated by 6", 1", or 2" contours, and elevations shown hereon represent an actual field survey made by me on the 10th day of JAN 2000 and that the elevations were taken at appropriate intervals and that as of that date they existed as indicated hereon."

Name [Signature] Reg. No. 26343

APPROVED
SIDE LINES & SET BACK
PERRY TOWNSHIP ZONING
PERMIT NO. 6934
ZONING INSPECTOR

Grading Plan Approved
as shown and/or noted
THOMAS P. GILLES, P.E.
Lake County Engineer

By TAM Date 2/2/2000
MIN. 12" DRAIN COULVERT
ROOF DRAINS
SHALL DISCHARGE
TO SPLASH BLOCKS



REV. NO.	DESCRIPTION	DATE	BY	CHK'D

bj BABCOCK, JONES AND ASSOCIATES, INC.
CIVIL ENGINEERS - SURVEYORS - LAND PLANNERS
PAINESVILLE OHIO 44077

DATE 1/10/99
DESIGN BY H.J.
DRAWN BY T.R.
APPROVED BY H.J.

SITE PLAN
FOR
WESTCHESTER HOMES INC. 259-5755
S/L 16 RIVERWOOD SUB.
PERRY TOWNSHIP LAKE COUNTY

SCALE: 1"=30'
JOB NO. 96-272-16
SHEET 1 OF 1