

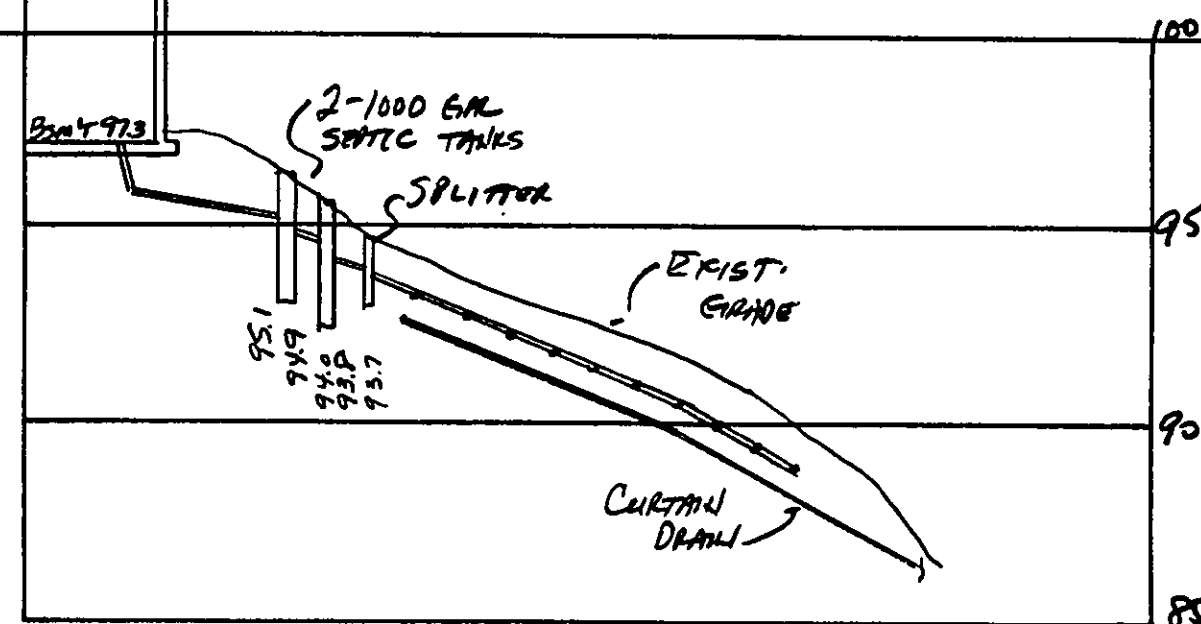
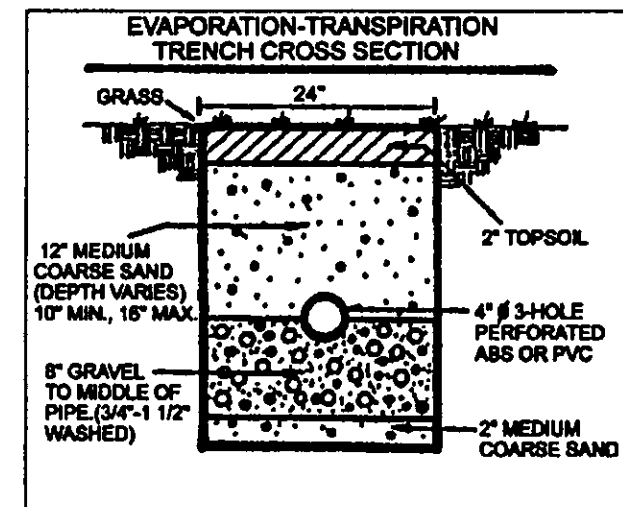


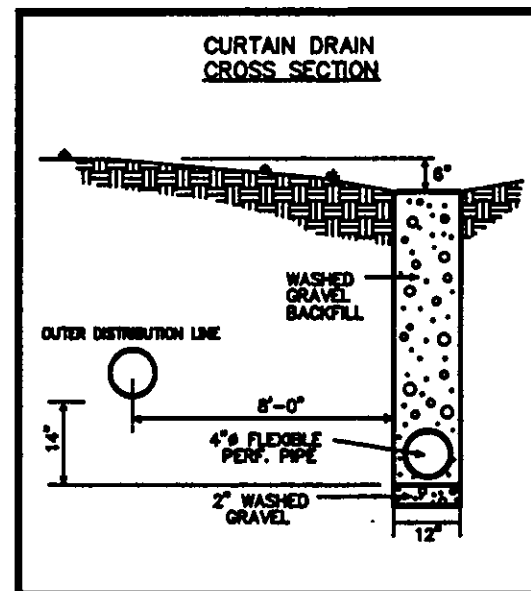

HYDRAULIC PROFILE
HORIZ: 1"=40' VERT: 1"=5'

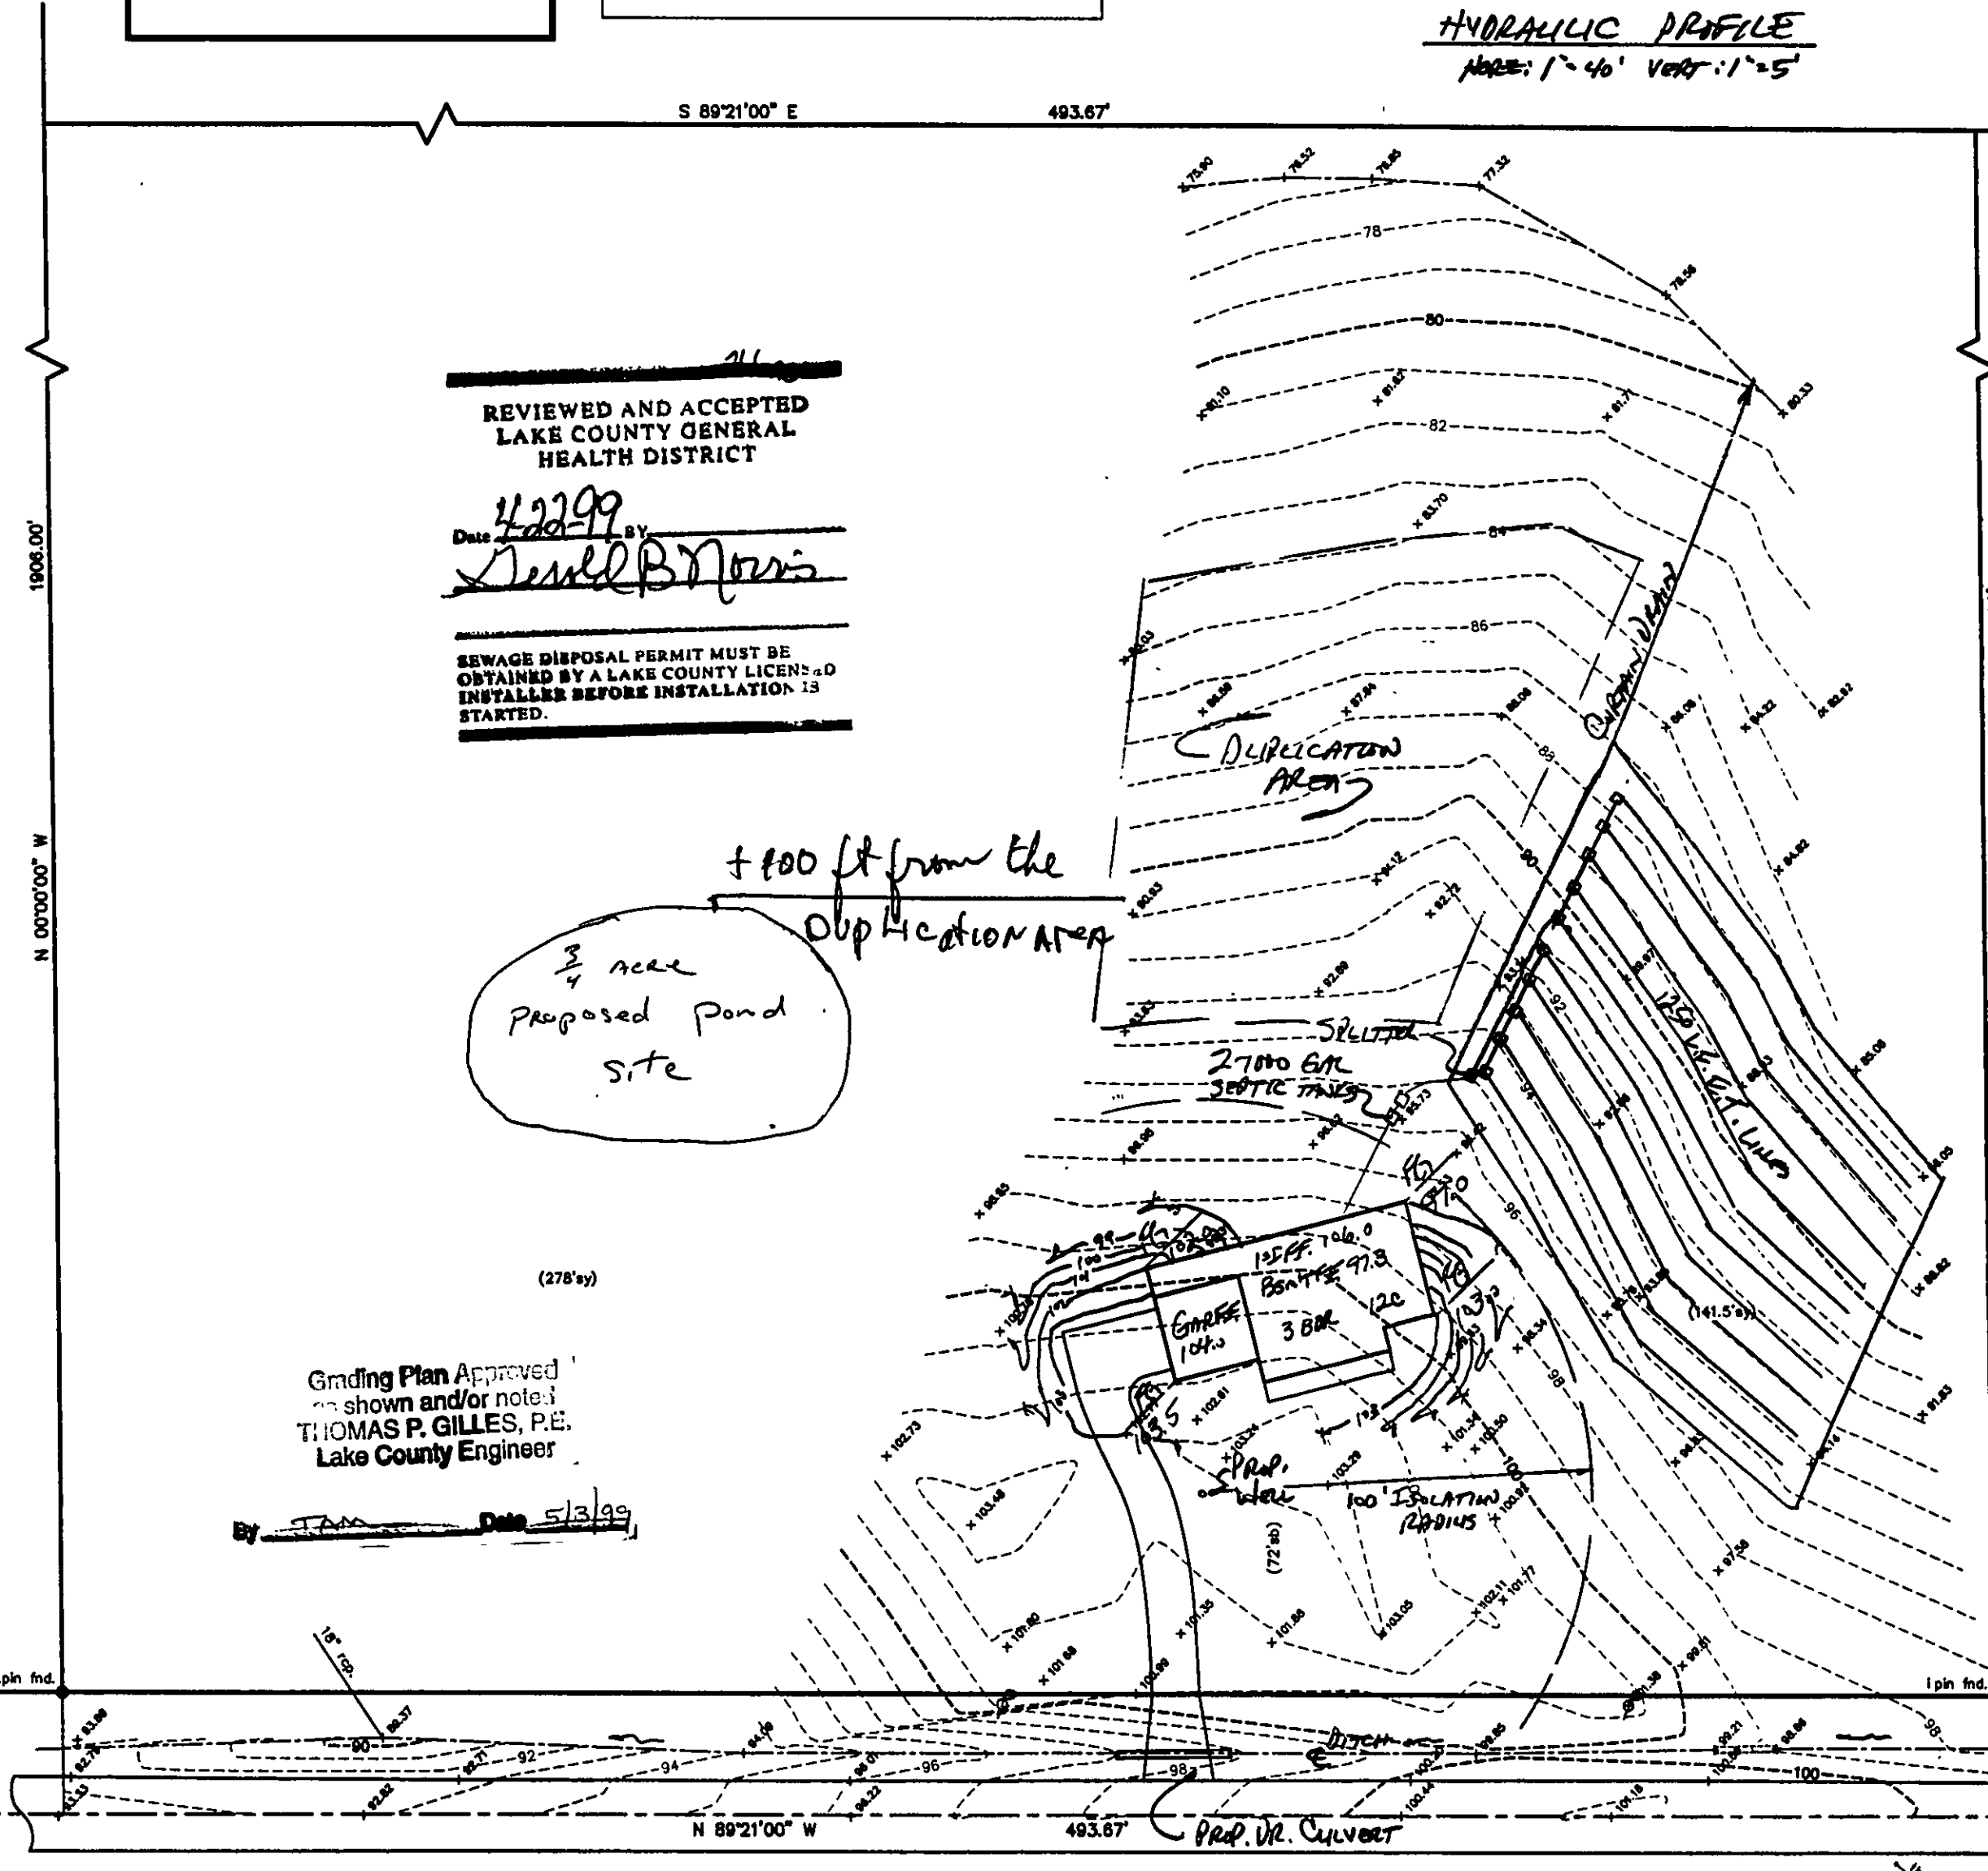

REVIEWED AND ACCEPTED
LAKE COUNTY GENERAL
HEALTH DISTRICT

Date 4-22-99
David B. Norris

SEWAGE DISPOSAL PERMIT MUST BE
OBTAINED BY A LAKE COUNTY LICENSED
INSTALLER BEFORE INSTALLATION IS
STARTED.

3/4 acre
Proposed pond
site

Grading Plan Approved
as shown and/or noted
THOMAS P. GILLES, P.E.
Lake County Engineer

By JAM Date 5/3/99

APPROVED
MADISON TOWNSHIP ZONING
DATE 4/29/99
BY JAM 16158

SITE PLAN

MADISON TOWNSHIP, LAKE COUNTY, OHIO
for: KIT CAMERON D.C. CONSTRUCTION
P.O. Box 270 AUSTIN, OHIO 44010-0270
ADDRESS STREET CITY ZIP

SUBDIVISION NAME TRACT ROSS RD.
VOL.-Pg. LOT STREET
SUBLOT NO. STREET VOL.-Pg. 1A-53-8
FED. PARCEL NO.

LEGEND

SANITARY MANHOLE --- --- EXIST. ELEV. --- PROP. ELEV.
STORM MANHOLE --- --- AS BUILT ELEVATION
INLET OR CATCH BASIN --- ---
HYDRANT --- --- INDICATES
EXISTING CONTOURS --- --- DIRECTION OF
PROPOSED CONTOURS --- --- SURFACE DRAINAGE

REMARKS

ALL BOUNDARY DATA SHOWN WAS OBTAINED FROM (DEEDS, RECORDED
SUBDIVISION PLAT OR OTHER PUBLIC RECORDS)
LOCATIONS AS SHOWN OF ADJACENT WELLS AND SEPTIC TANKS OBTAINED FROM
LAKE COUNTY HEALTH DEPARTMENT

DESIGN CERTIFICATION

THIS PLAT WAS PREPARED BY ME, AND IS CORRECT
TO THE BEST OF MY KNOWLEDGE AND BELIEF.

NAME Harry Jones SURVEYOR REGISTRATION NO. 6343

CHECK LIST

NO. OF BEDROOMS
DIMENSIONS
BEARINGS
TIE TO NEAREST STREET
SUBLOT NO. PARCEL NO.
SURROUNDING OWNERS
BLDG. DIMENSIONS FIN GR.
BLDG. TIES FL.R. GRADES
APRON TYPE WIDTH THICKNESS
SIDEWALK TYPE WIDTH THICKNESS
CULVERT TYPE DIA. LENGTH
ROCK OUTCROPPINGS

WATER MAIN SIZE, LOCATION
SAN. SEWER SIZE & GR. LOC.
SAN. MH. CAST. ELEV. INV. ELEV.
SAN. CONN. SIZE, LOC. DEPTH
STORM SEWER SIZE & GR. LOC.
STORM MH. CAST. ELEV. INV. ELEV.
PAVT TYPE GRADE CURBS
GAS LINE LOC. SIZE PRESSURE
SEPTIC TANK LOCATION & DUPLICATION AREA
WELL LOCATION
ISOLATION RADIUS FROM WELL


NO.	DATE	BY
1		
2		
3		
4		
5		

PLAN PREPARED BY:
bj BABCOCK JONES & ASSOCIATES, INC.
PAINESVILLE, OHIO
DRAWN BY T.R. SCALE 1"=40' PHONE NO. 440-357-1811
CHK'D. H.J. DATE 3/31/99 DRAWING NO.
CREW CHIEF W.B. APP'D H.J. 99-064

"AS BUILT" CERTIFICATION
I, HEREBY CERTIFY THAT THE CIRCLED GRADES ARE EXISTING
FINISH GRADES CHECKED IN THE FIELD ON 3/31/99, 1999
AND ARE CORRECT TO THE BEST OF MY KNOWLEDGE AND BELIEF.

REGISTERED SURVEYOR REG. NO.

TBM-IRON PIN FOUND
ELEV.=100.00

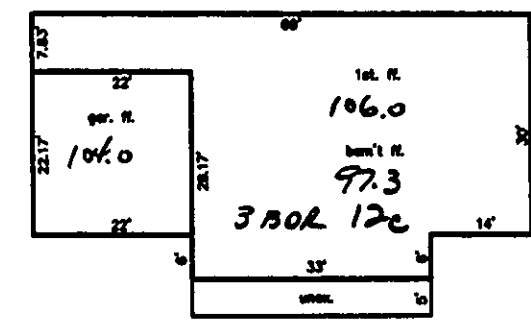

CHAPMAN ROAD
"I, the undersigned hereby certify that
this topographic map was prepared by 6", 1" or 2"
contours, and elevations shown hereon
represent an actual field survey made by
me on the 30th day of March, 1999
and that the elevations were taken at
appropriate intervals and that as of that
date they existed as indicated hereon."
Harry Jones #6343
Name Reg. No.

