


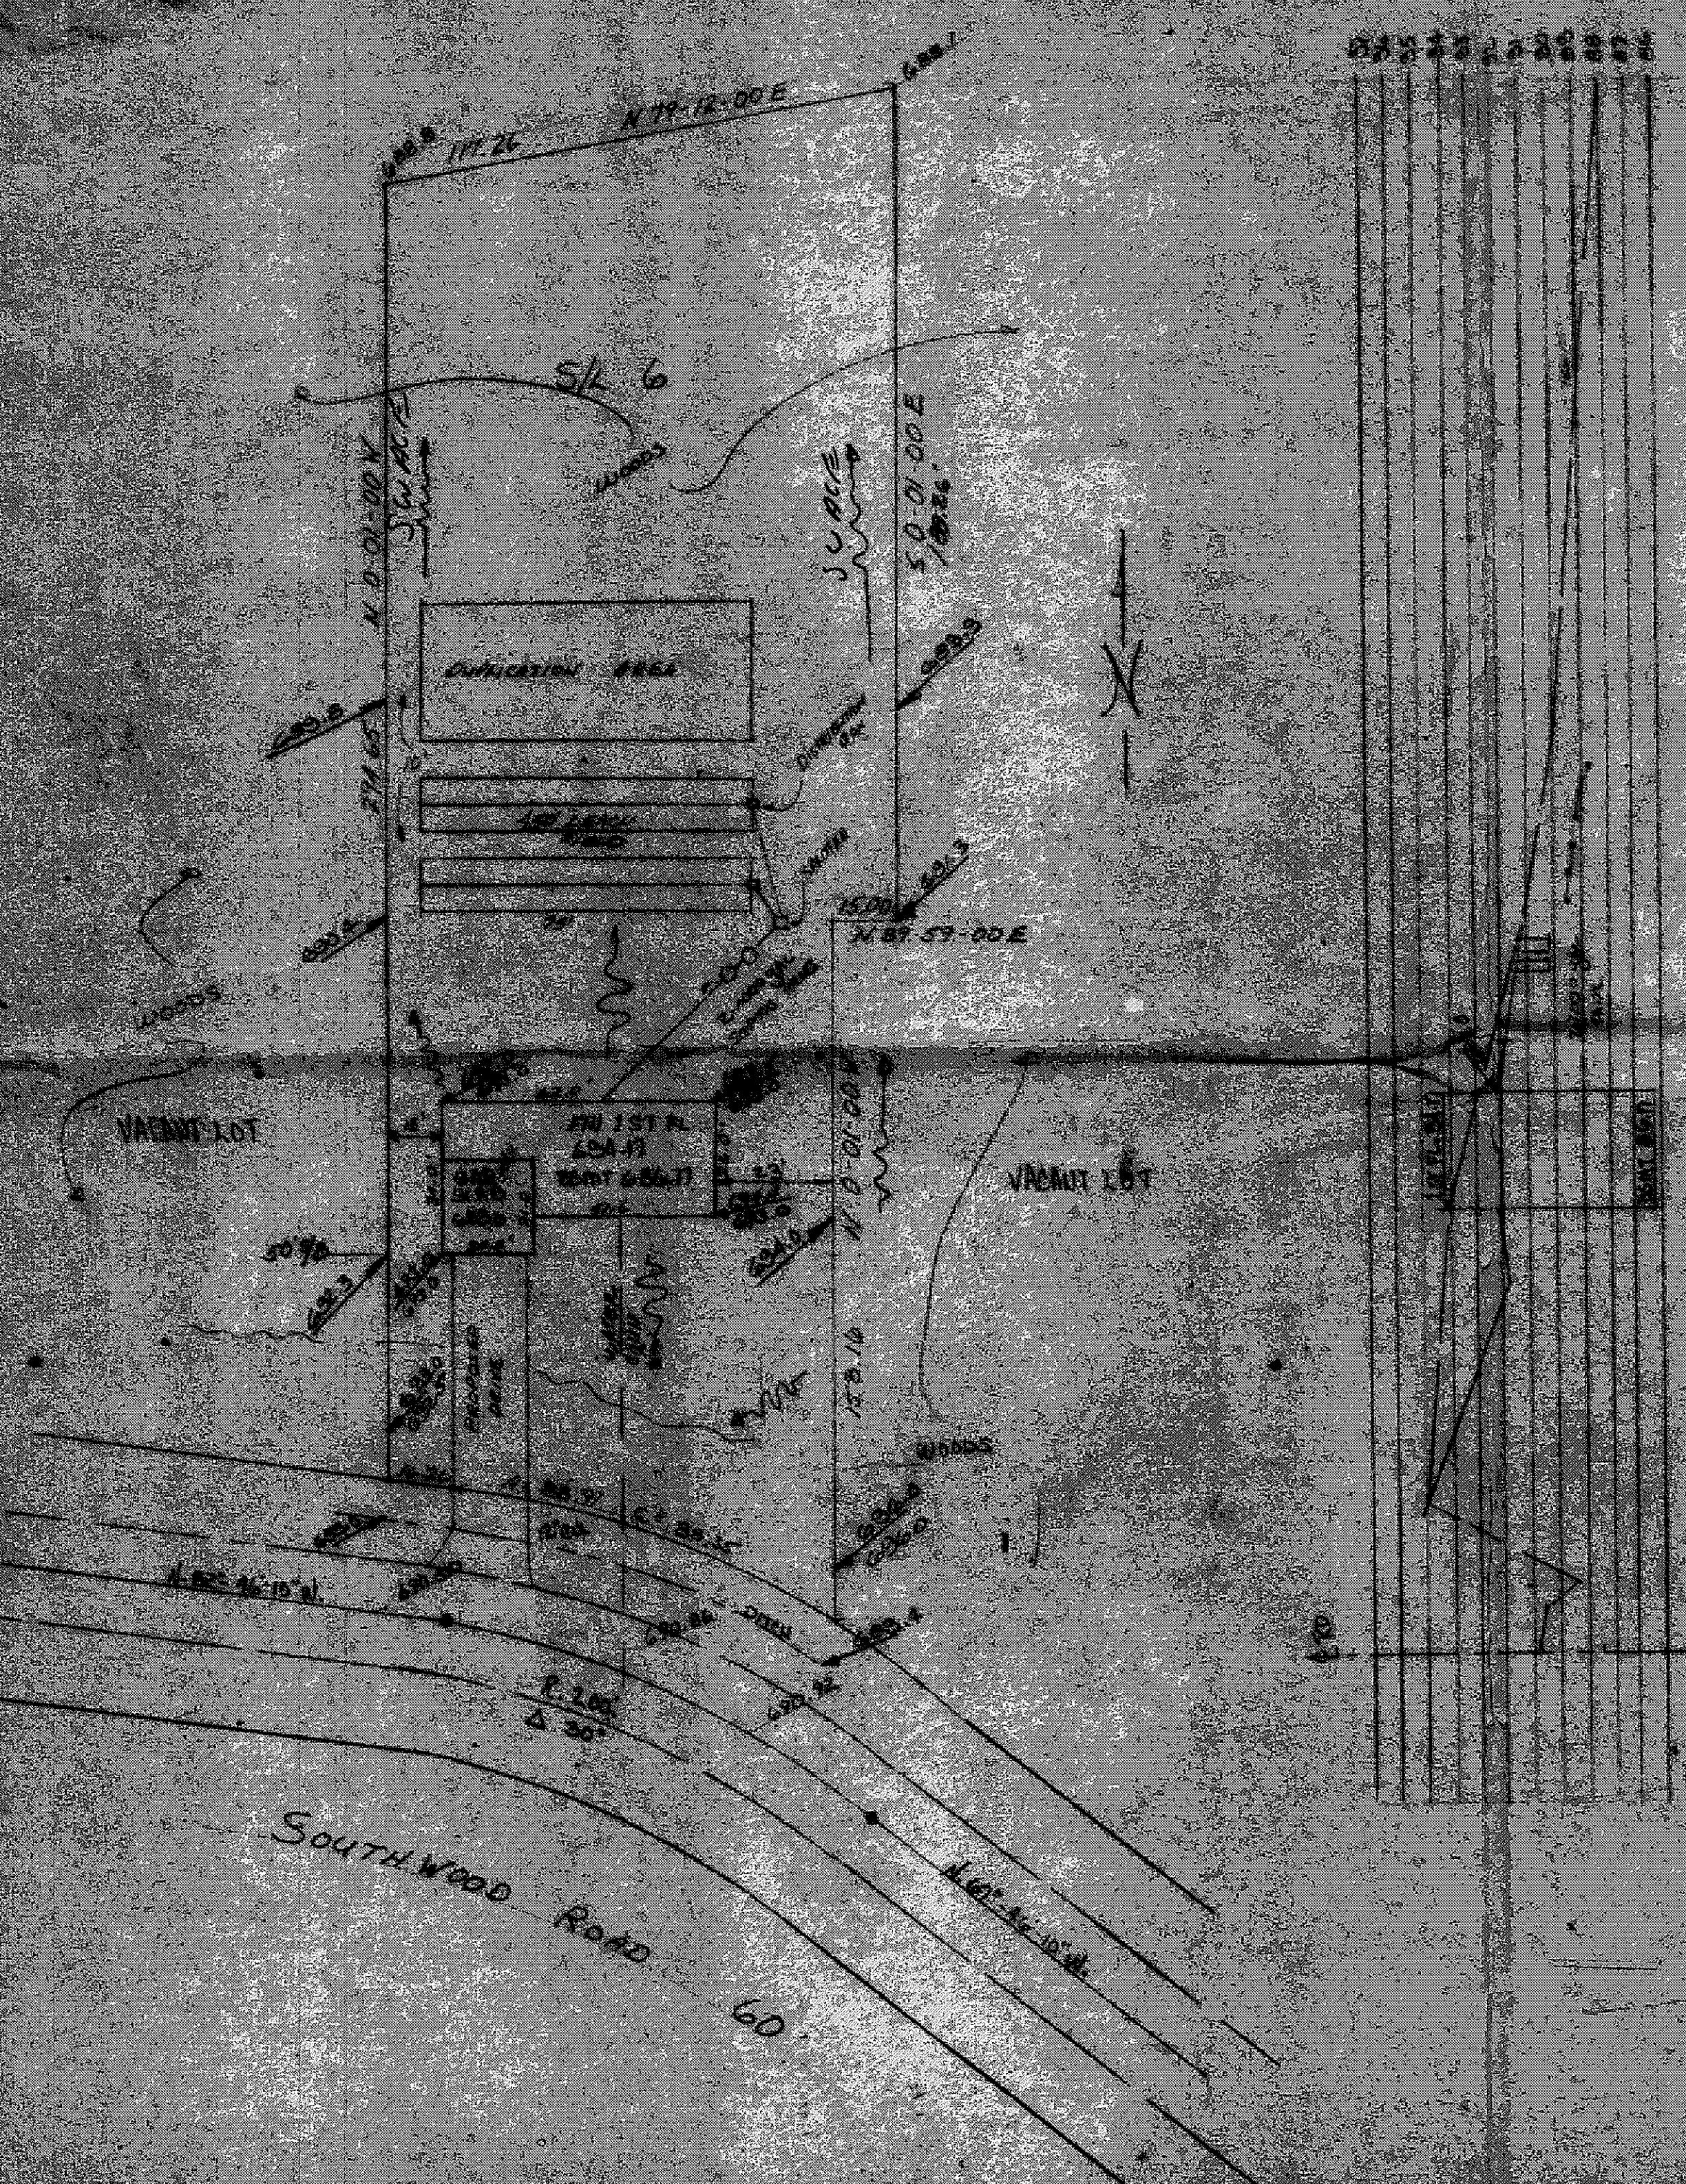

Grading Plan Approved
 as shown and/or noted
 THOMAS P. GILLES, P.E.
 Lake County Engineer
 By Joe Date 260/177

SITE PLAN

PERRY TOWNSHIP LAKE COUNTY,
FOR E.V. SLOAN
 CLIENT OWNER

ADDRESS	STREET	CITY
<u>SPRINGDALE</u>		
SUBDIVISION	NAME	LOT
<u>6</u>	<u>PG</u>	
SUBLOT NO.	STREET	PERM. PARCEL NO.

LEGEND	
SANITARY MANHOLE	WATER VALVE (GAS)
STORM MANHOLE	METER METER (GAS)
INLET OR CATCH BASIN	AS BUILT ELEVATION
HYDRANT	INDICATES DIRECTION OF SURFACE DRAIN
EXISTING CONTOURS	
PROPOSED CONTOURS	
EXIST ELEV.	100.0 - PROP ELEV

REMARKS
 ALL BOUNDARY DATA SHOWN WAS OBTAINED FROM (DEEDS, RE-
 SUBDIVISION PLAT OR OTHER PUBLIC RECORDS)
 LOCATIONS AS SHOWN OF ADJACENT WELLS AND SEPTIC TANKS
 FROM LAKE COUNTY HEALTH DEPARTMENT.

DESIGN CERTIFICATION
 THIS PLAN WAS PREPARED BY ME, AND IS CORRECT
 TO THE BEST OF MY KNOWLEDGE AND BELIEF.
Joe NAME Joe SURVEYOR 5-6-356 REGISTRATION

CHECK LIST	
NO. OF BEDROOMS	WATER MAIN SIZE, LOCATION
DIMENSIONS	SAN. SEWER SIZE 30, OR 12
BEARINGS	SAN. MAN. DIRT ELEV. INV.
TO NEAREST STREET	SAN. CORN. SIZE, LOC. DEP.
SEALOT NO. PARCEL NO.	STORM SEWER SIZE 30, OR
SURROUNDING OWNERS	STORM MAN. DIRT ELEV. INV.
BLDG. DIMENSIONS, VOL. OR	WATER MAIN TYPE, GRADES
CODE, PER. PER. GRADES	GAS LINE LOC. SIZE PRESS.
APPROX. TYPE, WIDTH, THICKNESS	SEPTIC TANK LOCATION, SIZE
SEWER TYPE, DIA. LENGTH	WELL LOCATION
ROCK OUTCROPPINGS	ISOLATION RADII FROM W.
OVERHANDS	

REVISIONS			PLAN PREPARED BY	
NO.	DATE	BY	<u>JOHN E. SKOJUSCZ</u>	
1				
2				
3			DRAWN BY	SCALE 1"=30'
4			OR'D.	DATE <u>Aug-77</u>
5			CHECKED	APP'D

"AS BUILT" CERTIFICATION
 I HEREBY CERTIFY THAT THE CIRCLED GRADES
 EXISTING FINISH GRADES CHECKED IN FIELD
 19 BY AND
 CORRECT TO THE BEST OF MY KNOWLEDGE AND BELIEF.
 REGISTERED SURVEYOR REG. NO.