

APPROVED  
SIDE LINES & SET BACK  
PERRY TOWNSHIP ZONING  
PERMIT NO.  
ZONING INSPECTOR

#### CODE INFORMATION

USE GROUP - F. FACTORY & INDUSTRIAL  
CONSTRUCTION TYPE - 20. NON-COMBUSTIBLE  
AREA - 3016 SQ. FT.  
INTERIOR FINISH  
EXITWAYS - CLASS II  
ALL OTHERS - CLASS III

#### INDEX

- A-1 SITE PLAN
- A-2 FLOOR PLAN/FOUNDATION PLAN
- A-3 SECTIONS & SCHEDULES
- A-4 ELEVATIONS

#### SITE PLAN



##### NOTES

- 1. REMOVE AND STOCK PILE TOPSOIL FROM BUILDING AND DRIVE AREAS.
- 2. GENERAL CONTRACTOR TO ESTABLISH BUILDING LINES AND GRADES. ALL WALKS, DRIVES & PAVED AREAS SHALL BE STAKED AND APPROVED BY ARCHITECT BEFORE CONSTRUCTION.
- 3. SEE ARCHITECTURAL DRAWINGS FOR BUILDING DIMENSIONS. DIMENSIONS GIVEN TO OUTSIDE OF FOUNDATION WALLS UNLESS OTHERWISE NOTED.
- 4. REMOVE ALL EXCESS EARTH & BUILDING DEBRIS FROM SITE AFTER FINAL GRADING.
- 5. SPREAD TOP SOIL OVER ENTIRE AREA DISTURBED BY CONSTRUCTION.
- 6. FINAL GRADING TO BE PERFORMED SO THAT ALL SURFACE WATER DRAINING AWAY FROM BUILDING AREA.

BENCH MARK AT INTERSECTION OF  
SHEPARD RD. AND ACCESS DRIVE - 696.9

Grading Plan Approved  
as shown and/or noted  
THOMAS P. GILLES, P.E.  
Lake County Engineer  
Date 11-5-81

Oct 30, 1981  
APPROVED  
SIDE LINES & SET BACK  
PERRY TOWNSHIP ZONING  
PERMIT NO. 2541  
ZONING INSPECTOR  
R.W. Patterson

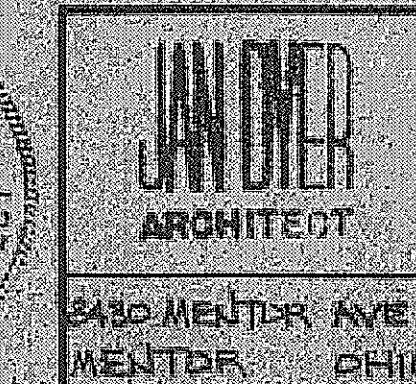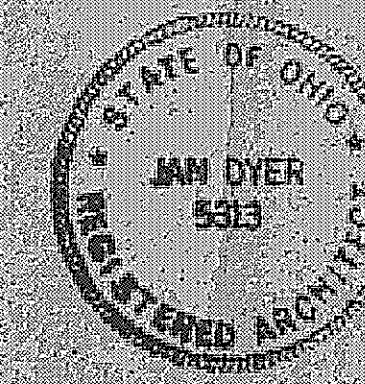

|                         |                 |
|-------------------------|-----------------|
| NEW LABORATORY BUILDING |                 |
| SHEPARD RD.             |                 |
| PERRY                   |                 |
| SCALE: 1" = 50'         | APPROVED BY     |
| DATE                    | DRAWN BY J.D.F. |
| CALHID CHEMICALS, INC.  |                 |
| PERRY, OHIO             |                 |
| 5430 MENTOR AVE.        | DRAWING NUMBER  |
| MENTOR, OHIO            | A-1 4           |
| SITE PLAN               |                 |

