

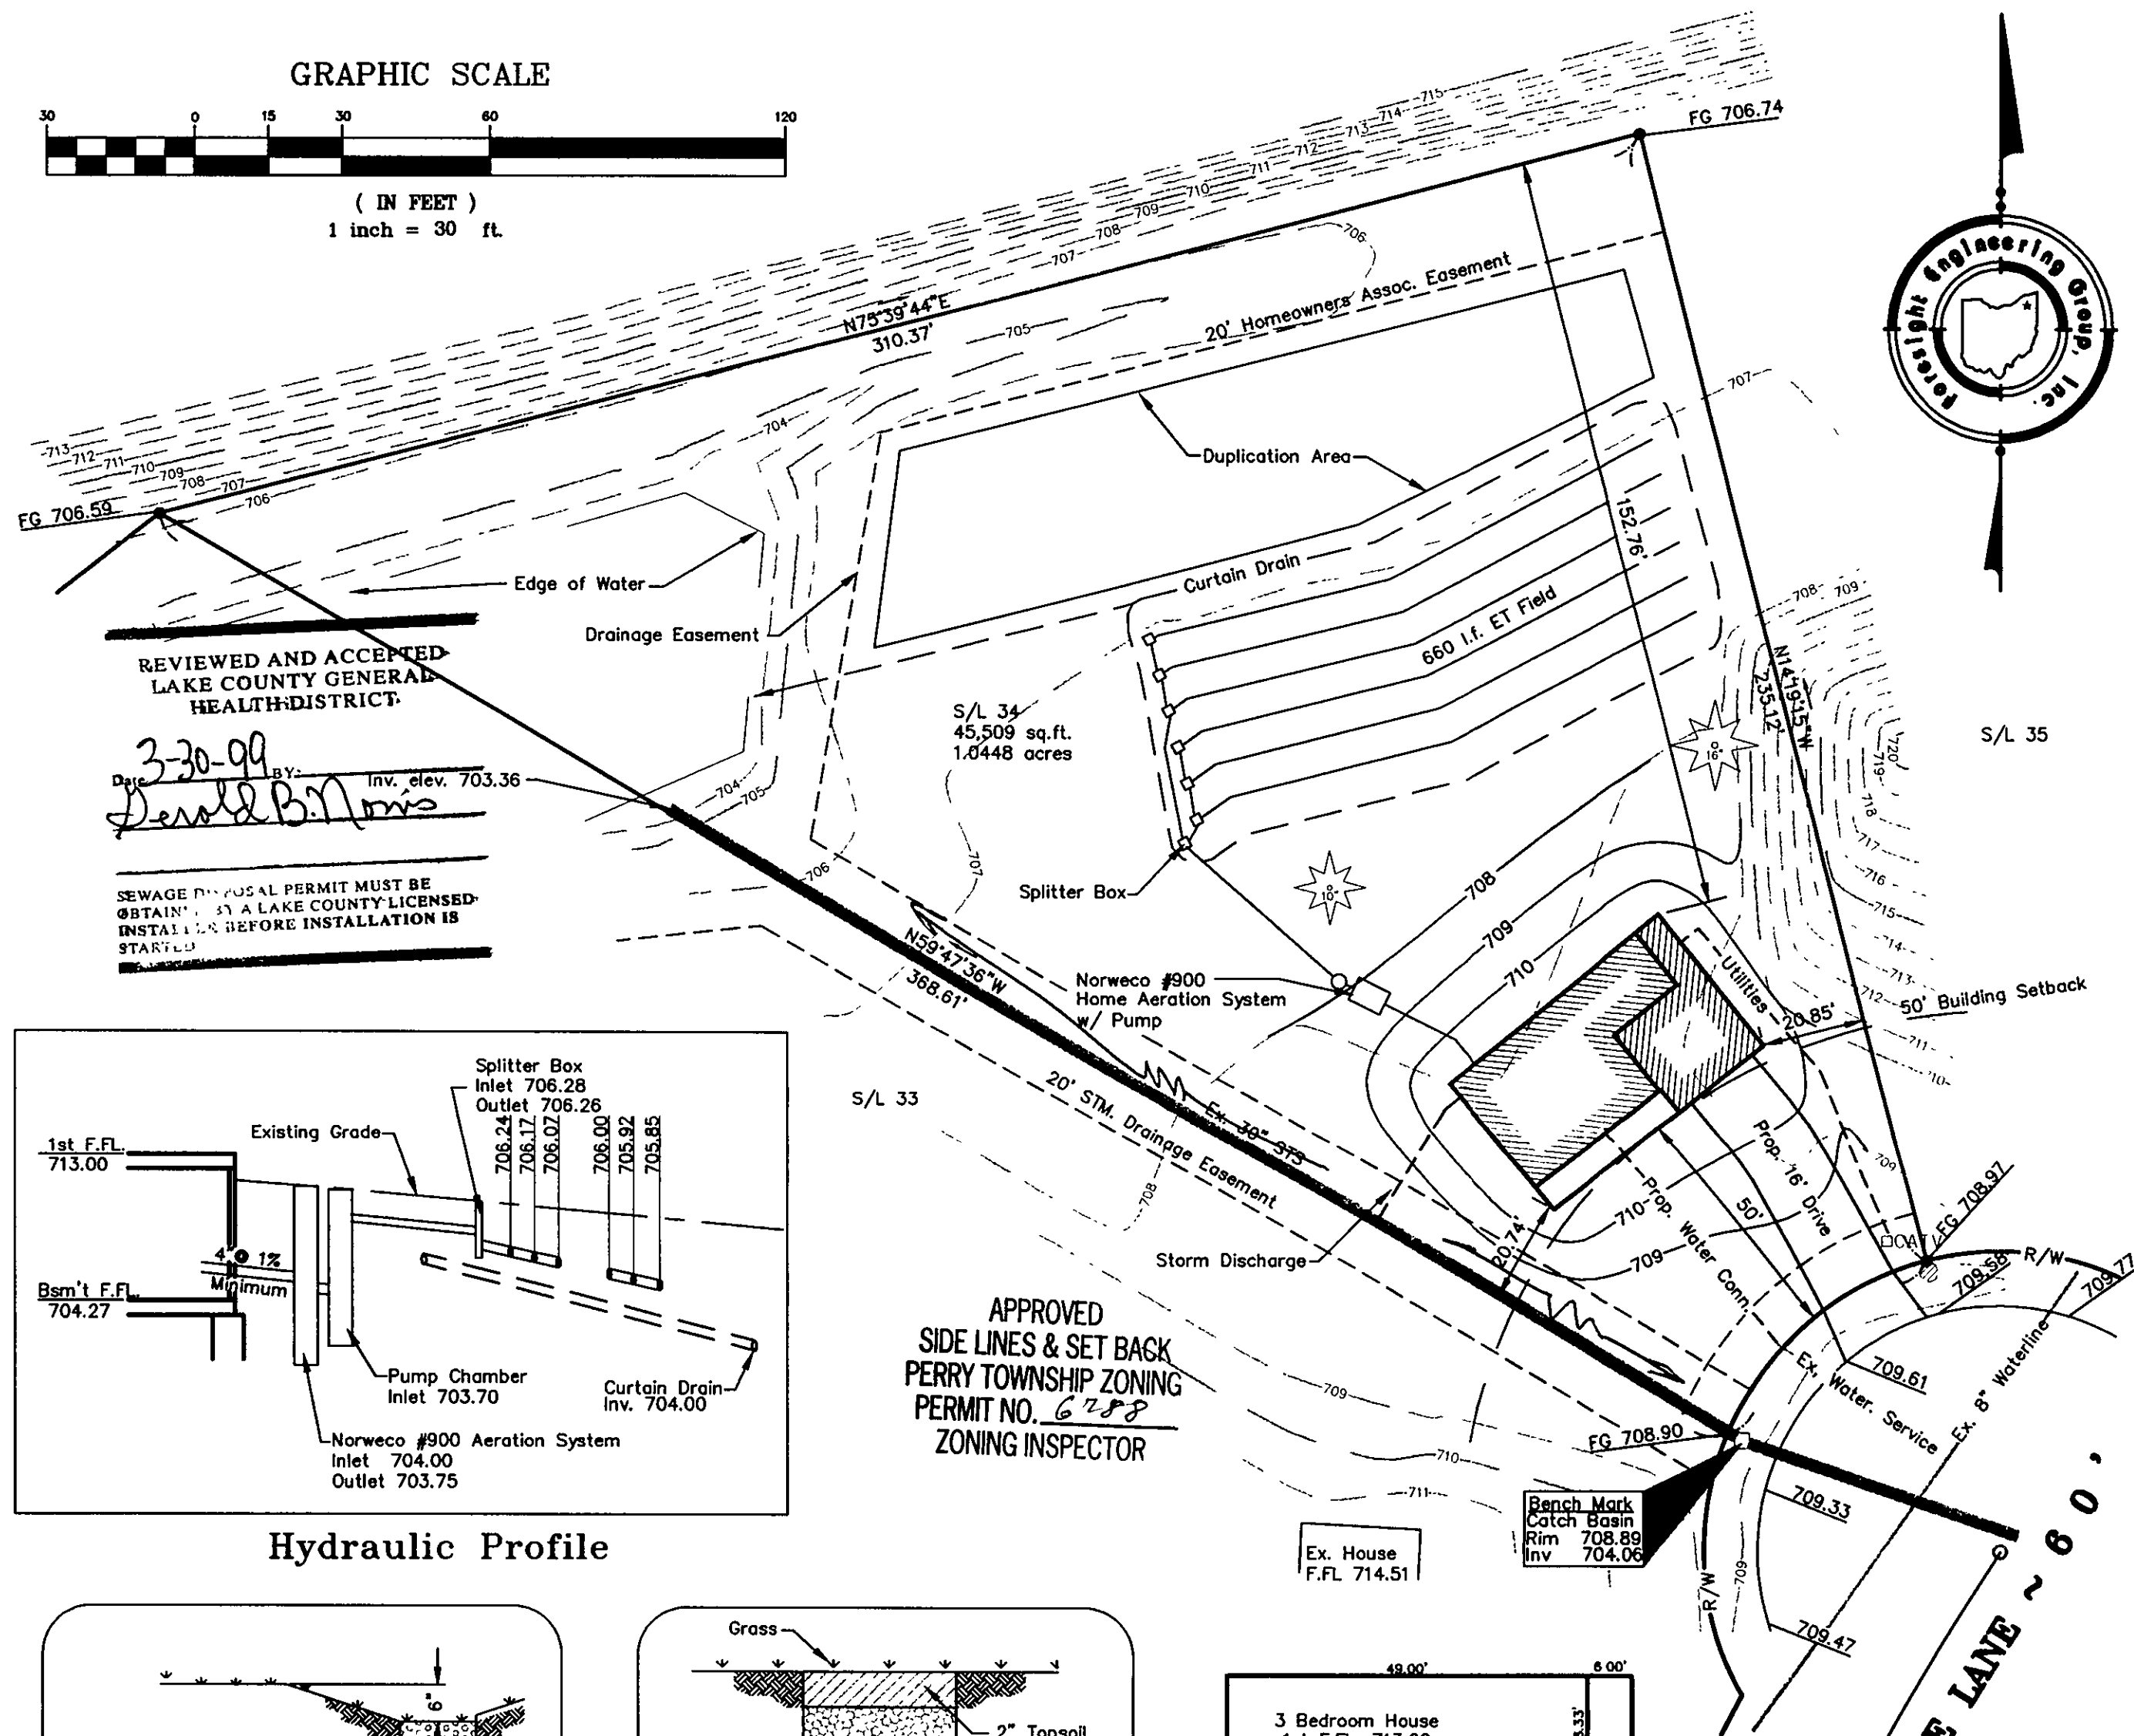


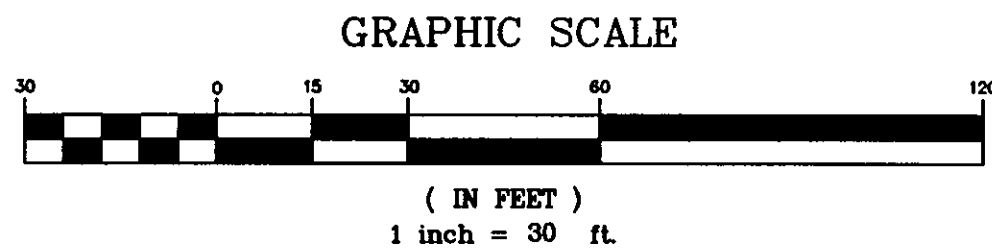




REVIEWED AND ACCEPTED  
LAKE COUNTY GENERAL  
HEALTH DISTRICT

Date 3-30-99 BY: Derek B. Nims  
Inv. elev. 703.36

SEWAGE DISPOSAL PERMIT MUST BE  
OBTAINED FROM LAKE COUNTY LICENSED  
INSTALLER BEFORE INSTALLATION IS  
STARTED

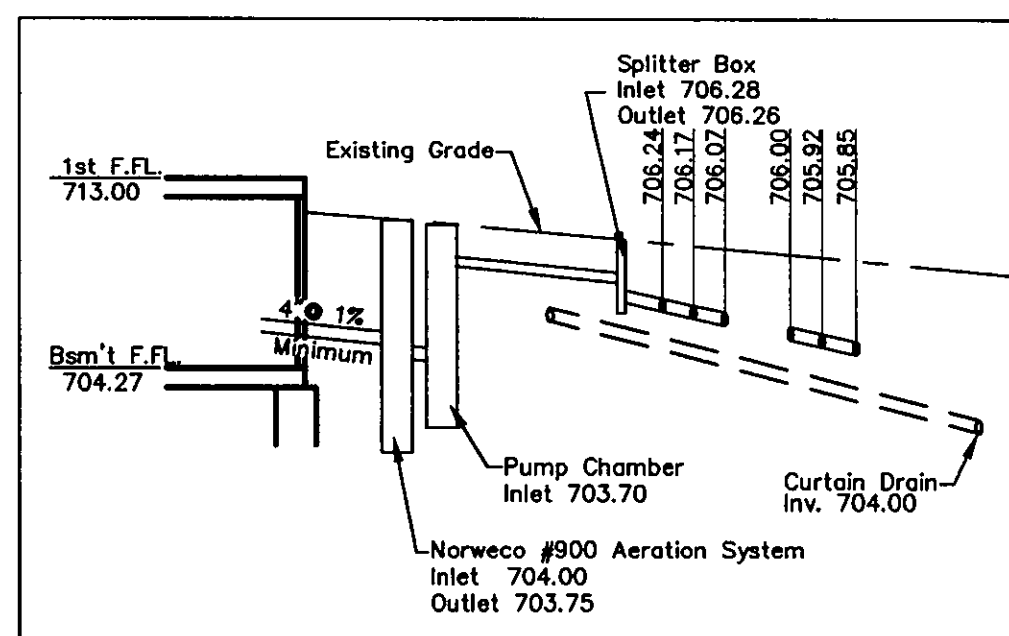

Hydraulic Profile

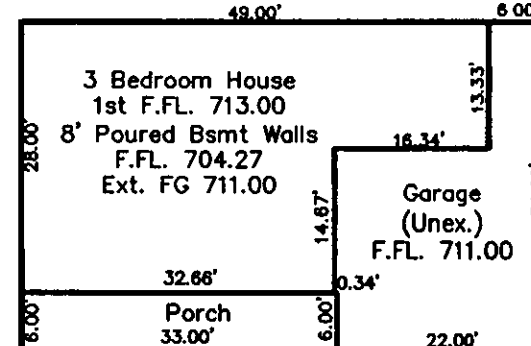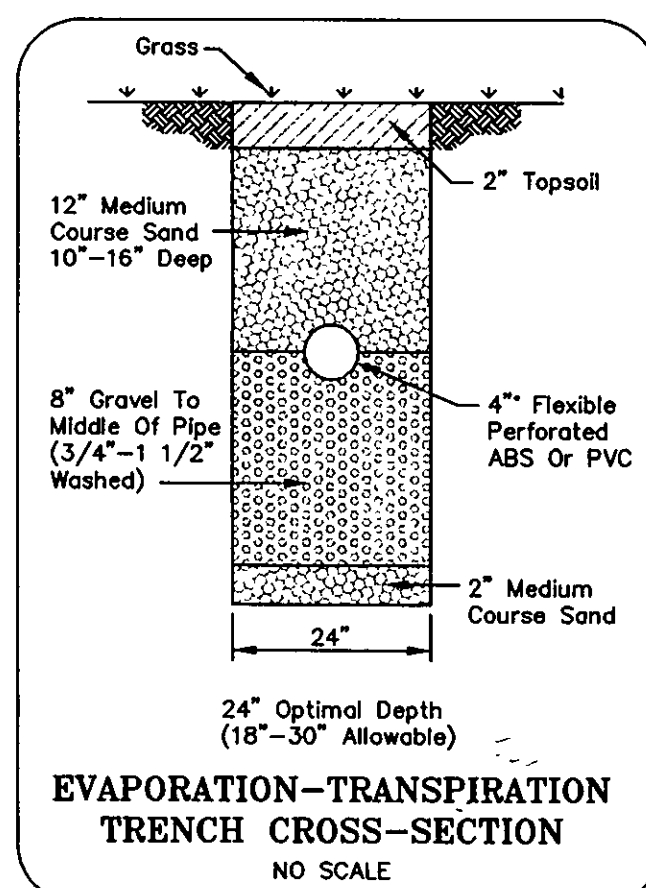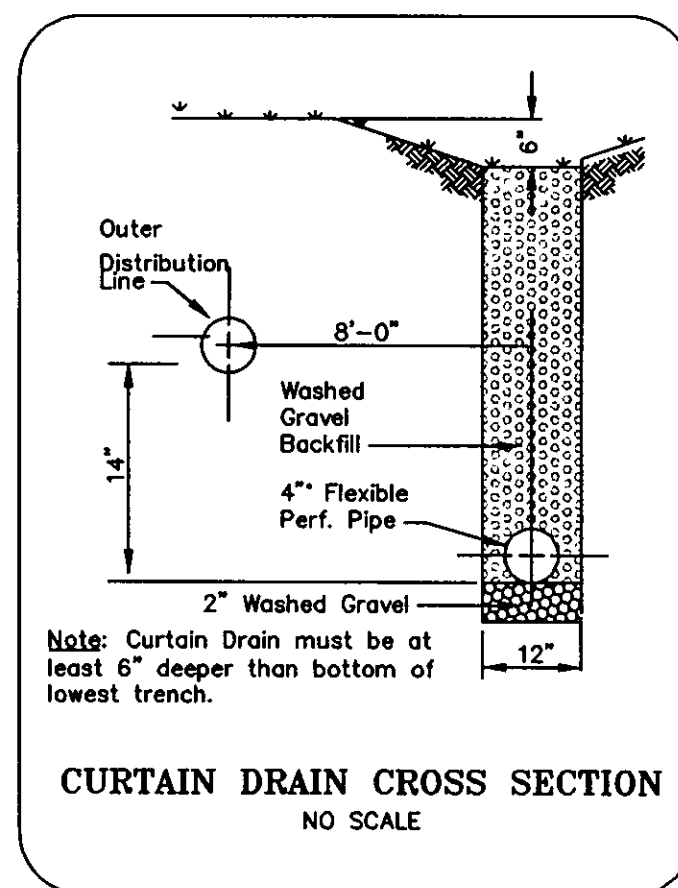

| SYMBOL LEGEND |                                |
|---------------|--------------------------------|
|               | Iron Pin Set                   |
|               | Catch Basin                    |
|               | Electrical Box                 |
|               | Fire Hydrant                   |
|               | Water Shut Off Valve (Service) |
|               | Drainage Flow                  |
|               | Monument Box with Iron Pin     |

Zoning District ~ ER-1  
Front Setback 50'  
Side Setback 15'  
Rear Setback 15'  
Grading Plan Approved  
as shown and/or noted  
THOMAS P. GILLES, P.E.  
Lake County Engineer

## SITE PLAN

for : McCullough Builders and Developers  
CLIENT  
P.O. Box 349 Perry Ohio 44081  
ADDRESS CITY STATE ZIP

34 South Perry Pines  
SUBLOT No. SUBDIVISION NAME VOL. PAGE  
Perry Ohio  
LOT TRACT CITY STATE

**Foresight Engineering Group**  
**Engineers & Surveyors**  
440 286-1010  
440 286-1034 fax  
320 Center Street, Unit F  
Chardon, Ohio 44024


## DESIGN CERTIFICATION

This Site Plan was prepared by Foresight Engineering Group, Inc.,  
and is correct to the best of my knowledge and belief.

John A. Roman  
NAME

## CHECK LIST

LOT DIMENSIONS & BEARINGS  
TIE TO NEAREST STREET  
SUBLOT No. (PARCEL No.)  
SURROUNDING OWNERS  
BUILDING DIMENSIONS  
SETBACK, SIDEYARD, REARYARD  
FINISH GRADES  
DRIVE & APRON TYPE, WIDTH, THICKNESS  
SIDEWALK TYPE, WIDTH, THICKNESS  
CULVERT TYPE, DIAM., LENGTH  
WATER MAIN SIZE, LOCATION  
SAN. SEWER SIZE, % GRADE, LOC.  
SAN. MH. CAST. ELEV., INV. ELEV.  
SAN. CONN. SIZE, % GRADE, LOC.  
STORM SEWER SIZE, % GRADE, LOC.  
STORM MH. CAST. ELEV., INV. ELEV.  
PAV'T TYPE, GRADE, CURBS  
GAS LINE LOC., SIZE  
SEPTIC SYSTEM & DUPLICATION  
WELL LOCATION & ISOLATION RADIUS

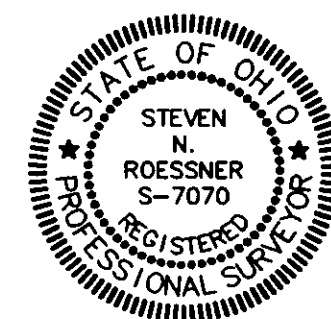

STATE SEAL

## "AS BUILT" CERTIFICATION

I hereby certify that the circled information is existing as  
obtained on the site \_\_\_\_\_ 19\_\_ and is  
correct to the best of my knowledge and belief.

NAME

SCALE : 1" = 30'


FILE NAME:  
I:\MCC1\SL24

DATE : March 23, 1999

BENCHMARK: Ex. STS CB Rim elev. = 708.89

"I, the undersigned hereby certify that this topography, indicated by 6", 1" or 2"  
contours, and the elevations shown hereon represent an actual field survey made  
by Foresight Engineering Group, Inc. on the 17th day of February,  
19\_\_99 and that the elevations were taken at appropriate intervals and  
that as of that date they existed as indicated hereon."

John A. Roman  
NAME

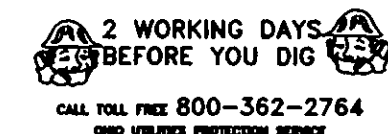

## EXISTING UNDERGROUND UTILITIES NOTES:

The location both horizontal and vertical of the underground utilities  
shown hereon, have been obtained by a diligent and comprehensive  
search of available records. Verification by field observation, has been  
conducted where practical. However, Foresight Engineering Group, Inc.  
does not guarantee the completeness nor accuracy thereof.