
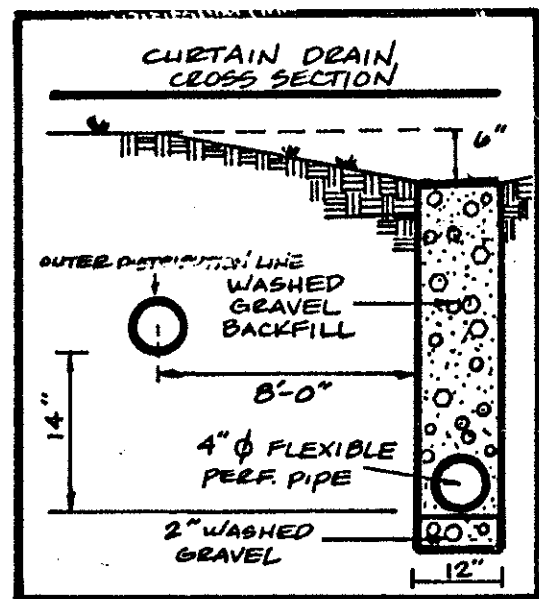


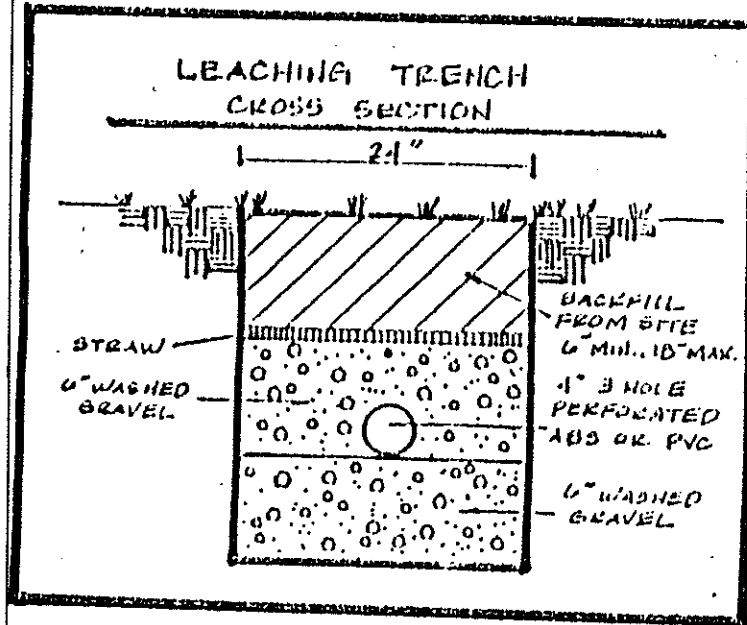


REVIEWED AND ACCEPTED
LAKE COUNTY GENERAL
HEALTH DISTRICT

Date: 8/23/97 BY: Dan Lal

SEWAGE DISPOSAL PERMIT MUST BE
OBTAINED BY A LAKE COUNTY LICENSED
INSTALLER BEFORE INSTALLATION IS
STARTED.

Grading Plan Approved
as shown and/or noted
THOMAS P. GILLES, P.E.
Lake County Engineer

By: L.H. Date: 9.17.97

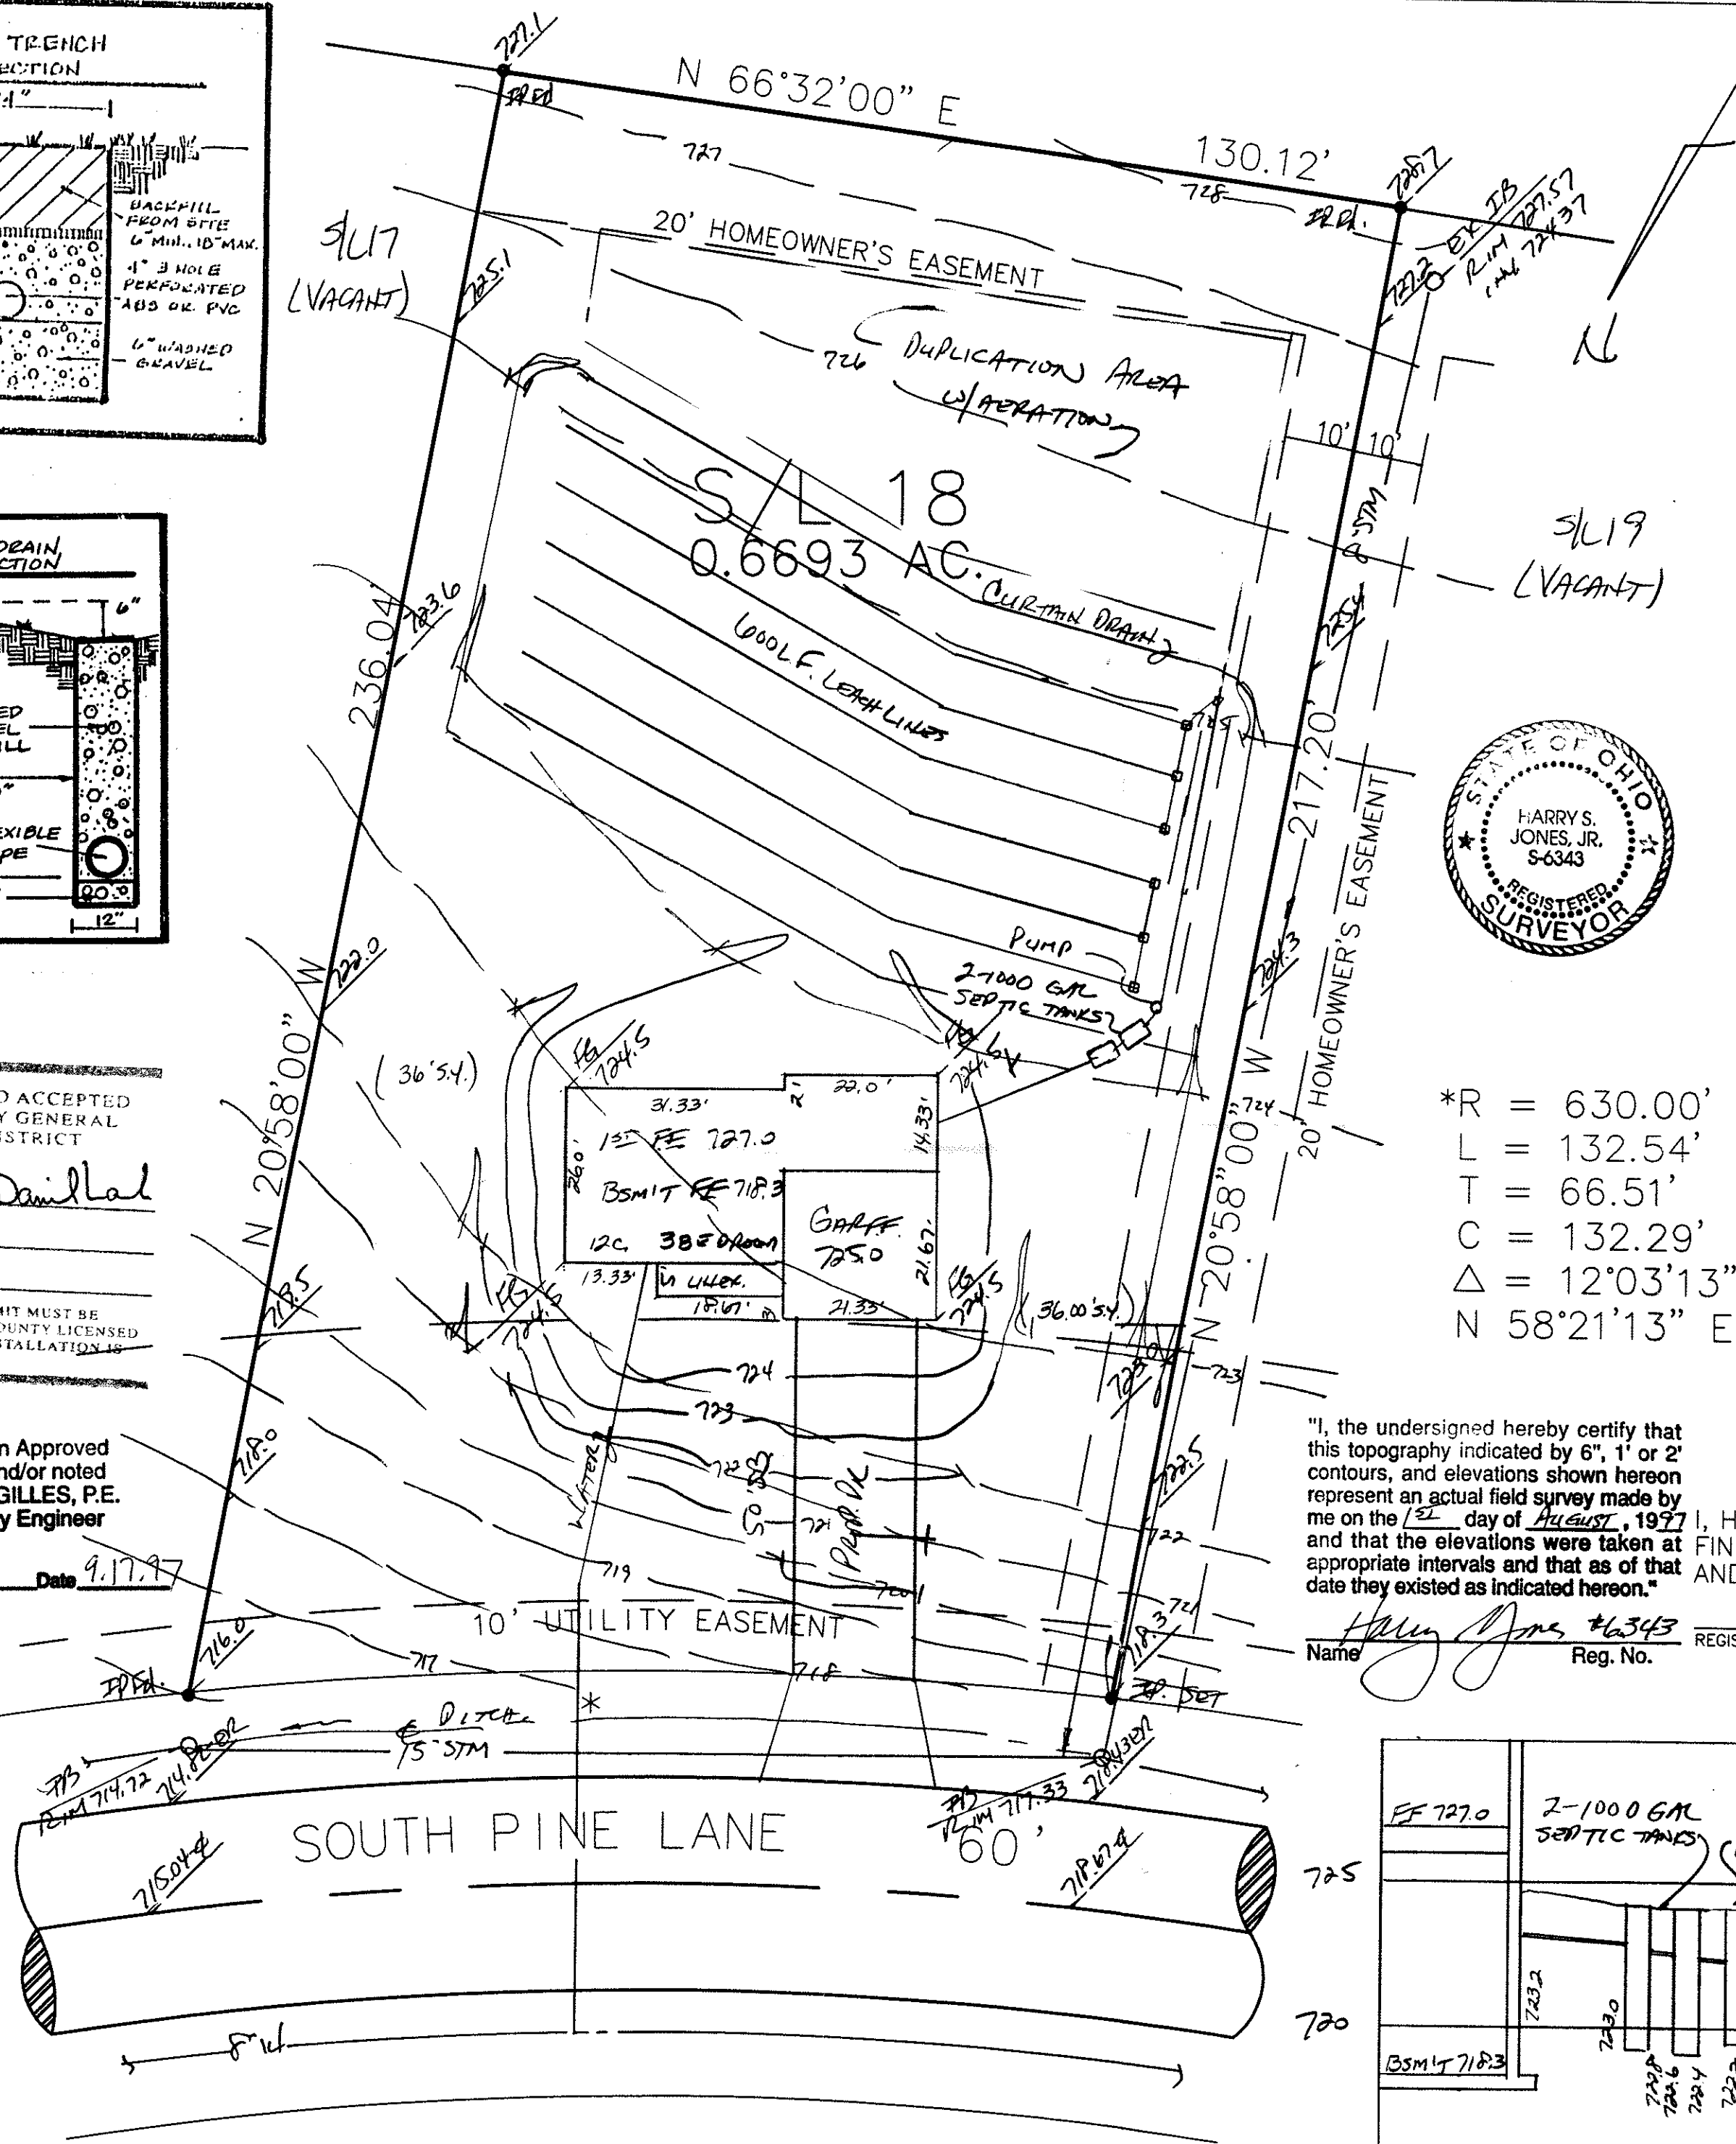

$$\begin{aligned} *R &= 630.00' \\ L &= 132.54' \\ T &= 66.51' \\ C &= 132.29' \\ \Delta &= 12^{\circ}03'13'' \\ N &58^{\circ}21'13'' E \end{aligned}$$


"I, the undersigned hereby certify that this topography indicated by 6", 1" or 2" contours, and elevations shown hereon represent an actual field survey made by me on the 12th day of August, 1997 and that the elevations were taken at appropriate intervals and that as of that date they existed as indicated hereon."

Name: Harry S. Jones, Jr. Reg. No. 6343

"AS BUILT" CERTIFICATION
I, HEREBY CERTIFY THAT THE CIRCLED GRADES ARE EXISTING
FINISH GRADES CHECKED IN THE FIELD ON 8/4/97
AND ARE CORRECT TO THE BEST OF MY KNOWLEDGE AND BELIEF.

PLAN PREPARED BY: BABCOCK JONES & ASSOCIATES, INC.
PAINESVILLE, OHIO
DRAWN BY: M.S. SCALE: 1"=20' PHONE NO. 216-357-1811
CHK'D: DATE: 8/4/97 DRAWING NO. 97-183-18
CREW CHIEF: W.B. APP'D: HT

75 M - NAIL FOUND IN TREE - SL 26 - ELEV. = 719.00

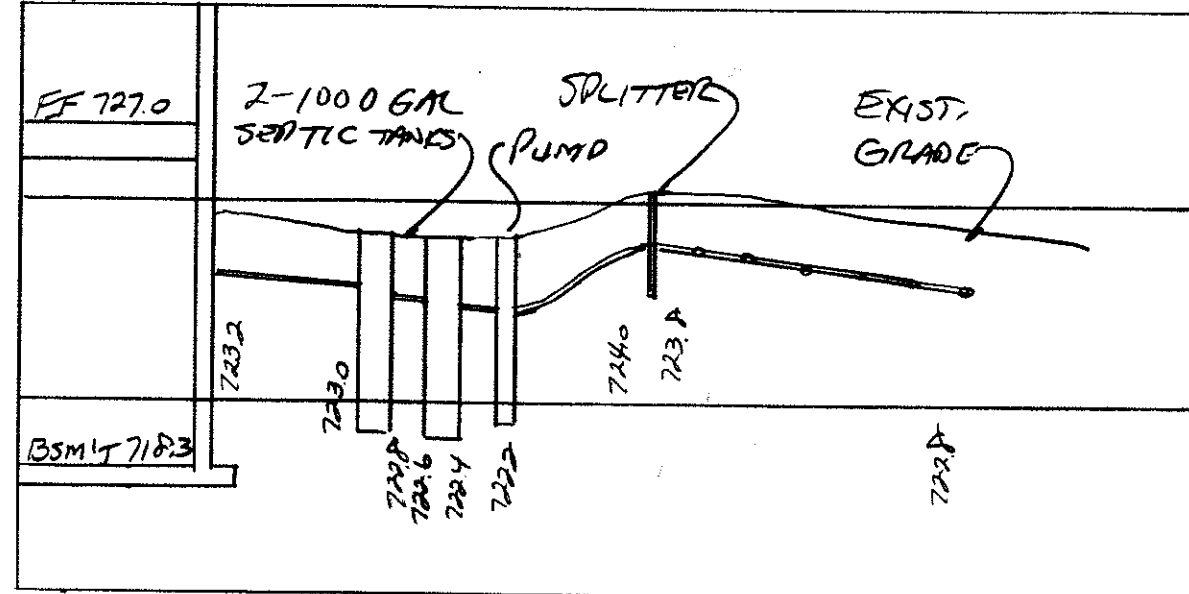

HYDRAULIC PROFILE
HORIZ: 1"=20' VERT: 1"=5'

SITE PLAN

PERRY TWP., LAKE COUNTY, OHIO

for: WILSHIRE HOMES

ADDRESS STREET CITY ZIP

SOUTH PERRY PINES SUB.
SUBDIVISION 28-20 NAME LOT TRACT
18 SOUTH PINE LANE VOLUME PAGE
SUBLOT NO. STREET PERM. PARCEL NO. STREET

LEGEND

SANITARY MANHOLE --- 100.0
STORM MANHOLE --- 100.0
INLET OR CATCH BASIN --- 100.0
HYDRANT --- 100.0
EXISTING CONTOURS --- 100.0
PROPOSED CONTOURS --- 100.0
EXIST. ELEV. --- 100.0
AS BUILT ELEVATION
INDICATES DIRECTION OF SURFACE DRAINAGE

REMARKS

ALL BOUNDARY DATA SHOWN WAS OBTAINED FROM (DEEDS, RECORDED
SUBDIVISION PLAT OR OTHER PUBLIC RECORDS)
LOCATIONS AS SHOWN OF ADJACENT WELLS AND SEPTIC TANKS OBTAINED FROM
LAKE COUNTY HEALTH DEPARTMENT

DESIGN CERTIFICATION

THIS PLAT WAS PREPARED BY ME, AND IS CORRECT
TO THE BEST OF MY KNOWLEDGE AND BELIEF.

Name: Harry S. Jones, Jr. REGISTRATION NO. 6343

CHECK LIST

NO. OF BEDROOMS
DIMENSIONS
BEARINGS
TIE TO NEAREST STREET
SUBLOT NO. PARCEL NO.
SURROUNDING OWNERS
BLDG. DIMENSIONS FIN GR.
BLDG. TIES FL/R. GRADES
APRON TYPE WIDTH THICKNESS
SIDEWALK TYPE WIDTH THICKNESS
CULVERT TYPE DIA., LENGTH
ROCK OUTCROPPINGS
WATER MAIN SIZE, LOCATION
SAN. SEWER SIZE % GR. LOC.
SAN. MH. CAST. ELEV. INV. ELEV.
SAN. CONN. SIZE, LOC. DEPTH
STORM SEWER SIZE % GR. LOC.
STORM MH. CAST. ELEV. INV. ELEV.
PAV'T TYPE GRADE CURBS
GAS LINE LOC. SIZE PRESSURE
SEPTIC TANK LOCATION & DUPLICATION AREA
WELL LOCATION
ISOLATION RADIUS FROM WELL

REVISIONS

NO.	DATE	BY
1	8/6/97	HT
2	8/24/97	HT
3	8/28/97	HT
4		
5		