
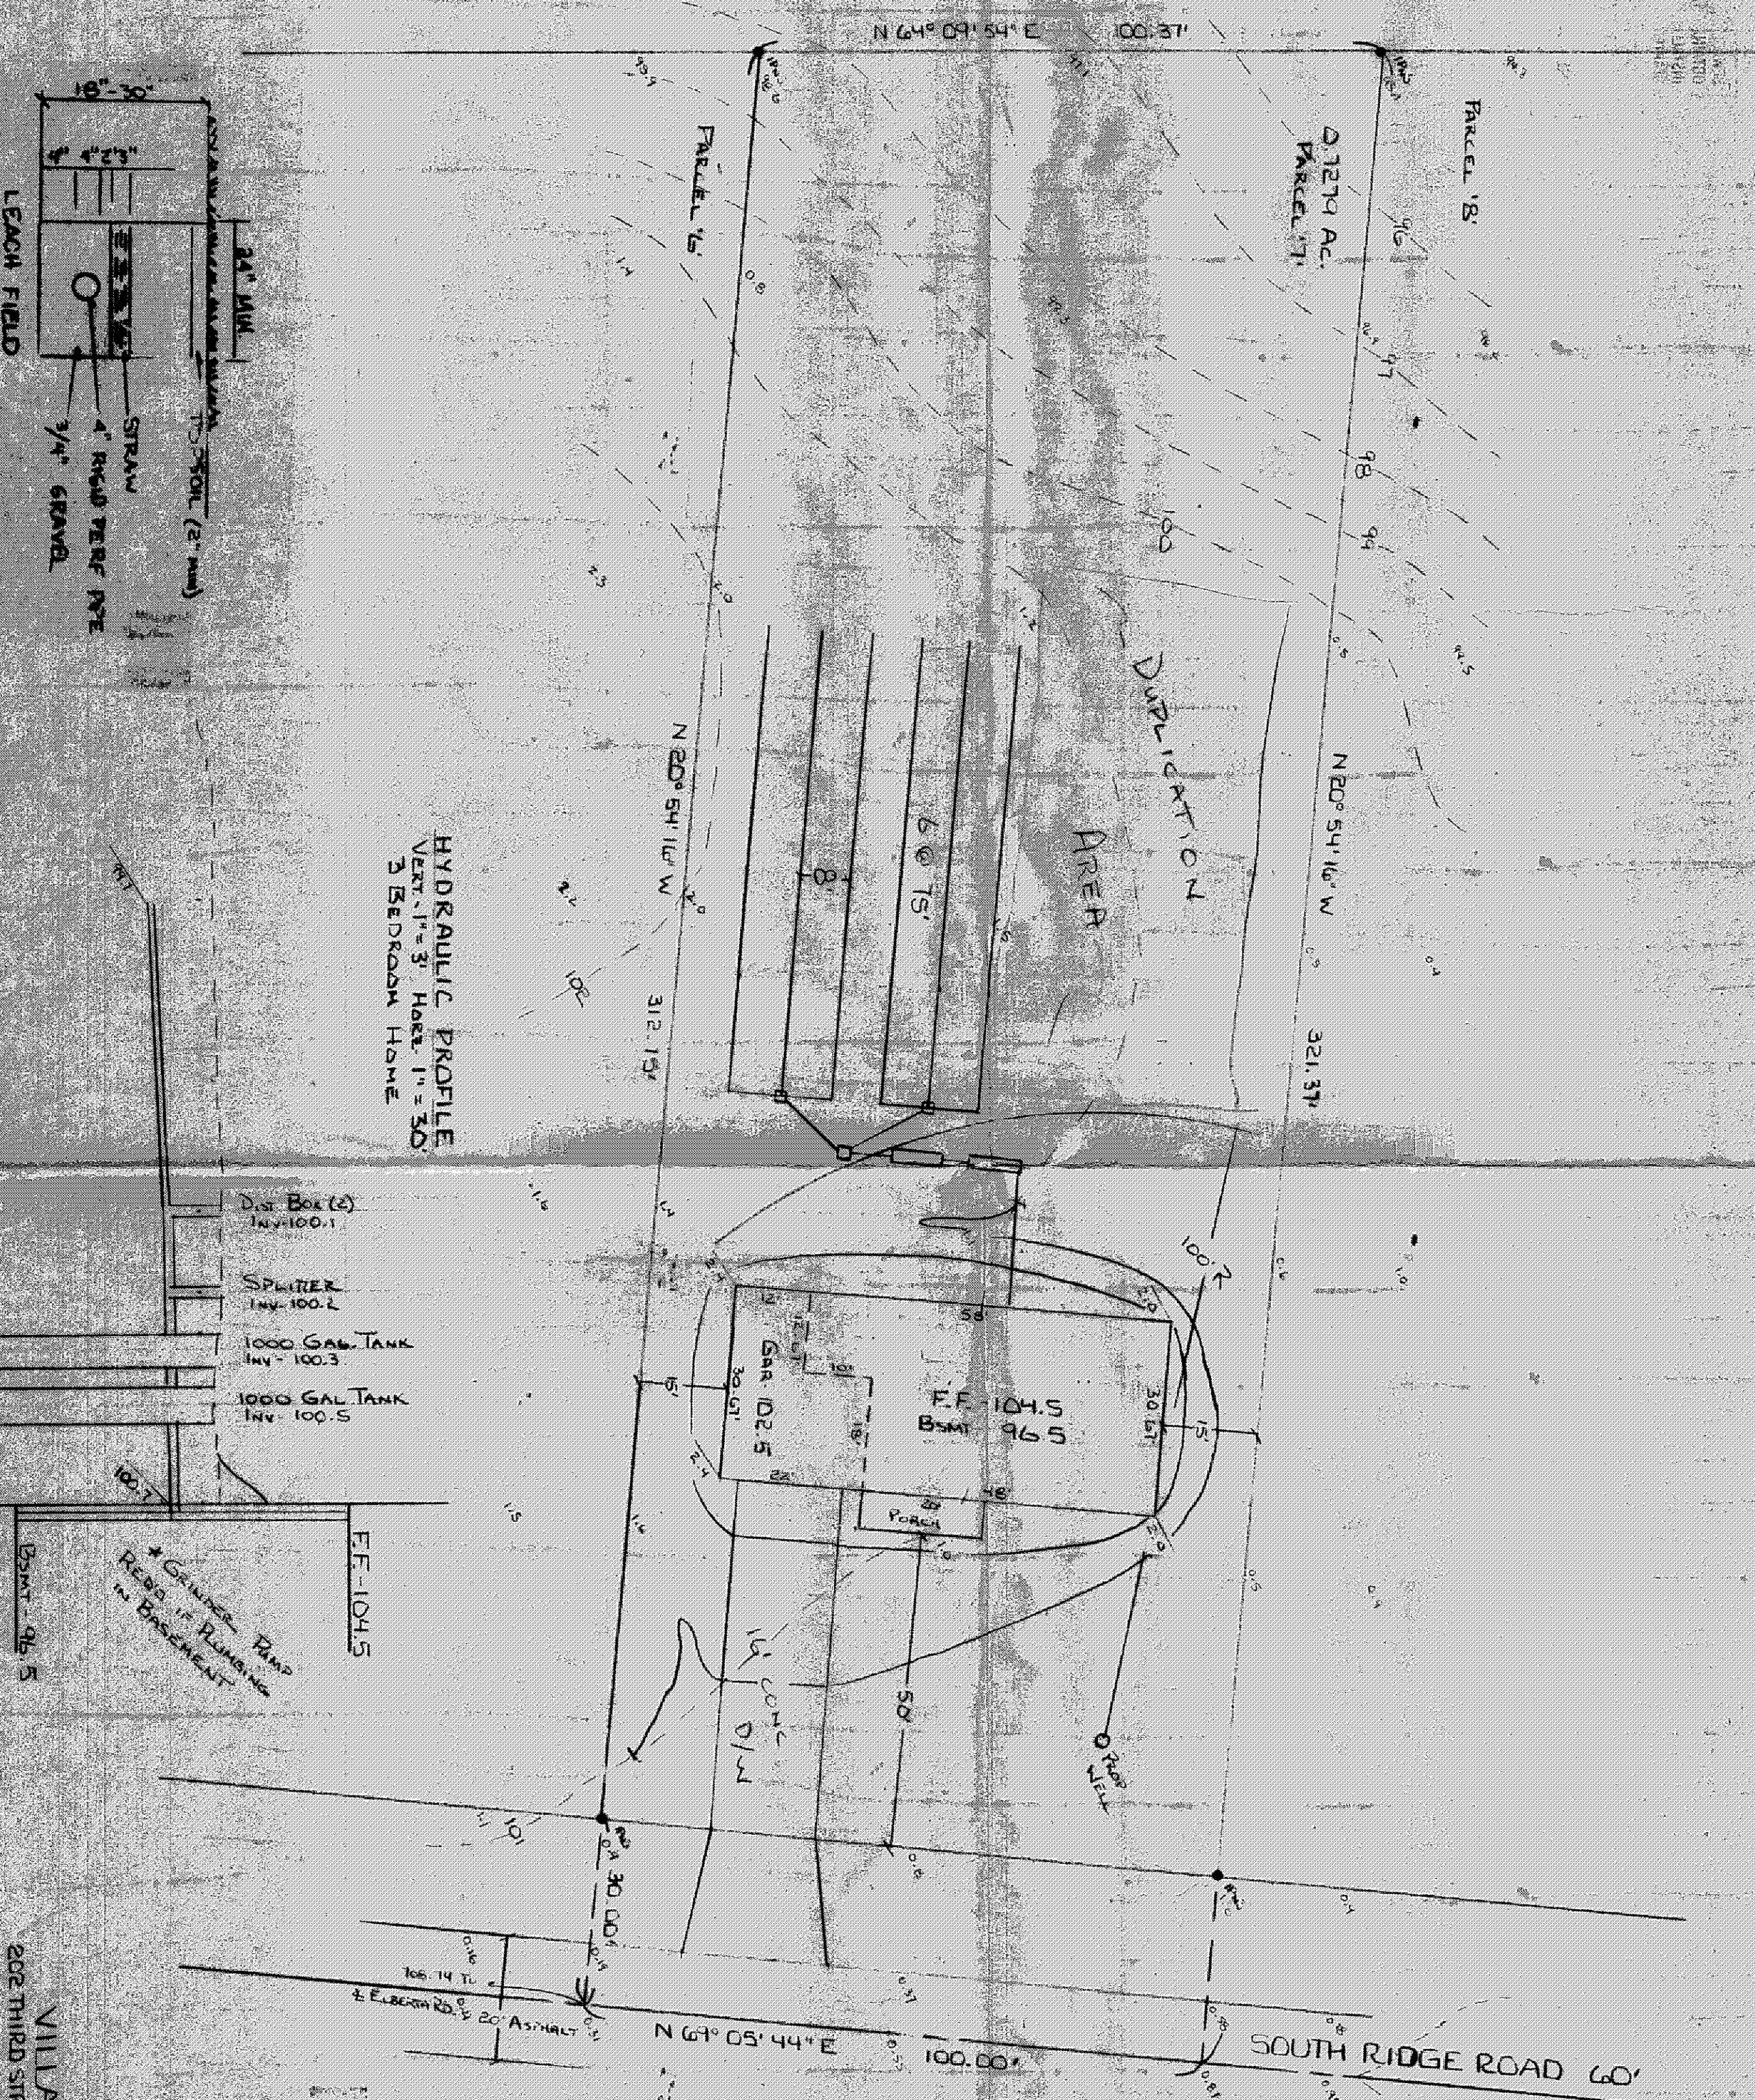


ANGELORO CONST. CO.

BEING PARCEL 7 OF COLLINS SPALT,
SOUTH RIDGE RD. IN THE TOWNSHIP
OF PERRY, COUNTY OF LAKE, STATE
OF OHIO.

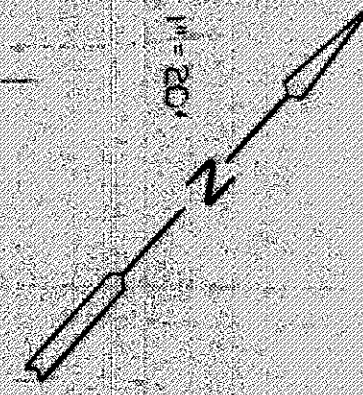


HYDRAULIC PROFILE
VERT. 1" = 3' HORIZ. 1" = 30'
3 BEDROOM HOME

Dist. Box (2)
Inv. 100.1
SPLITTER
Inv. 100.2
1000 GAL. TANK
Inv. 100.3
1000 GAL. TANK
Inv. 100.5

Gravel Ramp
Rego. if Running
in Basement

Reviewed and Accepted
LAKE COUNTY GENERAL HEALTH DISTRICT
Date: 6/10/92
By: J. L. Lucas, R.S., M.P.H. Health Commissioner

APPROVED
SIDE LINES & SET BACK
PERRY TOWNSHIP ZONING
PERMIT NO. 4632
ZONING INSPECTOR *John R. ...*

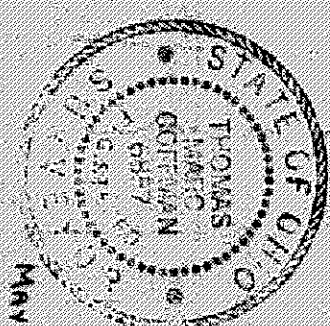

By: *[Signature]*
Date: 6/15/92
Grading Plan Approved
T. J. CASP, P.E.
Lake County Engineer

SEWAGE DISPOSAL PERMIT MUST BE
OBTAINED BY A LAKE COUNTY LICENSED
INSTALLER BEFORE INSTALLATION IS
STARTED.

LOW YIELD WALLER
FIXTURES REQUIRED
ON ALL:
Shower Head
Toilet

- A. To be brought to finished grade
- 1. Septic tank manhole covers
- 2. Splitter box cover
- 3. Distribution box cover
- B. No footer drains or downspouts
to be discharged into septic tanks
- C. All waste water to be discharged into
septic tanks