


SITE PLAN
FOR

ANGELOLO CONSTRUCTION



BEING A PART OF LOTS 43, 53
IN THE TOWNSHIP OF PERRY,
COUNTY OF LAKE, STATE OF OHIO

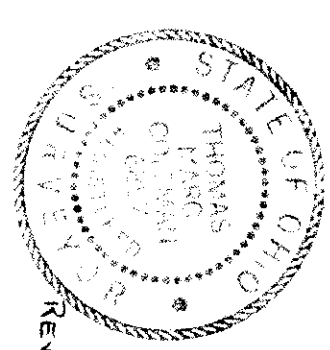

REV 1-20-91
9-25-91 (NEW LOCATIONS)

In the undersigned hereby certify that
this topography, indicated by 1' contours,
and elevations shown herein represent an
actual field survey made by me on 8-6-90
and that the elevations were taken at
appropriate intervals and that as of that
date they existed as indicated herein.

THOMAS P. GILL
NOTES

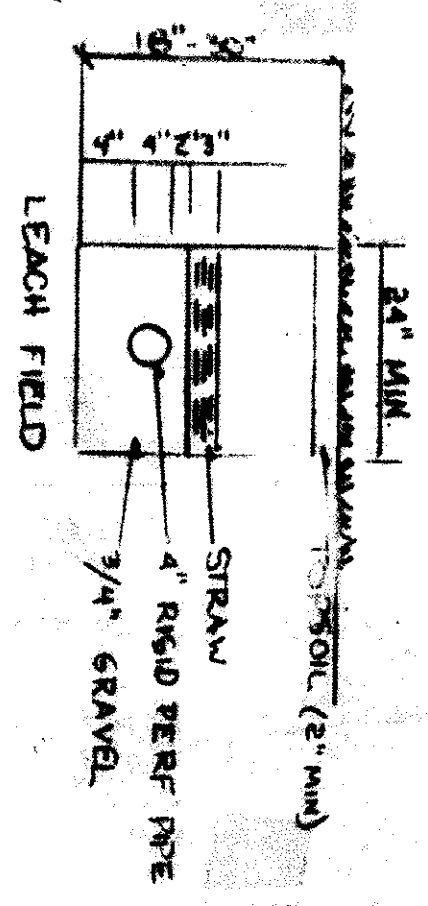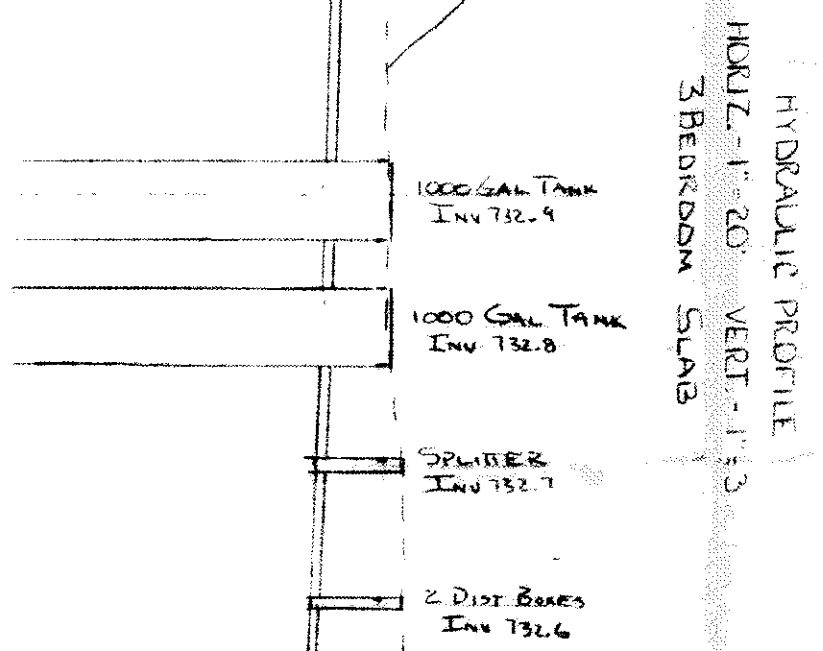

SOUTH RIDGE ROAD 60'

Grading Plan Approved
as shown and/or noted
THOMAS P. GILL, P.E.
Lake County Engineer

Date 10/11/91

0607 PERMIT REQUIRED

APPROVED
SIDE LINES & SET BACK
PERRY TOWNSHIP ZONING
PERMIT NO. 4548
ZONING INSPECTOR *[Signature]*

Reviewed and Accepted
LAKE COUNTY GENERAL HEALTH DISTRICT
Date 9-30-91
JOEL LUCIA, R. S. M. P. H.
Health Commissioner

BY *[Signature]*

SEWAGE DISPOSAL PERMIT MUST BE
OBTAINED BY A LAKE COUNTY LICENSED
INSTALLER BEFORE INSTALLATION IS
STARTED.

LOW YIELD WATER
FIXTURES REQUIRED
ON ALL:

Shower Head
Toilet

BENCHMARK - 737.80
NAIL IN POLE P.C. 5521

Shower Head
Toilet

VILLAGE SURVEYING CO.
202 THIRD STREET FAIRPORT HARBOR, OHIO 44077
(216) 353-1353