
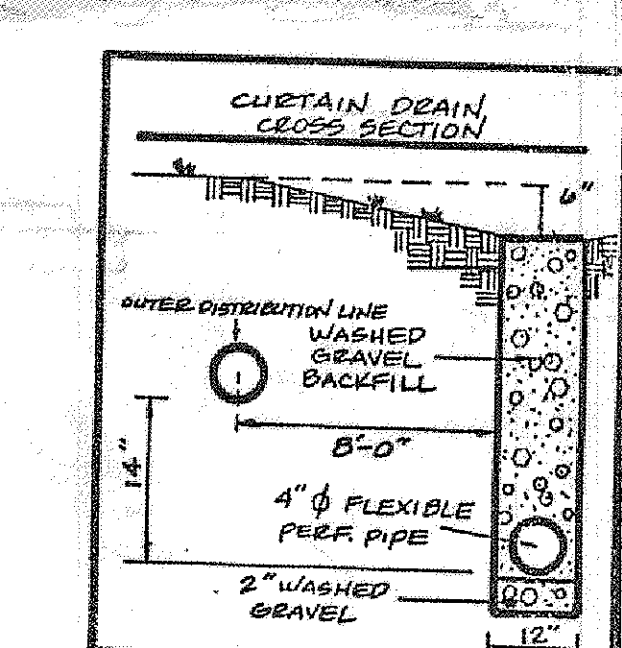
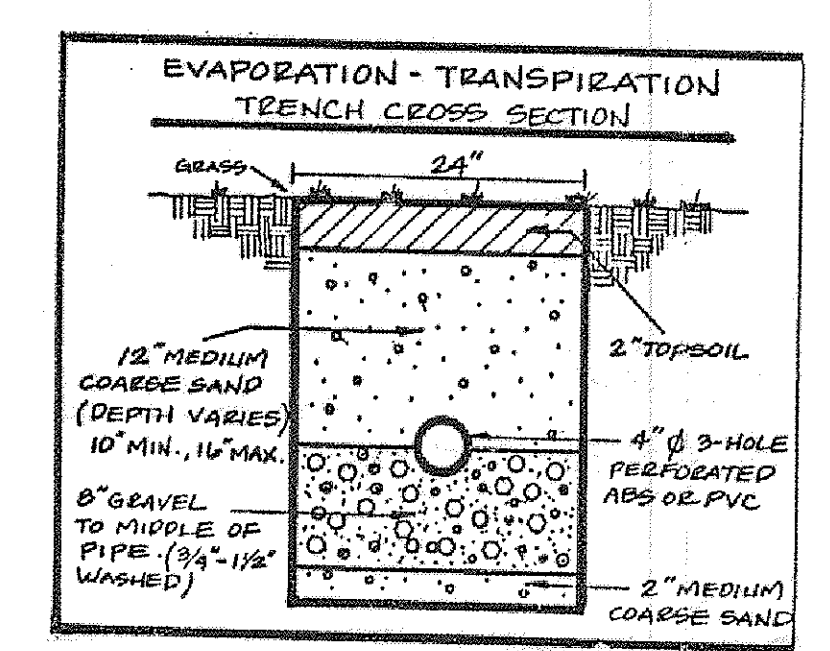


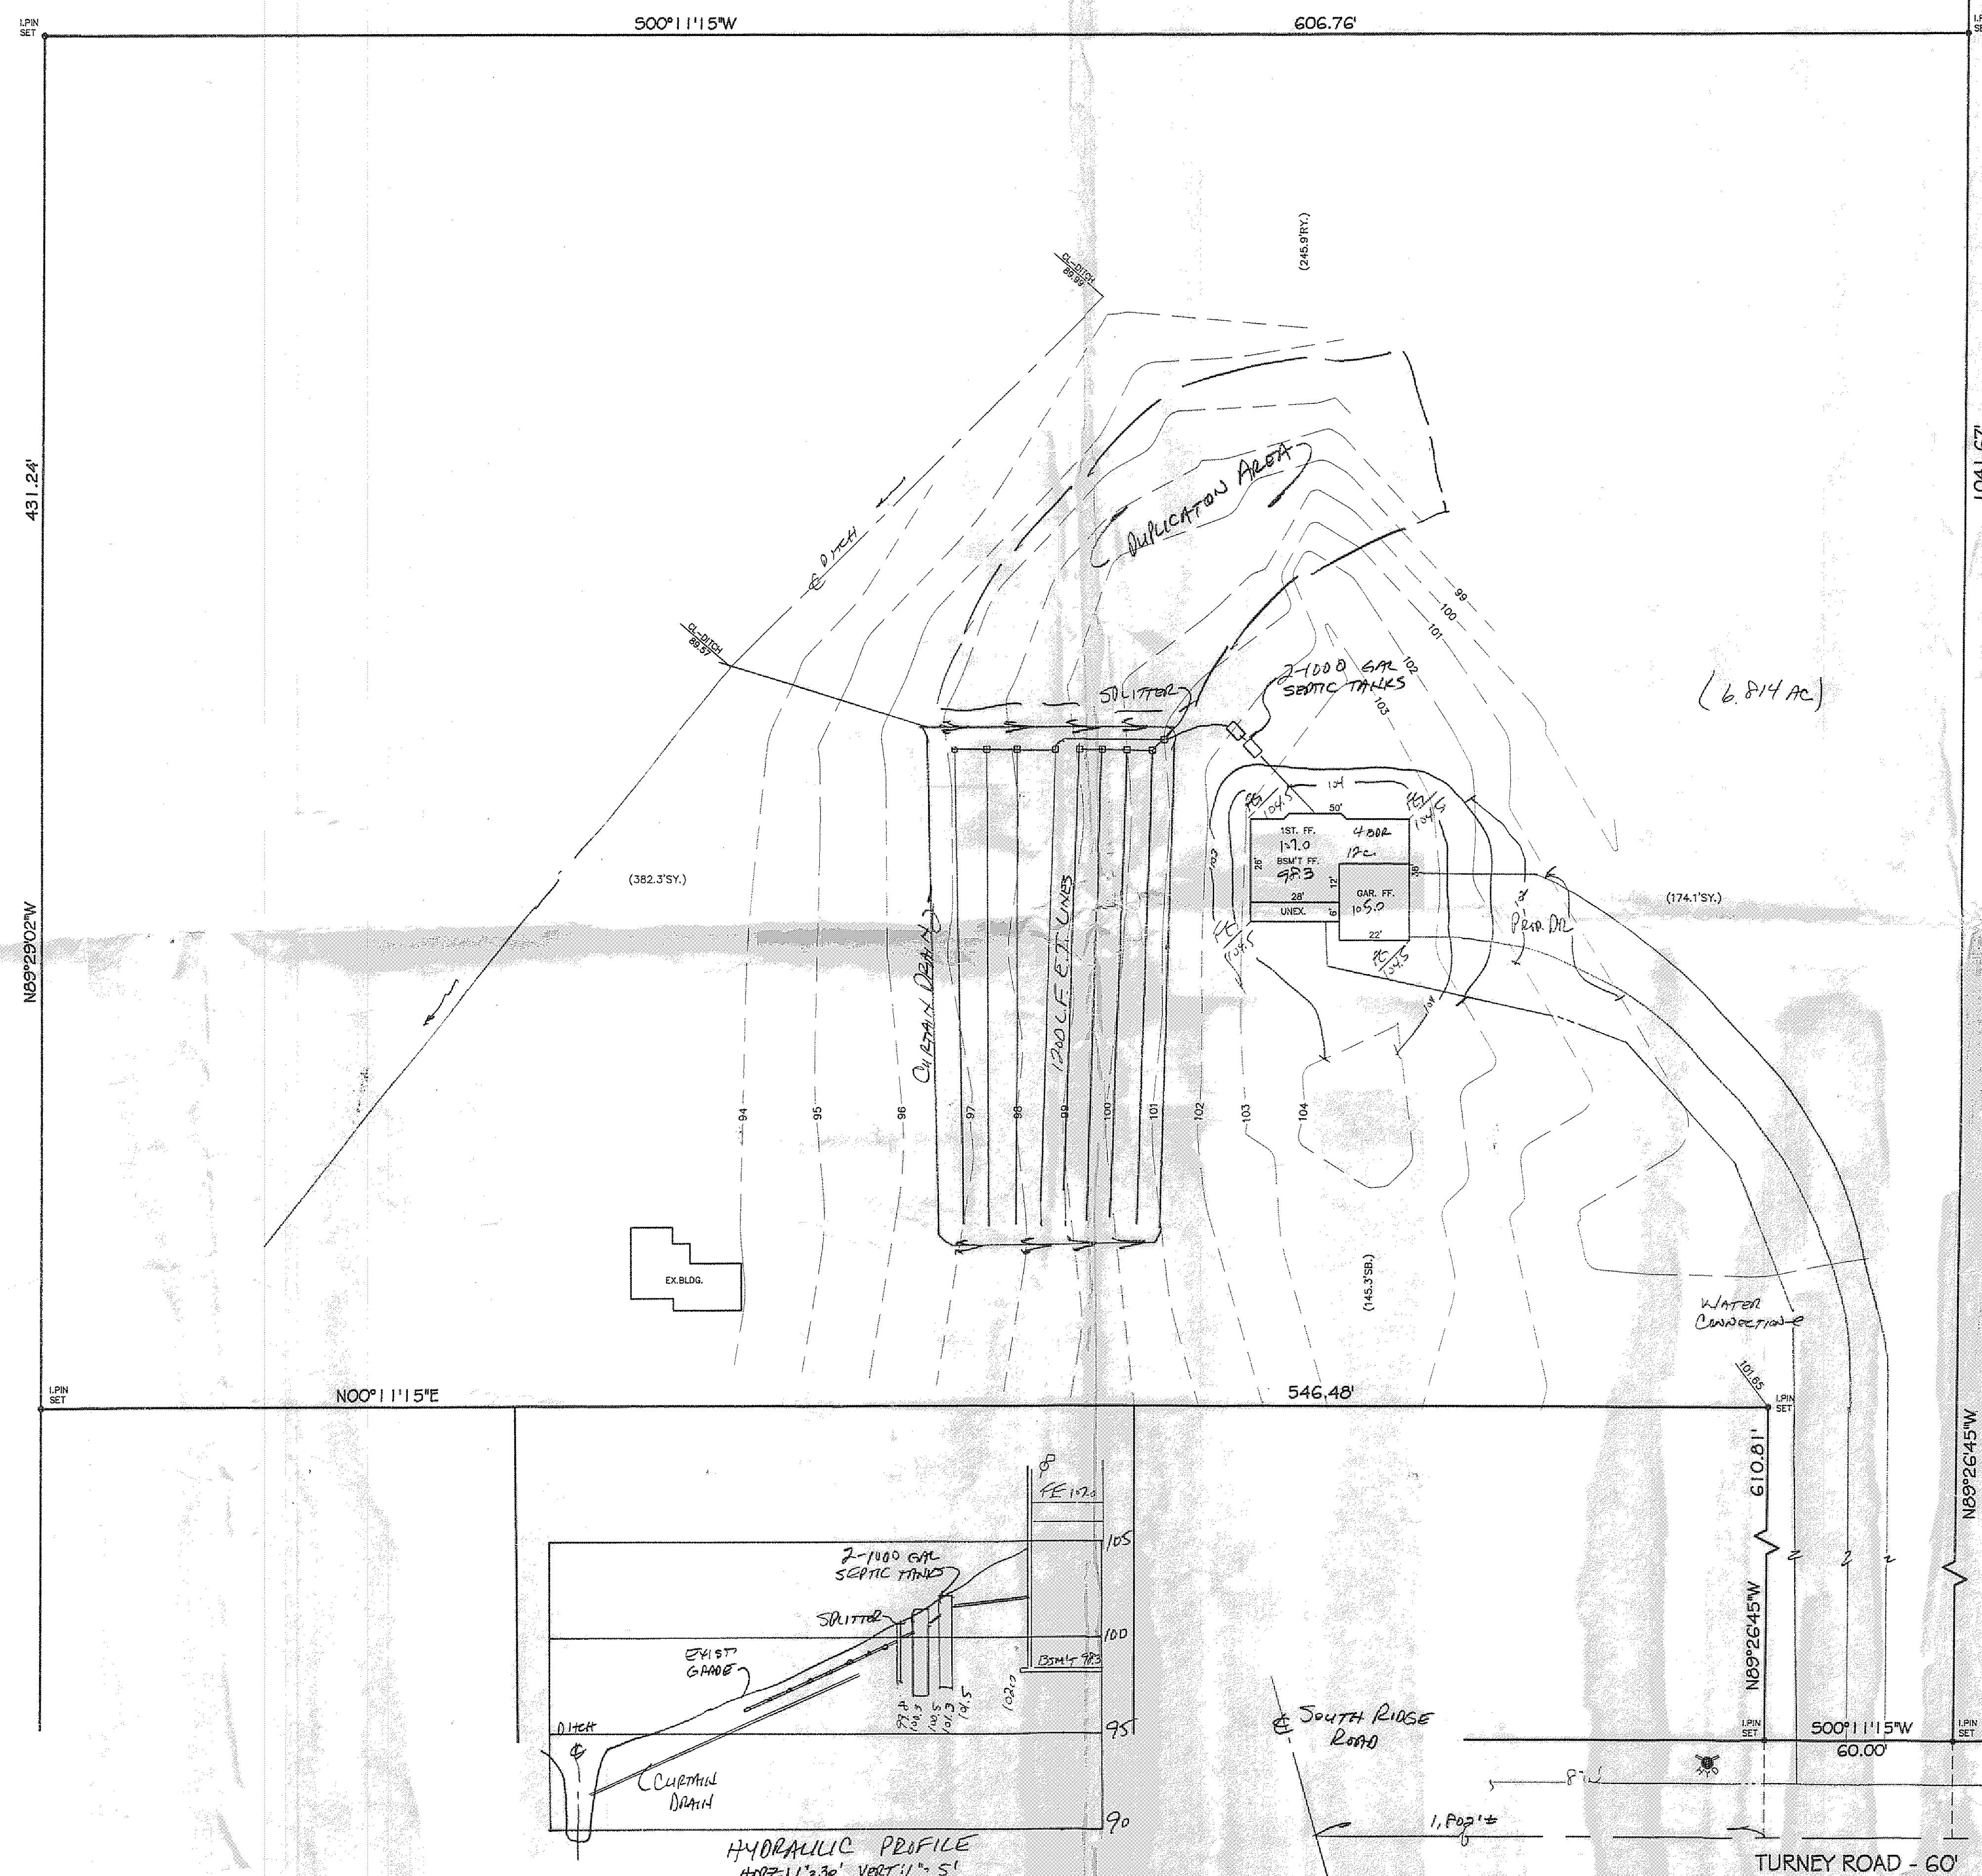

Grading Plan Approved as shown and/or noted
THOMAS P. GILLES, P.E.
Lake County Engineer

By L.H. Date 6.9.98
21" Drive Culvert

"I, the undersigned, hereby certify that this topography, including by 6", 1" or 2" contours, and elevations shown hereon represent an actual field survey made by me on the 12th day of May, 1998, and that the elevations were taken at appropriate intervals and that as of that date they existed as indicated hereon."

Name Harry S. Jones, Jr. #6343 Reg. No.

