




Grading Plan Approved  
as shown and/or noted  
JAMES R. GILLS, P.E.  
Lake County Engineer  
By TAM Date 6/1/9  
Scale as shown  
12" min drive culvert  
ROOF DRAINS  
SHALL DISCHARGE  
TO SPLASH BLOCKS.

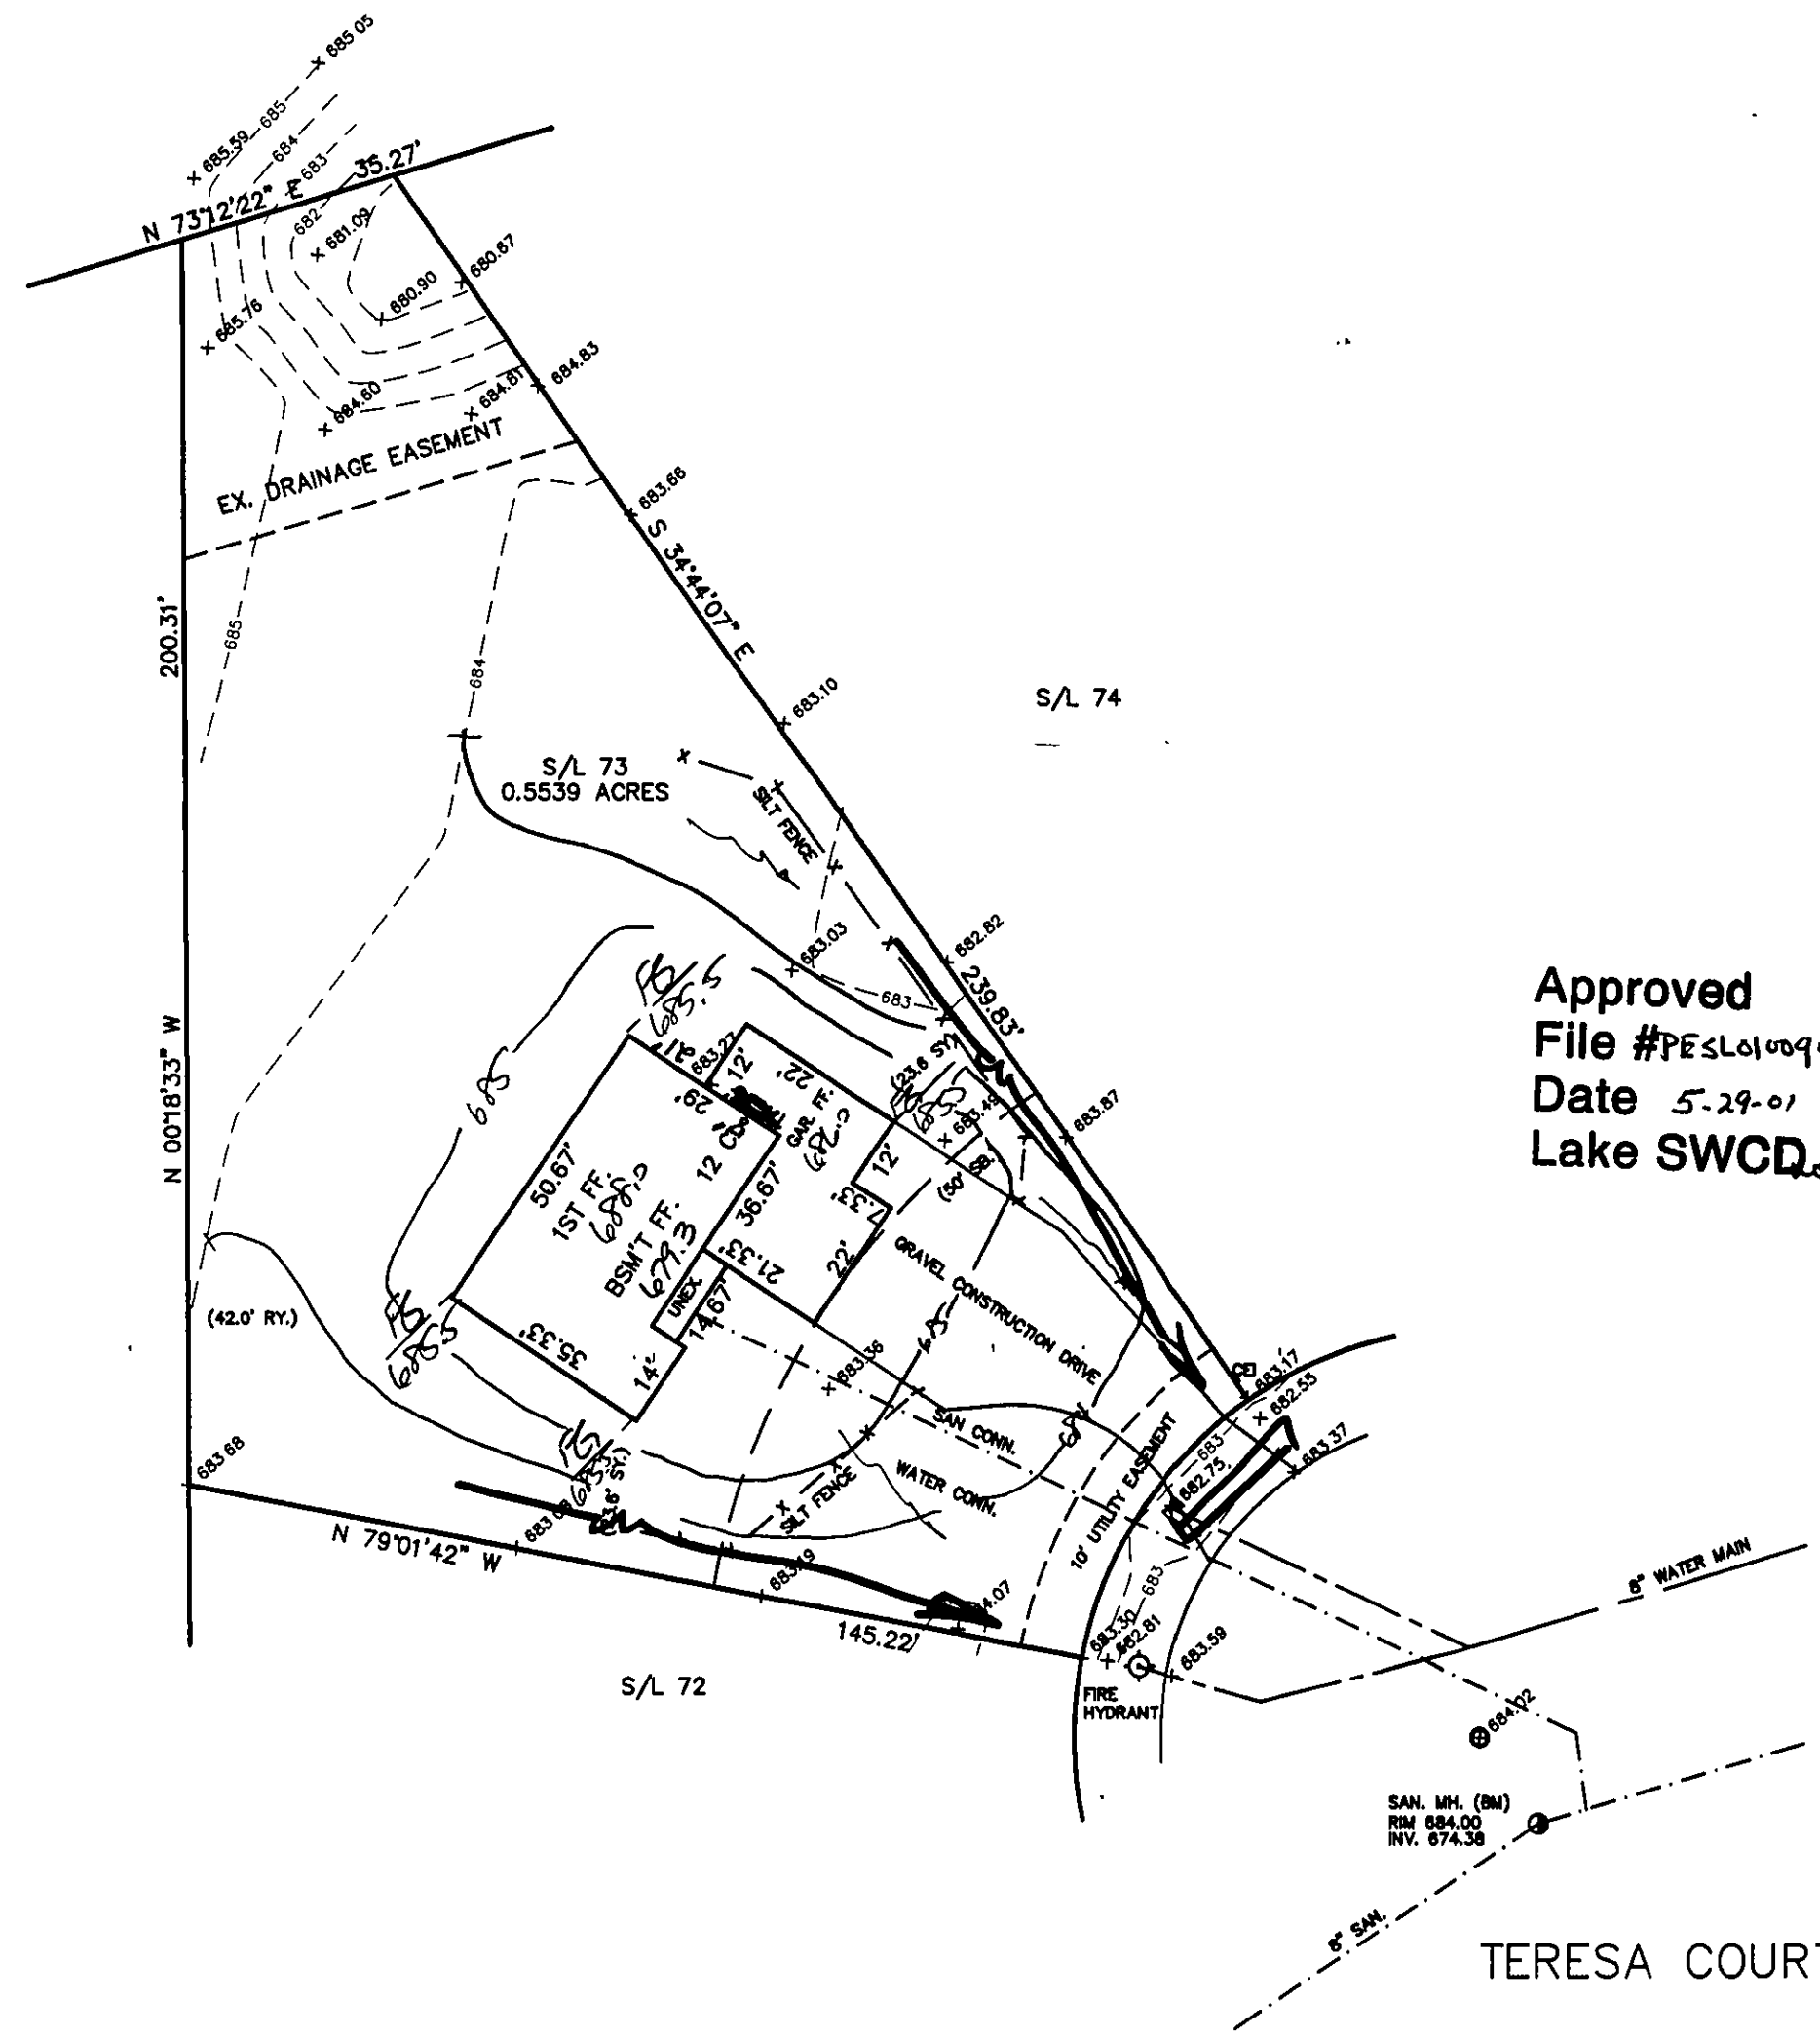

Approved  
File #PESL010094  
Date 5-29-01  
Lake SWCD

# SITE PLAN

PERRY TOWNSHIP, LAKE COUNTY, OHIO  
for: NAUGHTON BUILDING

CLIENT	OWNER		
ADDRESS	STREET	CITY	ZIP
RED MILL RUN		TRACT	
SUBDIVISION	32-26	NAME	STREET
73	VOL-PG.	LOT	STREET
SUBLOT NO.	TERESA COURT	VOL-PG.	PERM. PARCEL NO.

## LEGEND

SANITARY MANHOLE	-----	100.0	EXIST. ELEV.	100.0 ± 2	PROP. ELEV.
STORM MANHOLE	-----	100.0	AS BUILT ELEVATION		
INLET OR CATCH BASIN	-----	100.0	INDICATES		
HYDRANT	-----	100.0	DIRECTION OF		
EXISTING CONTOURS	-----	100.0	SURFACE DRAINAGE		
PROPOSED CONTOURS	-----	100.0			

## REMARKS

ALL BOUNDARY DATA SHOWN WAS OBTAINED FROM (DEEDS, RECORDED  
SUBDIVISION PLAT OR OTHER PUBLIC RECORDS)  
LOCATIONS AS SHOWN OF ADJACENT WELLS AND SEPTIC TANKS OBTAINED FROM  
LAKE COUNTY HEALTH DEPARTMENT

## DESIGN CERTIFICATION

THIS PLAT WAS PREPARED BY ME, AND IS CORRECT  
TO THE BEST OF MY KNOWLEDGE AND BELIEF.

NAME Harry S. Jones, Jr. SURVEYOR REGISTRATION NO. 4373

## CHECK LIST

NO. OF BEDROOMS	WATER MAIN SIZE, LOCATION
DIMENSIONS	SAN. SEWER SIZE & GR. LOC.
BEARINGS	SAN. MH. CAST. ELEV. INV. ELEV.
TIE TO NEAREST STREET	SAN. CONN. SIZE, LOC. DEPTH
SUBLOT NO. PARCEL NO.	STORM SEWER SIZE & GR. LOC.
SURROUNDING OWNERS	STORM MH. CAST ELEV. INV. ELEV.
BLDG. DIMENSIONS FIN GR.	PAV'T TYPE GRADE CURBS
BLDG. TIES FL'R. GRADES	GAS LINE LOC. SIZE PRESSURE
APRON TYPE WIDTH THICKNESS	SEPTIC TANK LOCATION & DUPLICATION AREA
SIDEWALK TYPE WIDTH THICKNESS	WELL LOCATION
CULVERT TYPE DIA., LENGTH	ISOLATION RADIUS FROM WELL
ROCK OUTCROPPINGS	

REVISIONS			PLAN PREPARED BY:		
NO.	DATE	BY	Bj BABCOCK · JONES & ASSOCIATES, INC.		
1			PAINESVILLE, OHIO		
2			DRAWN BY J.D.	SCALE 1" = 30'	PHONE NO. 440-367-1811
3			CHK'D. H.J.	DATE 5/21/01	DRAWING NO. 93-032-73
4			CREW W.B.	APP'D H.J.	
5			CHIEF		

"AS BUILT" CERTIFICATION  
I, HEREBY CERTIFY THAT THE CIRCLED GRADES ARE EXISTING  
FINISH GRADES CHECKED IN THE FIELD ON \_\_\_\_\_, 20\_\_\_\_  
AND ARE CORRECT TO THE BEST OF MY KNOWLEDGE AND BELIEF.

REGISTERED SURVEYOR REG. NO.

APPROVED  
SIDE LINES & SET BACK  
PERRY TOWNSHIP ZONING  
PERMIT NO. 7118  
ZONING INSPECTOR

