


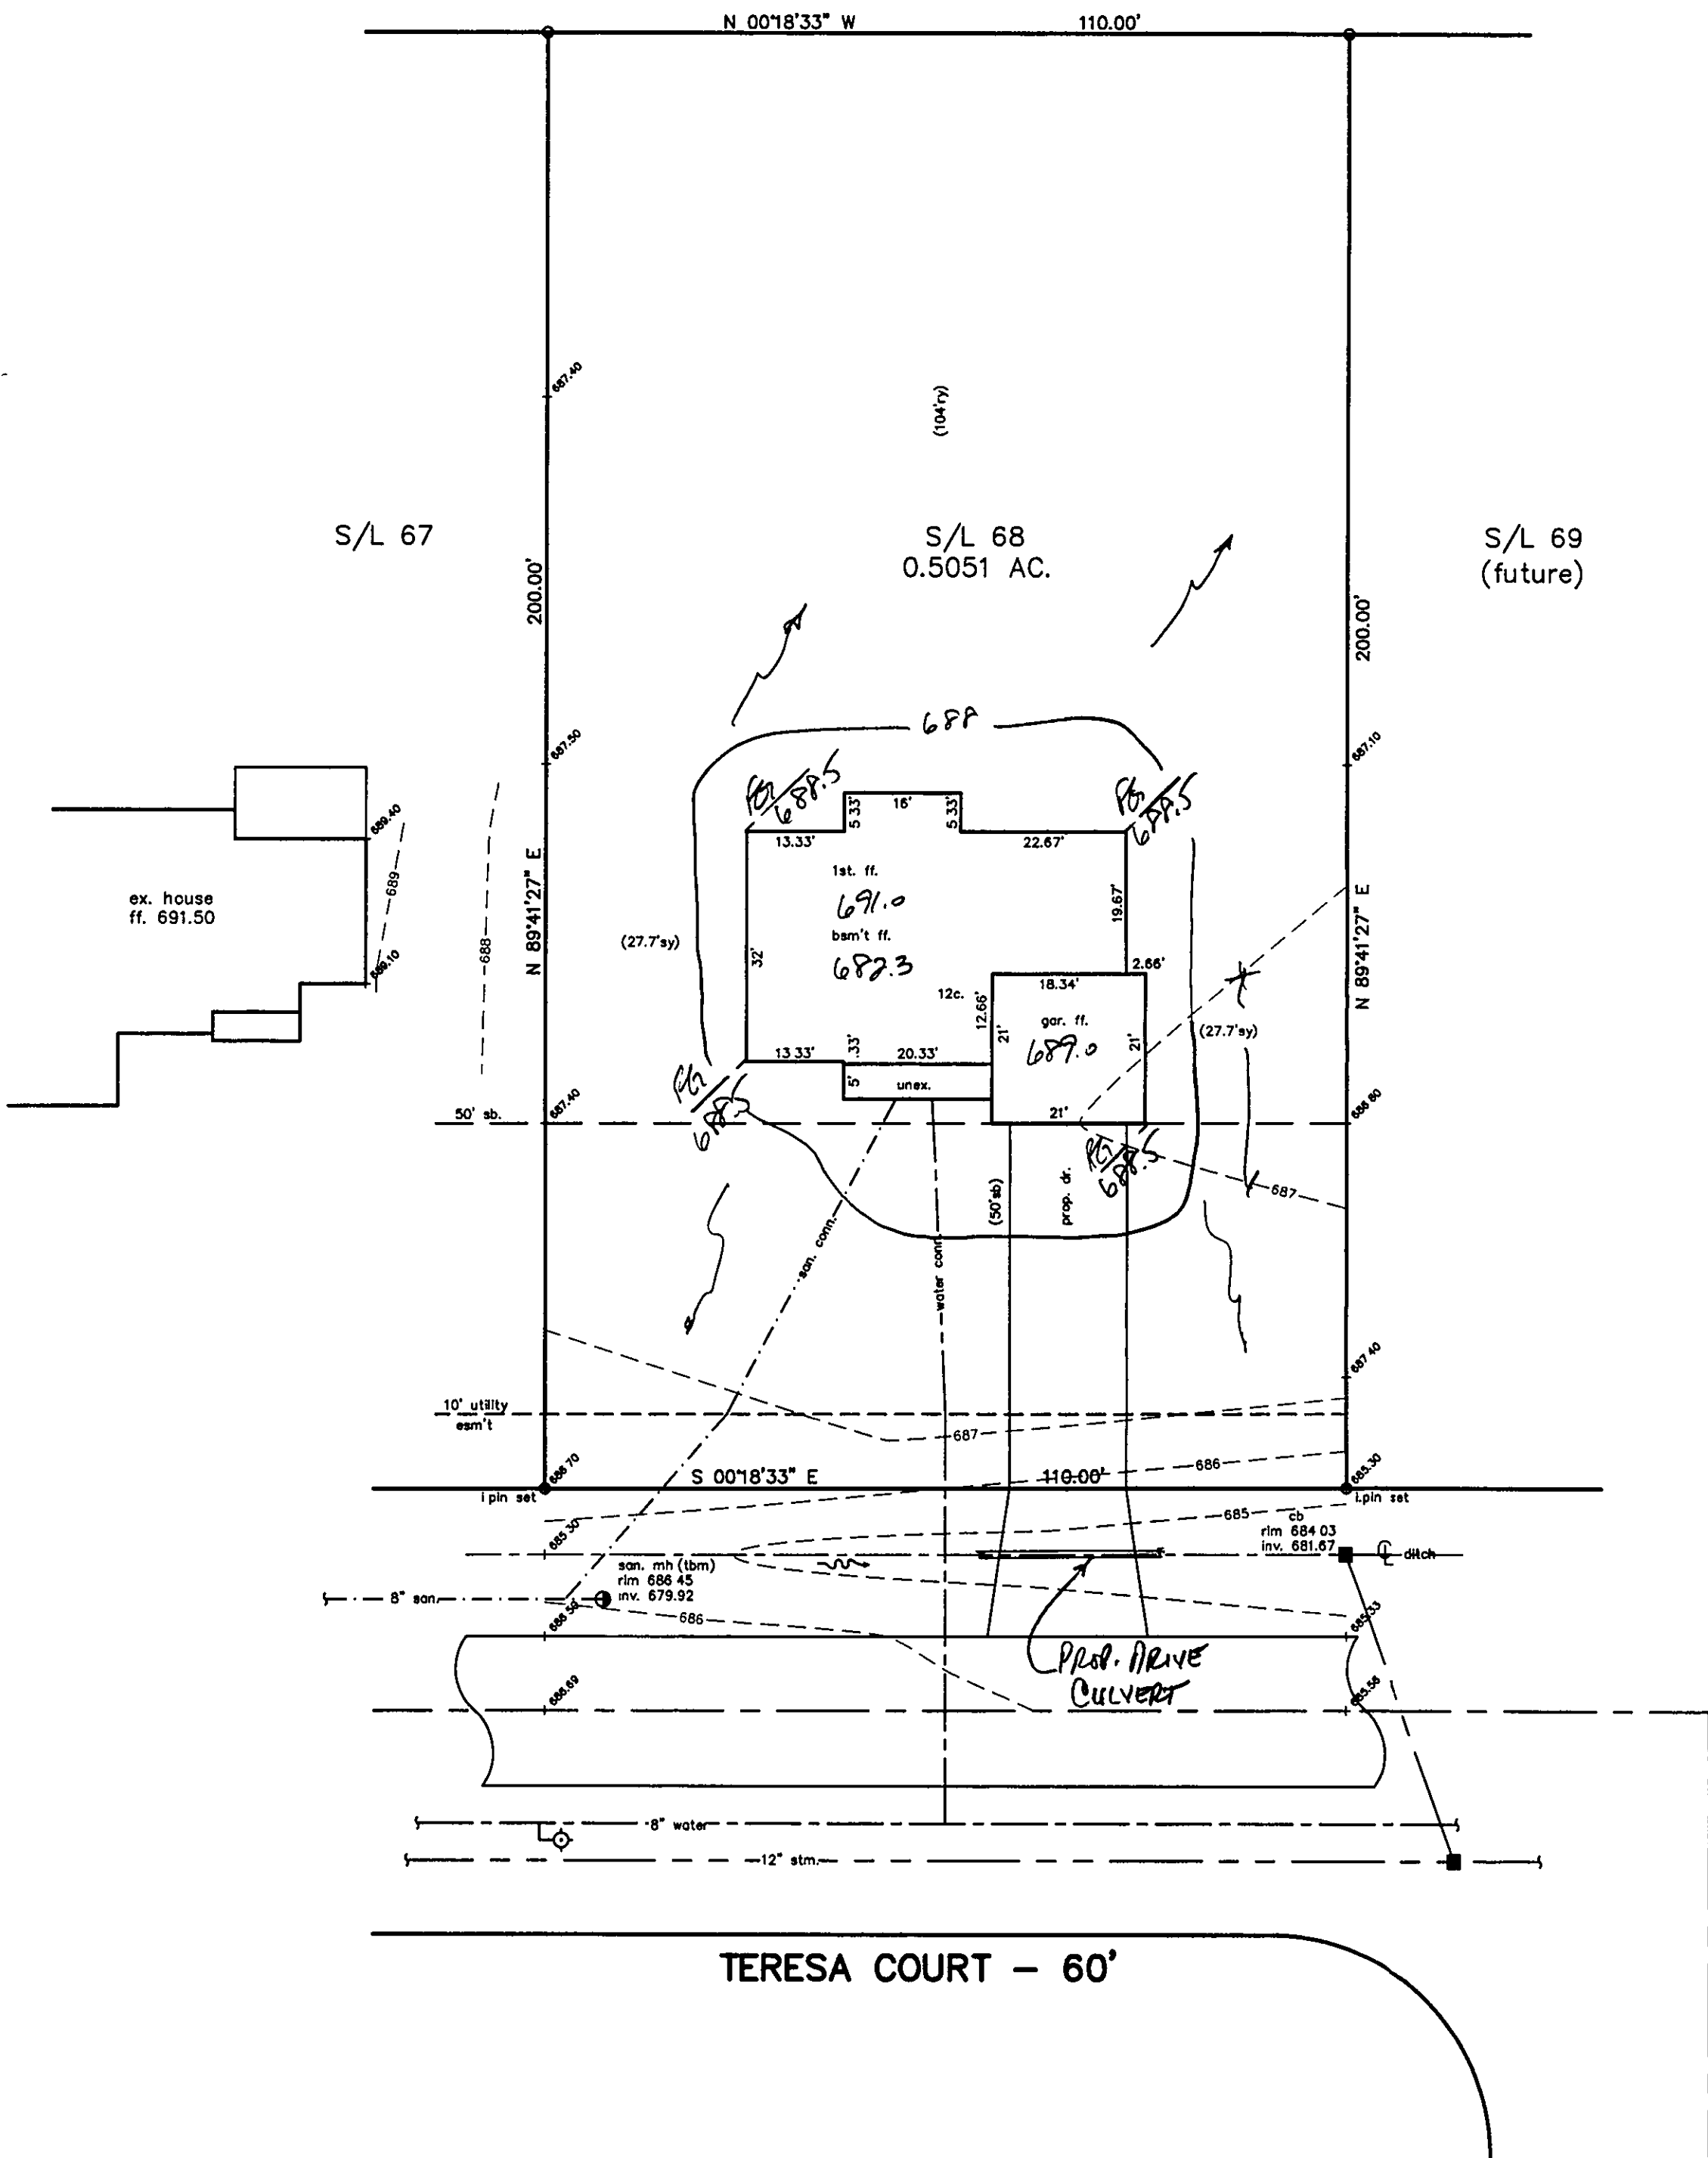

SITE PLAN

PERRY TOWNSHIP, LAKE COUNTY, OHIO
for: NAUGHTON BUILDING COMPANY

ADDRESS		STREET	CITY	ZIP
RED MILL	SUBDIVISION	NAME	TRACT	STREET
68	32-28	TERESA CRT.	LOT	
SUBLOT NO.	STREET	VOL.-Pg.	PERM. PARCEL NO.	

LEGEND

SANITARY MANHOLE	---○---
STORM MANHOLE	---●---
INLET OR CATCH BASIN	---□---
HYDRANT	---⊙---
EXISTING CONTOURS	---○---
PROPOSED CONTOURS	---○---

EXIST. ELEV. ---100.0
100.0 ±2--- PROP. ELEV.

AS BUILT ELEVATION

INDICATES DIRECTION OF SURFACE DRAINAGE

REMARKS

ALL BOUNDARY DATA SHOWN WAS OBTAINED FROM (DEEDS, RECORDED SUBDIVISION PLAT OR OTHER PUBLIC RECORDS)

LOCATIONS AS SHOWN OF ADJACENT WELLS AND SEPTIC TANKS OBTAINED FROM LAKE COUNTY HEALTH DEPARTMENT

DESIGN CERTIFICATION

THIS PLAT WAS PREPARED BY ME, AND IS CORRECT TO THE BEST OF MY KNOWLEDGE AND BELIEF.

NAME: *Harry S. Jones, Jr.* SURVEYOR REGISTRATION NO. *6343*

CHECK LIST

NO. OF BEDROOMS	WATER MAIN SIZE, LOCATION
DIMENSIONS	SAN. SEWER SIZE & GR. LOC.
BEARINGS	SAN. MH. CAST. ELEV. INV. ELEV.
TIE TO NEAREST STREET	SAN. CONN. SIZE, LOC. DEPTH
SUBLOT NO. PARCEL NO.	STORM SEWER SIZE & GR. LOC.
SURROUNDING OWNERS	STORM MH. CAST ELEV. INV. ELEV.
BLDG. DIMENSIONS FIN GR.	PAV'T TYPE GRADE CURBS
BLDG. TIES FL'R. GRADES	GAS LINE LOC. SIZE PRESSURE
APRON TYPE WIDTH THICKNESS	SEPTIC TANK LOCATION & DUPLICATION AREA
SEWALK TYPE WIDTH THICKNESS	WELL LOCATION
CULVERT TYPE DIA. LENGTH	ISOLATION RADIUS FROM WELL
ROCK OUTCROPPINGS	

REVISIONS			PLAN PREPARED BY:	
NO.	DATE	BY	BABCOCK JONES & ASSOCIATES, INC.	
1			PAINESVILLE, OHIO	
2			DRAWN BY T.R.	SCALE 1"=20'
3			CHK'D. H.J.	DATE 6/10/99
4			CREW CHIEF M.M.	APP'D H.J.
5				PHONE NO. 440-367-1811
				DRAWING NO. 93-032-68

"AS BUILT" CERTIFICATION

I, HEREBY CERTIFY THAT THE CIRCLED GRADES ARE EXISTING FINISH GRADES CHECKED IN THE FIELD ON _____, 19____ AND ARE CORRECT TO THE BEST OF MY KNOWLEDGE AND BELIEF.

REGISTERED SURVEYOR _____ REG. NO. _____

TBM-SANITARY MH.
ELEV.=686.45

Grading Plan Approved
as shown and/or noted
THOMAS P. GILLES, P.E.
Lake County Engineer

APPROVED
SIDE LINES & SET BACK
PERRY TOWNSHIP ZONING
PERMIT NO. *6853*
ZONING INSPECTOR

By *Harry S. Jones, Jr.* Date *6/20/99*

ROOF DRAINS
SHALL DISCHARGE
TO SPLASH BLOCKS.

