




I CERTIFY THAT THIS PLAN
WAS PREPARED BY ME AND
IS CORRECT TO THE BEST OF
MY KNOWLEDGE AND BELIEF

John C. Skonieczny
REG. SURVEYOR #6356

JOHN C. SKONIECZNY
7739 VIEWMOUNT DR.
PAINESVILLE, OHIO 44077
PH. 352-7742

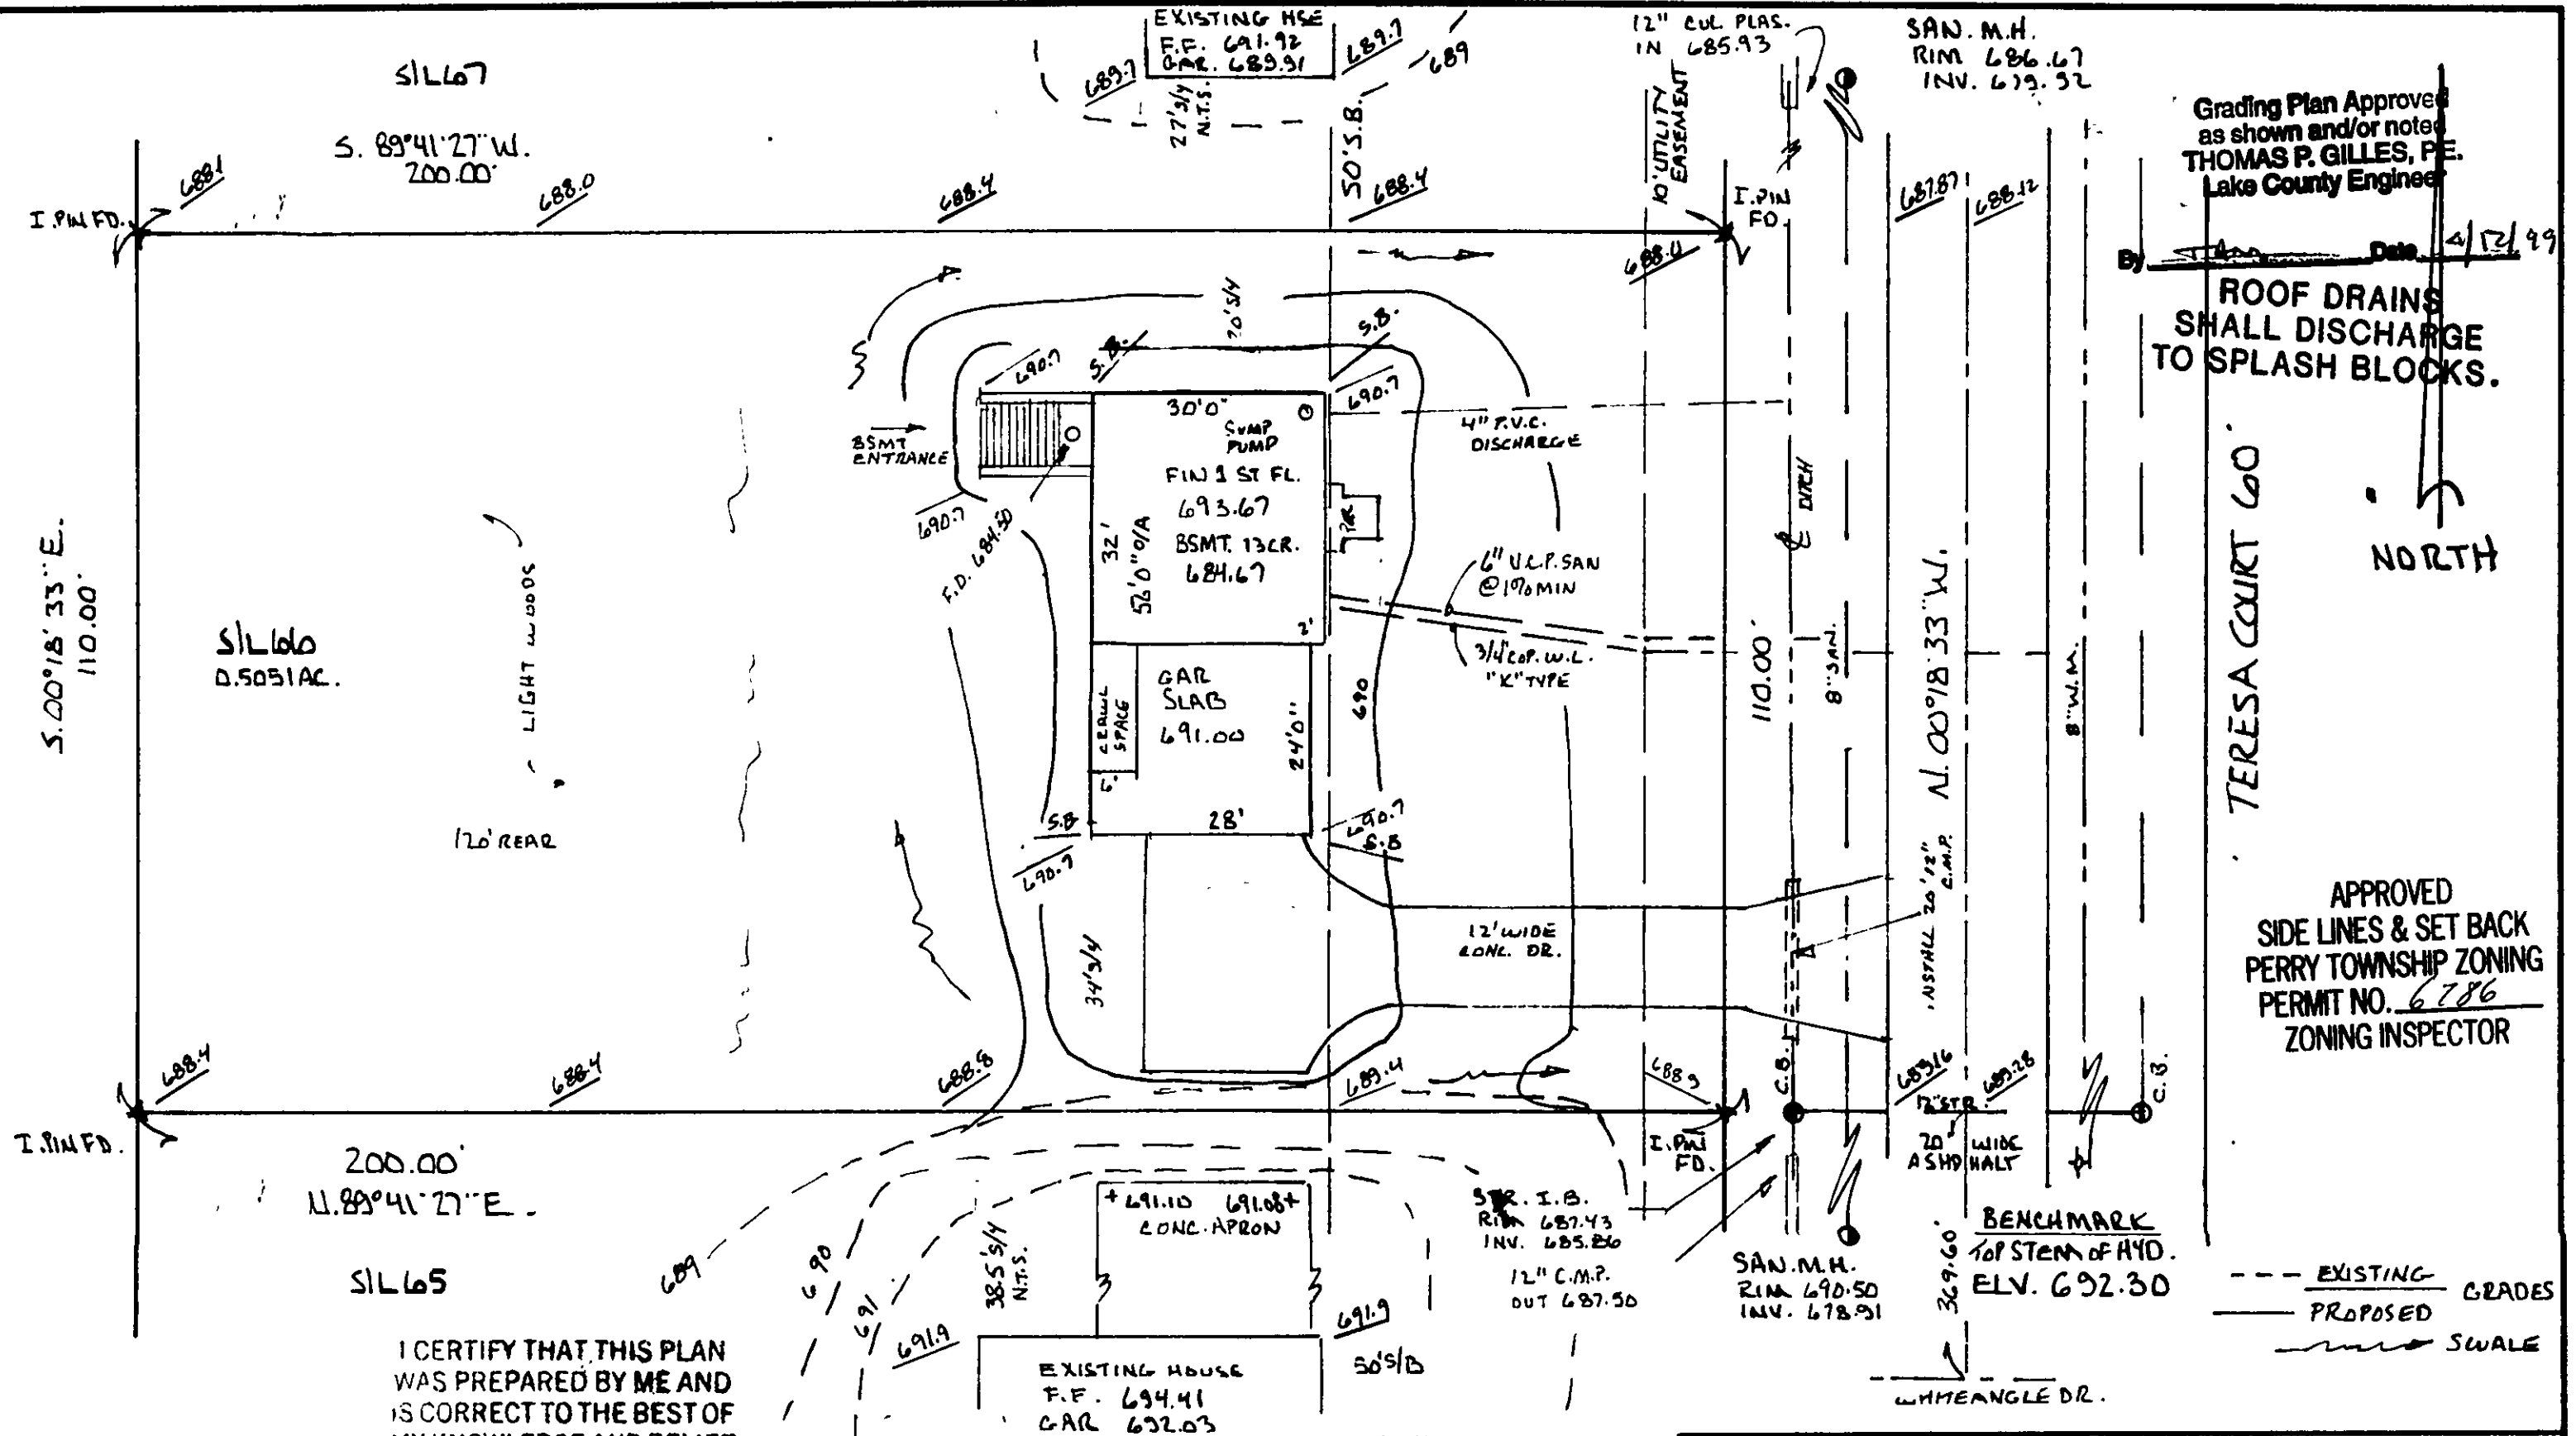

SITE PLAN FOR: OTTAR MAGNUSSON

SCALE: 1" = 20'	APPROVED BY	DRAWN BY J.C.S.
DATE: MAR-31-99		
BRING SUBLOT 66 IN THE RED MILL RUN SUBDIVISION No. 2 AS RECORDED IN VOL. 32-26-1 OF THE L.C.R.P. TOWNSHIP OF PERRY COUNTY OF LAKE STATE OF OHIO		
JOB# 99-2758		DRAWING NUMBER 99-1764