




Barrington
CONSULTING GROUP, INC.
38342 WESTERN PARKWAY, SUITE 10
WILLOUGHBY, OHIO 44094
PHONE (440) 946-1761 FAX (440) 918-0486

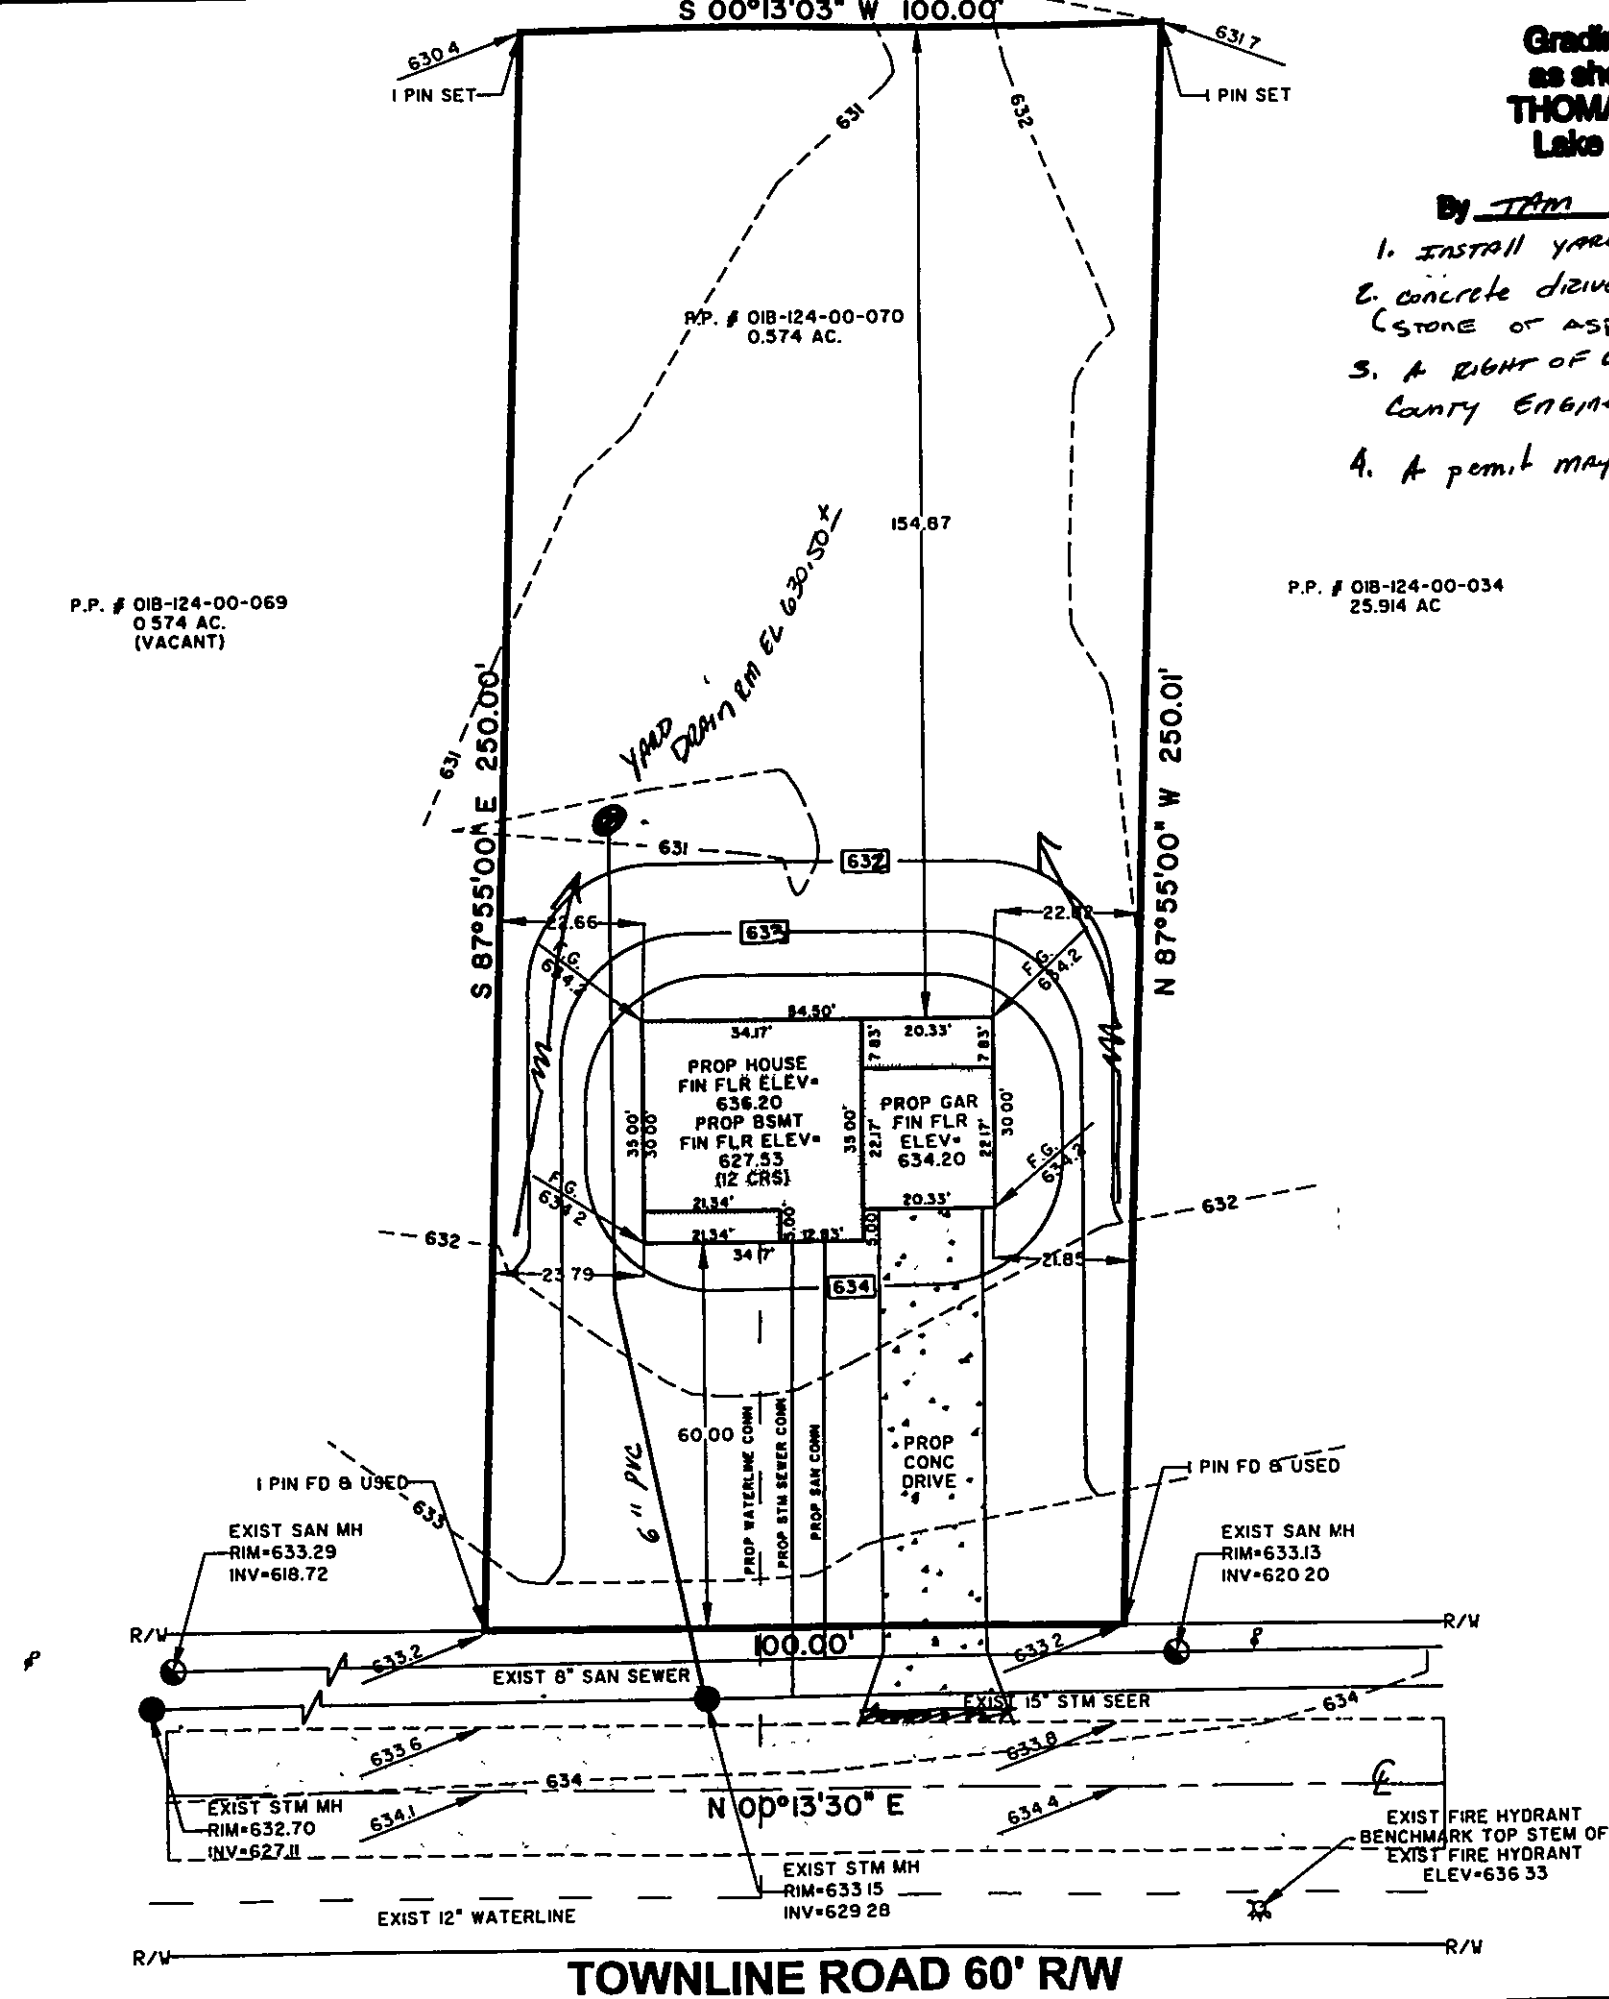

SITE PLAN
TOWNLINE ROAD, MADISON OH
P.P. # 01B-124-00-70
House # 2965
NEUBERT CONSTRUCTION, INC.

DATE
C.R. KRAFT
CHECKED
DWN
DATE
NOVEMBER 12, 1999
SCALE
1" = 30'
JOB NO.
99125
SHEET
SP-1
OF SHEETS