


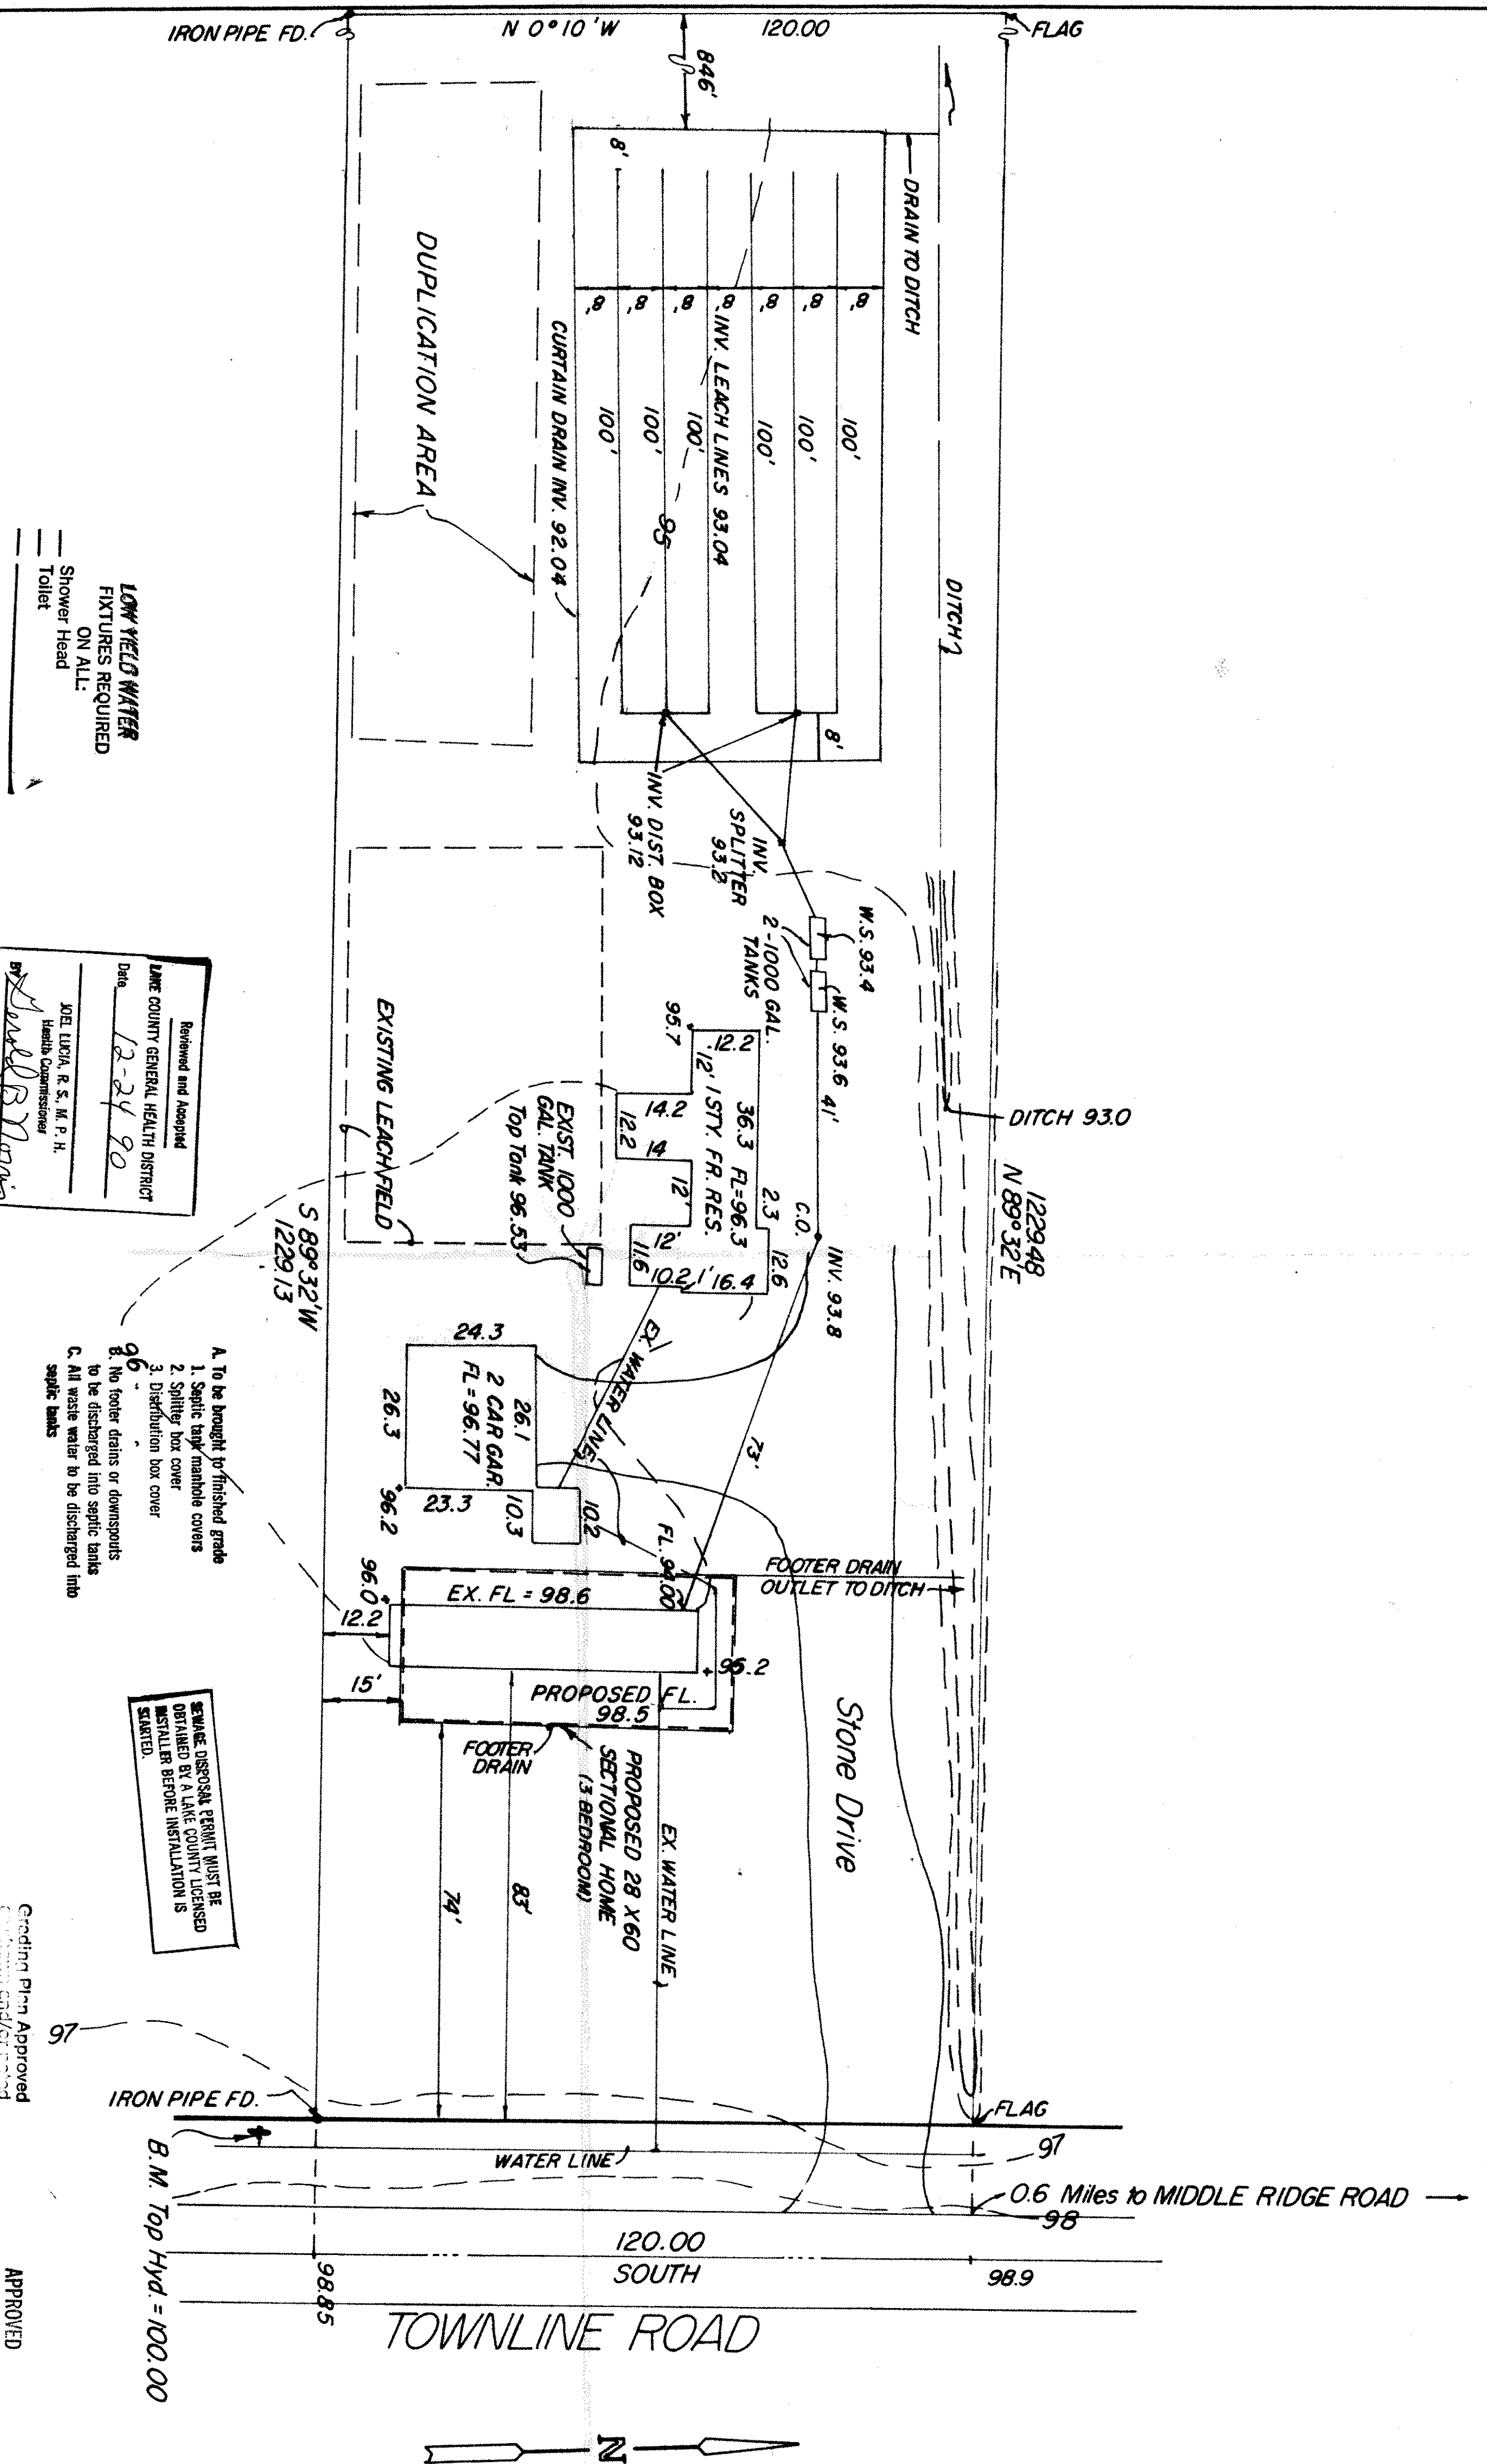

DEVELOPER: JIM VICTOR

JERRY SLAY, Ohio Surveyor No. 5298

Eroding Pin Approved
 and/or tested
 by J. P. GILLES, P.E.
 Lake County Engineer
 By GUH Date 11/1/90

APPROVED
SIDE LINES & SET BACK
PERRY TOWNSHIP ZONING
PERMIT NO. 4437
ZONING INSPECTOR *Robert [Signature]*

SITE PLAN PAUL A. MAYFIELD	
T = 20' 12-20-90	APPROVED BY _____ DRAWN BY _____ REVISID _____

LOT 71 PERRY TWP.