



EXIST.
PROP.

FOR

**Grading Plan Approved
as shown and/or noted
THOMAS P. GILLES, P.E.
Lake County Engineer**


P.K.M. DEVELOPERS, INC.

BY Tam

Date 11/27/99

BEING KNOWN AS S/L 31 IN MOORE'S LANDINGS, 11TH SUBDIVISION IN MADISON TOWNSHIP, LAKE COUNTY,

11/2/197
(Example shown)
not recommended
(SEE SUBDIVISION
plans)

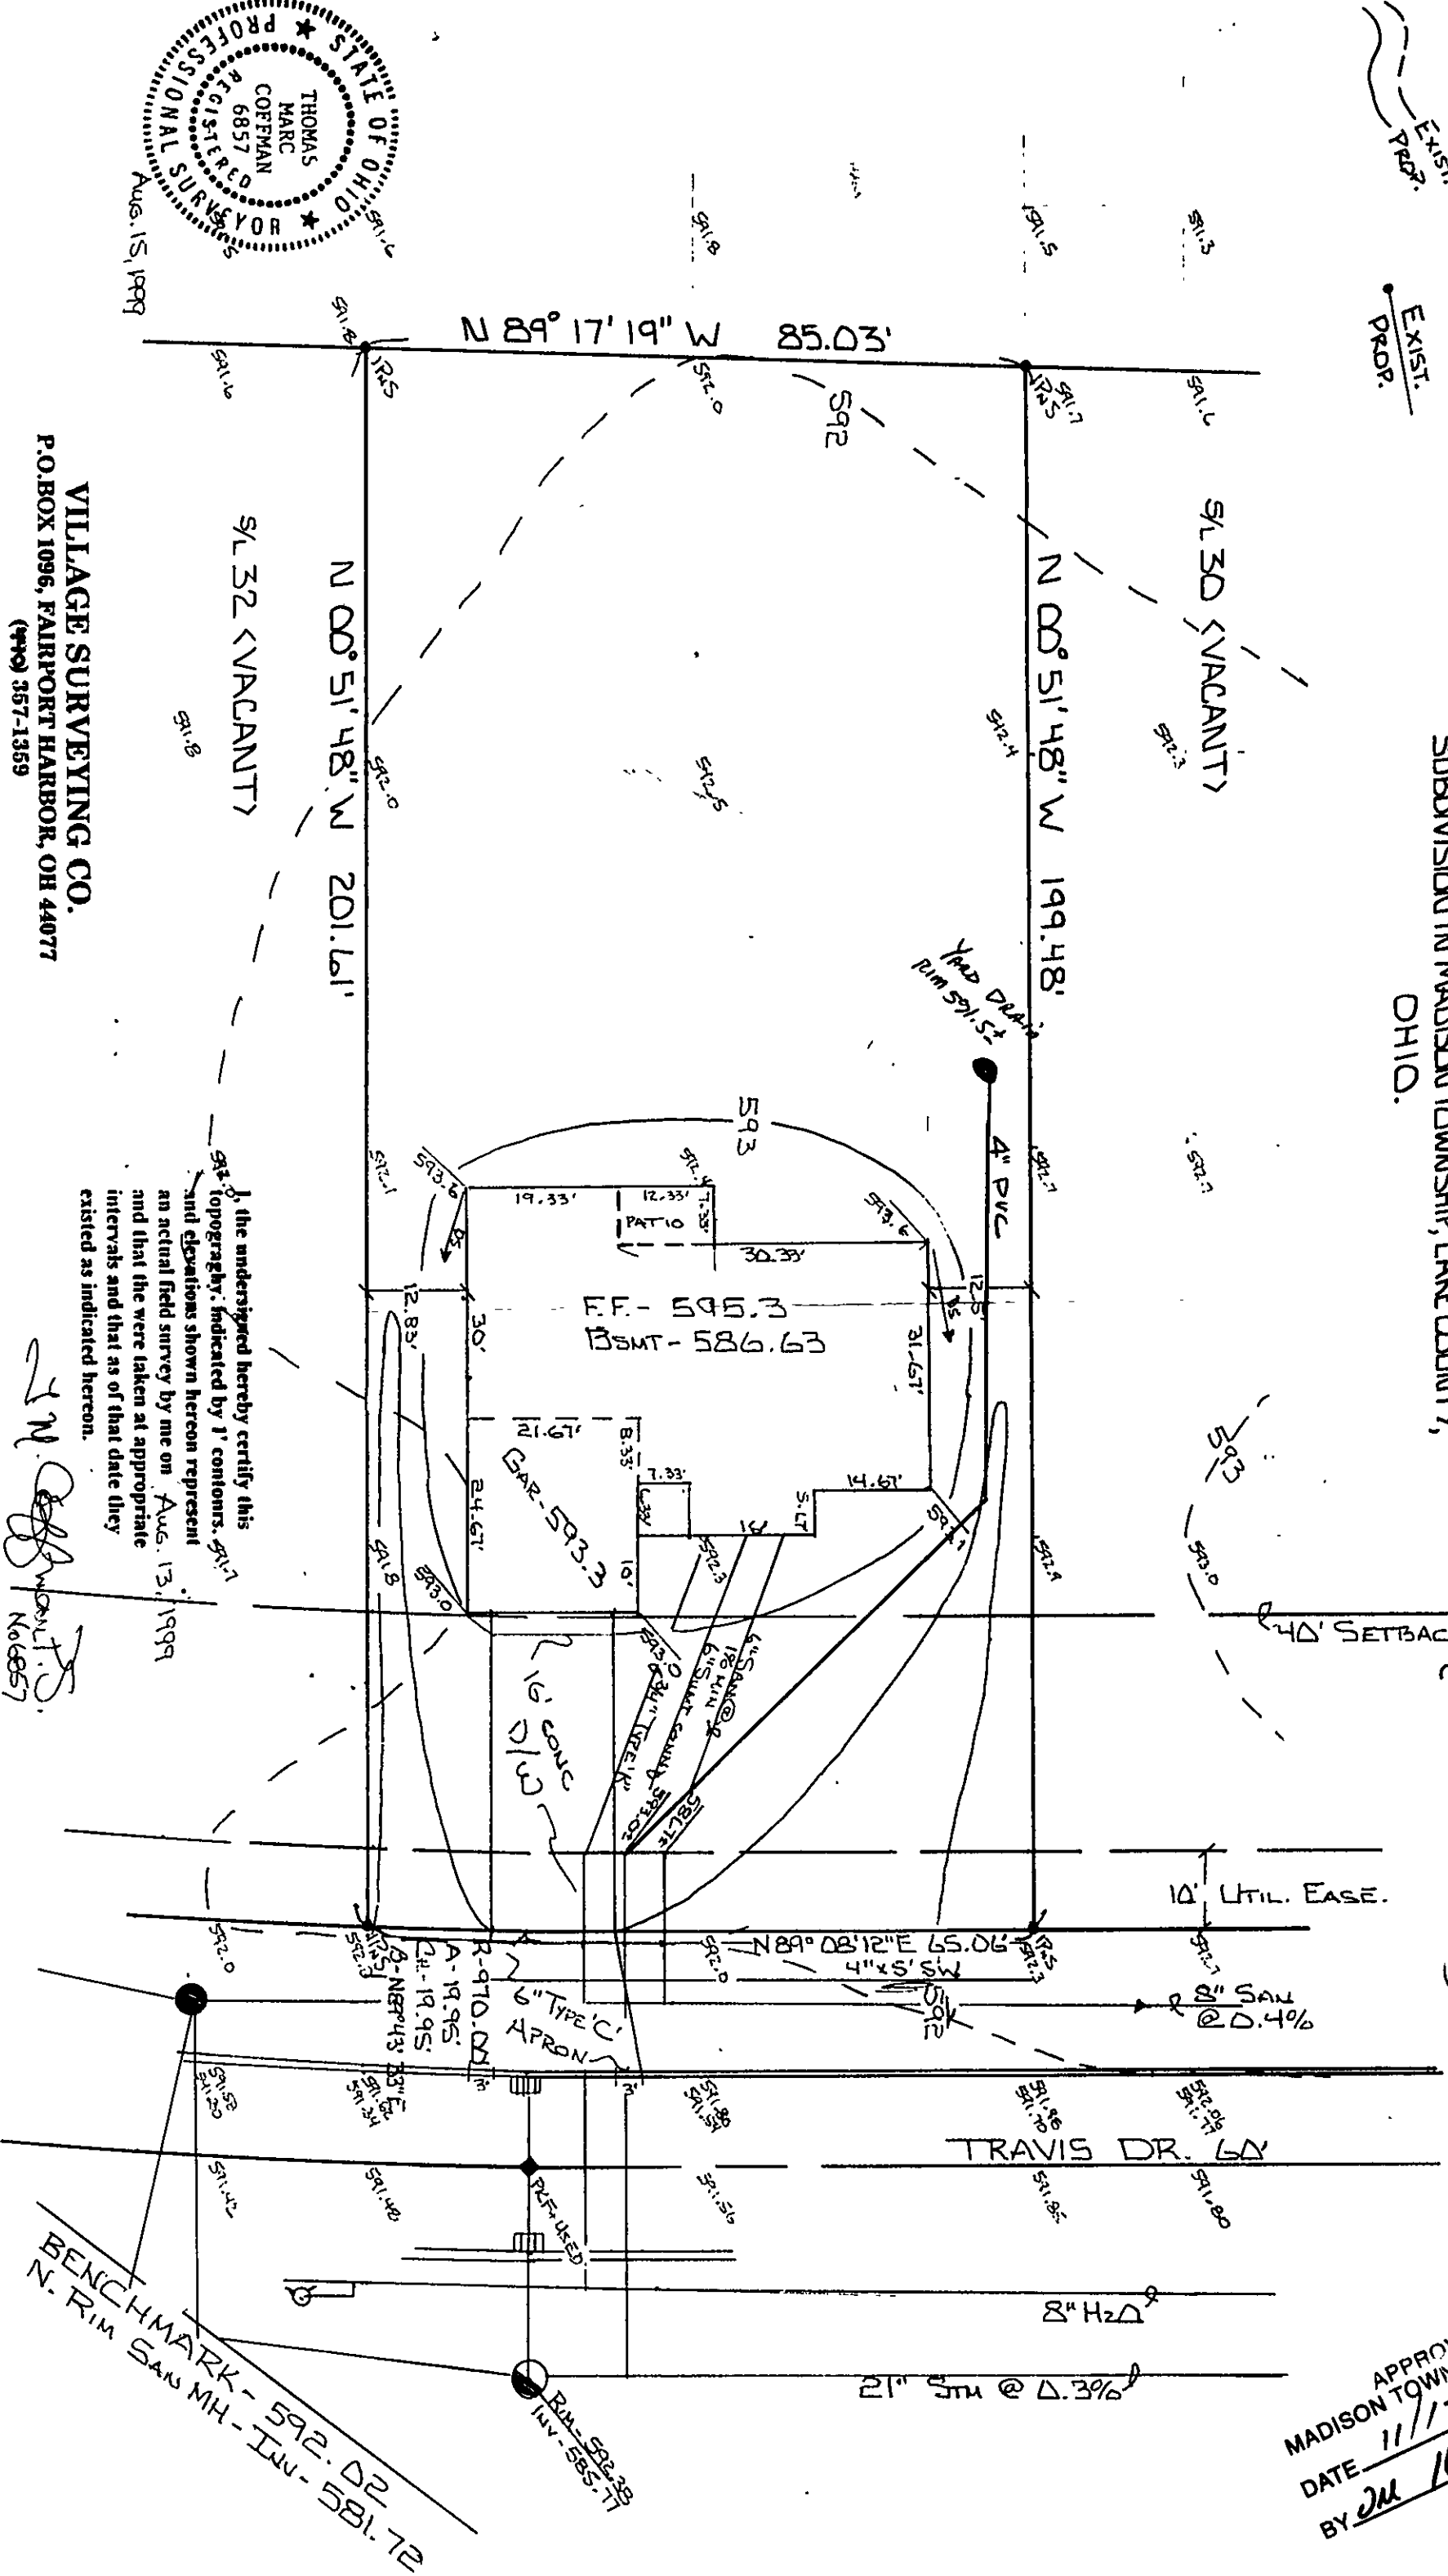

APPROVED
MADISON TOWNSHIP ZONING
DATE 11/17/99
BY JM 16495