

SCALE: 1" = 20'



EXIST.
PROP.



SITE PLAN

FOR
P.K.M. DEVELOPER'S, INC.
BEING KNOWN AS S/L 28 IN MADISON TOWNSHIP, LAKE COUNTY,
OHIO.

Grading Plan Approved
as shown and/or noted
THOMAS P. GILLES, P.E.
Lake County Engineer

By THM Date 11/29/99

1/15/00 JMD DMM (Example shown)
BASEMENTS NOT RECOMMENDED FOR THIS SOILS (SEE SUBDIVISION PERMITS)

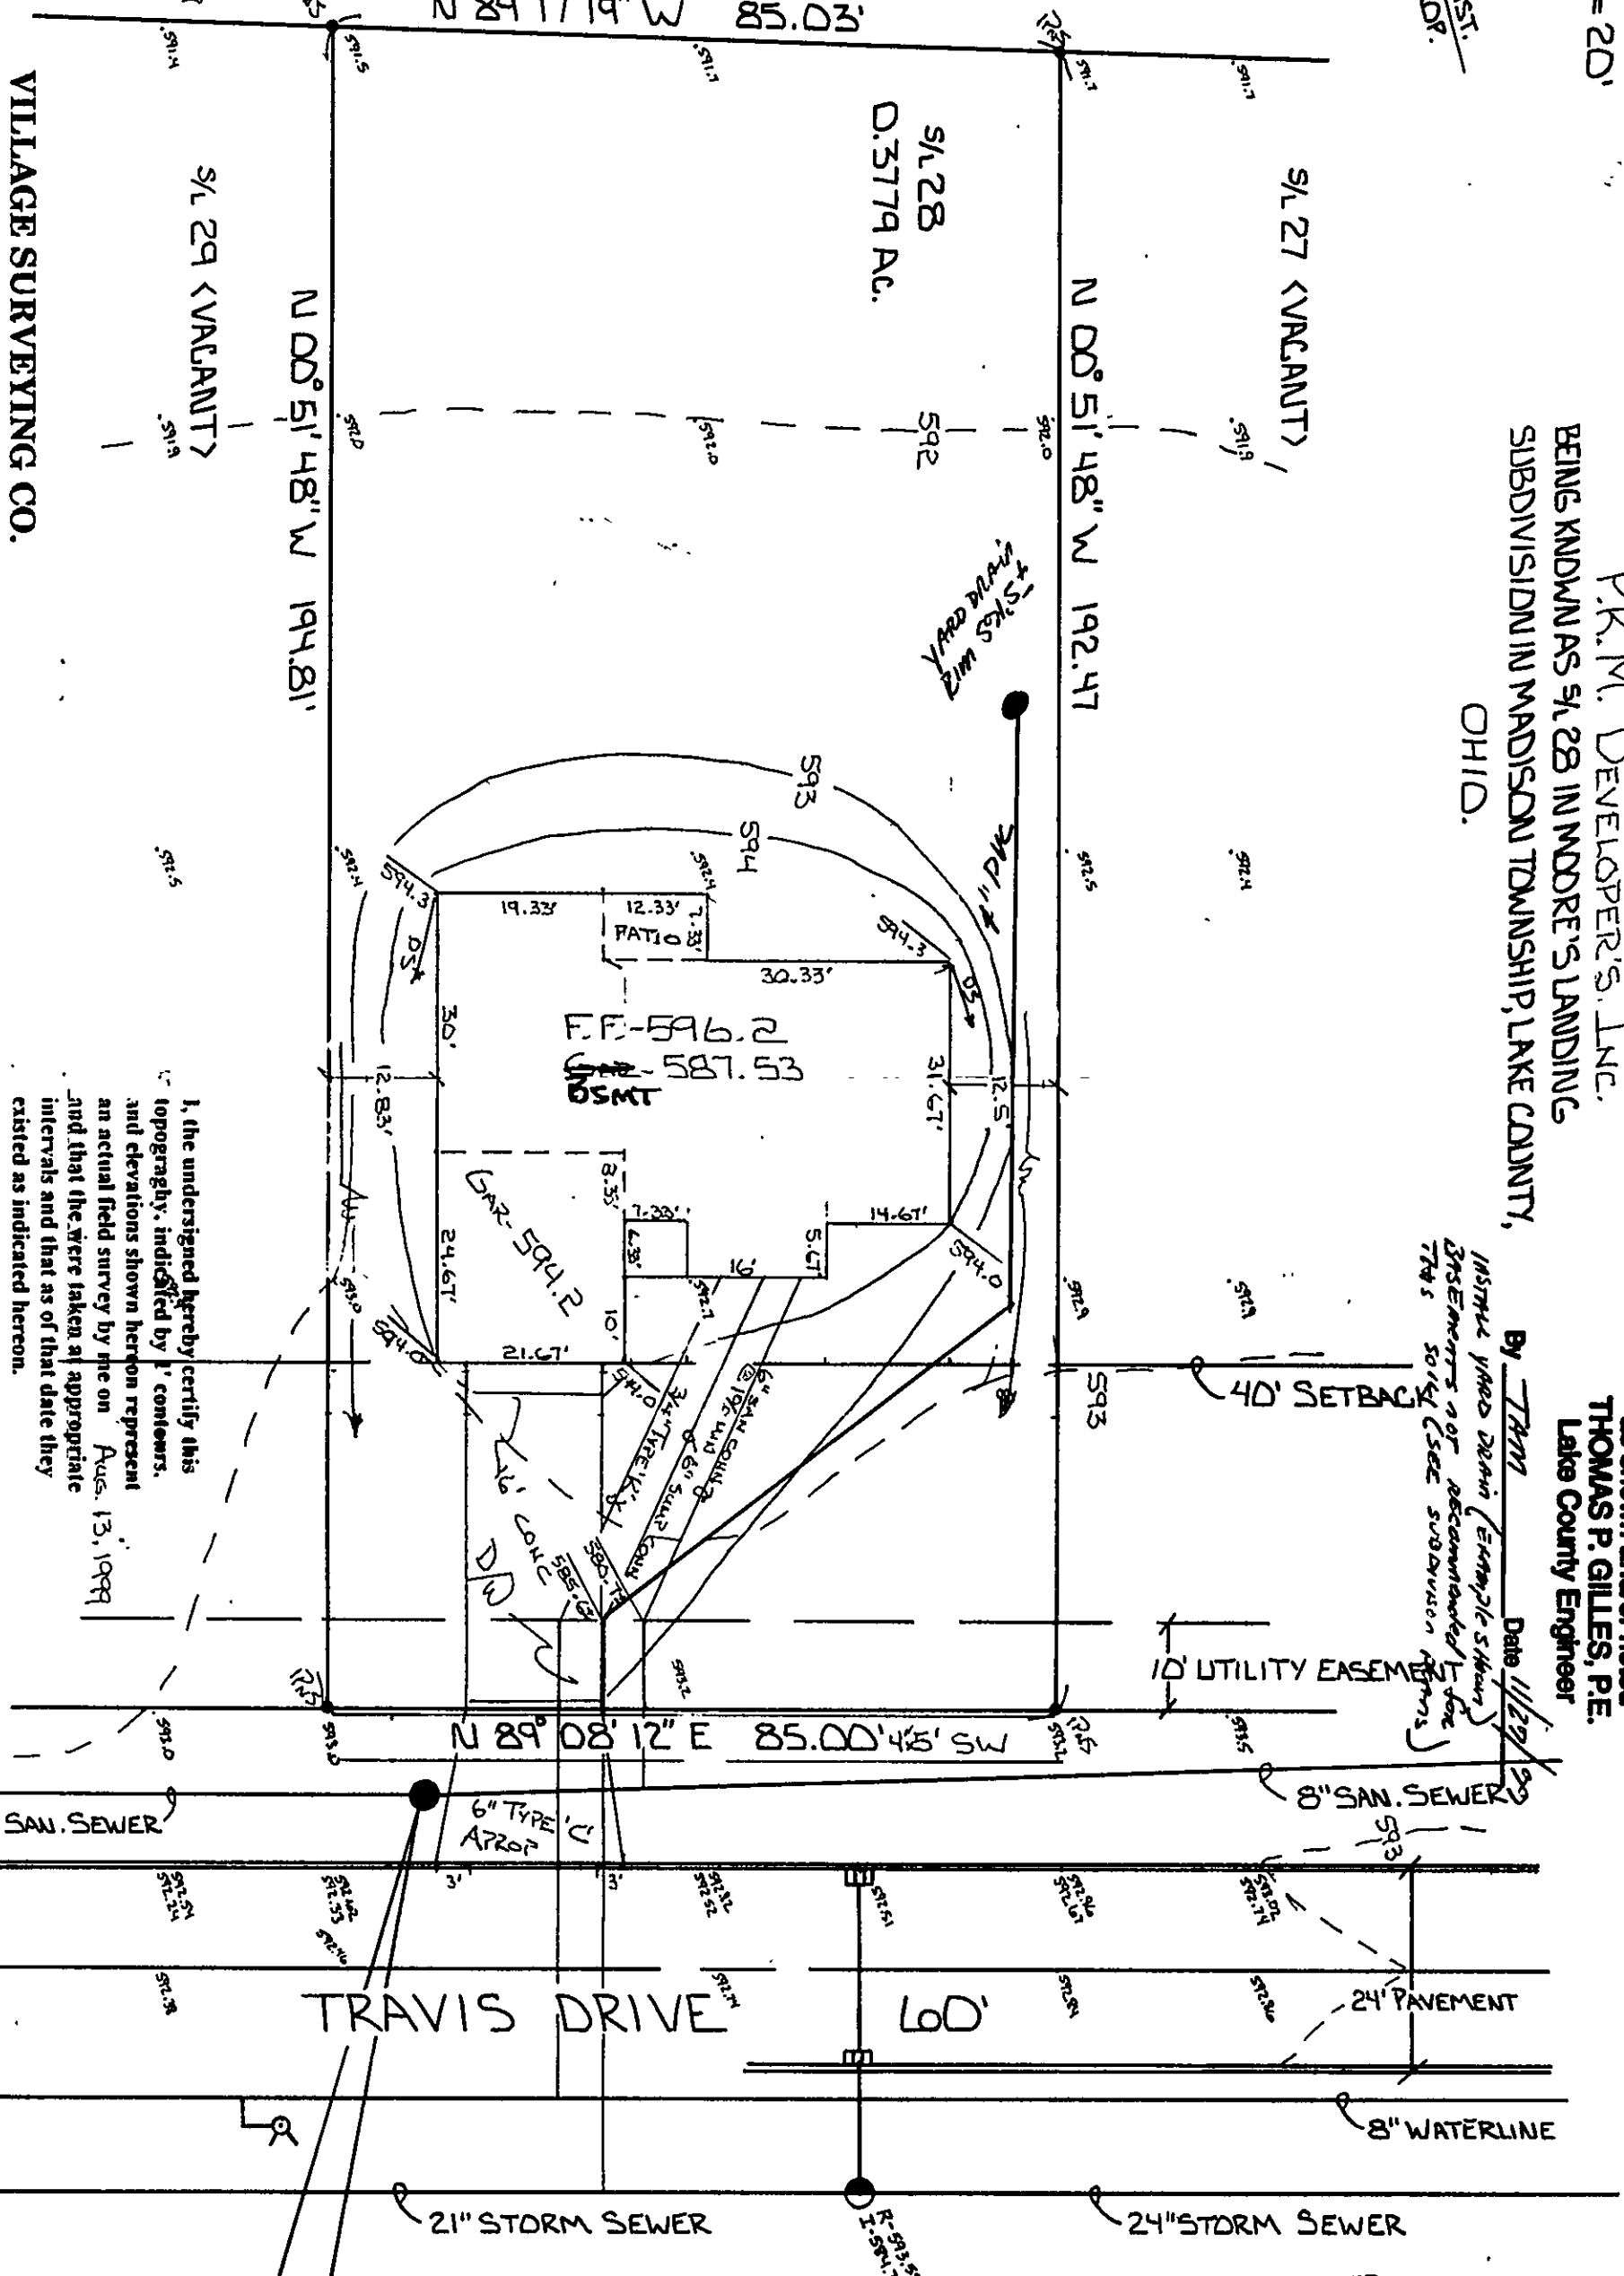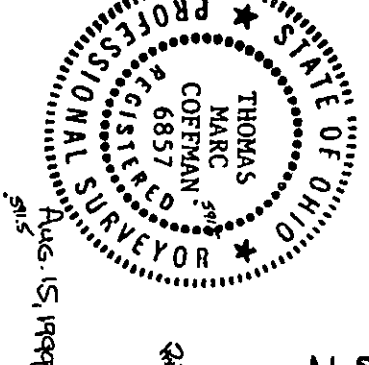

I, the undersigned hereby certify this topography, indicated by 'contours', and elevations shown hereon represent an actual field survey by me on Aug. 13, 1999 and that the same were taken at appropriate intervals and that as of that date they existed as indicated hereon.

THM
NO 6857

BENCHMARK: 593.08 N.R. IM SAN. MH
INV. 580.61

APPROVED
MADISON TOWNSHIP ZONING
DATE 11/17/99
16496

VILLAGE SURVEYING CO.
P.O. BOX 1096, FAIRPORT HARBOR, OH 44077
(440) 357-1359