


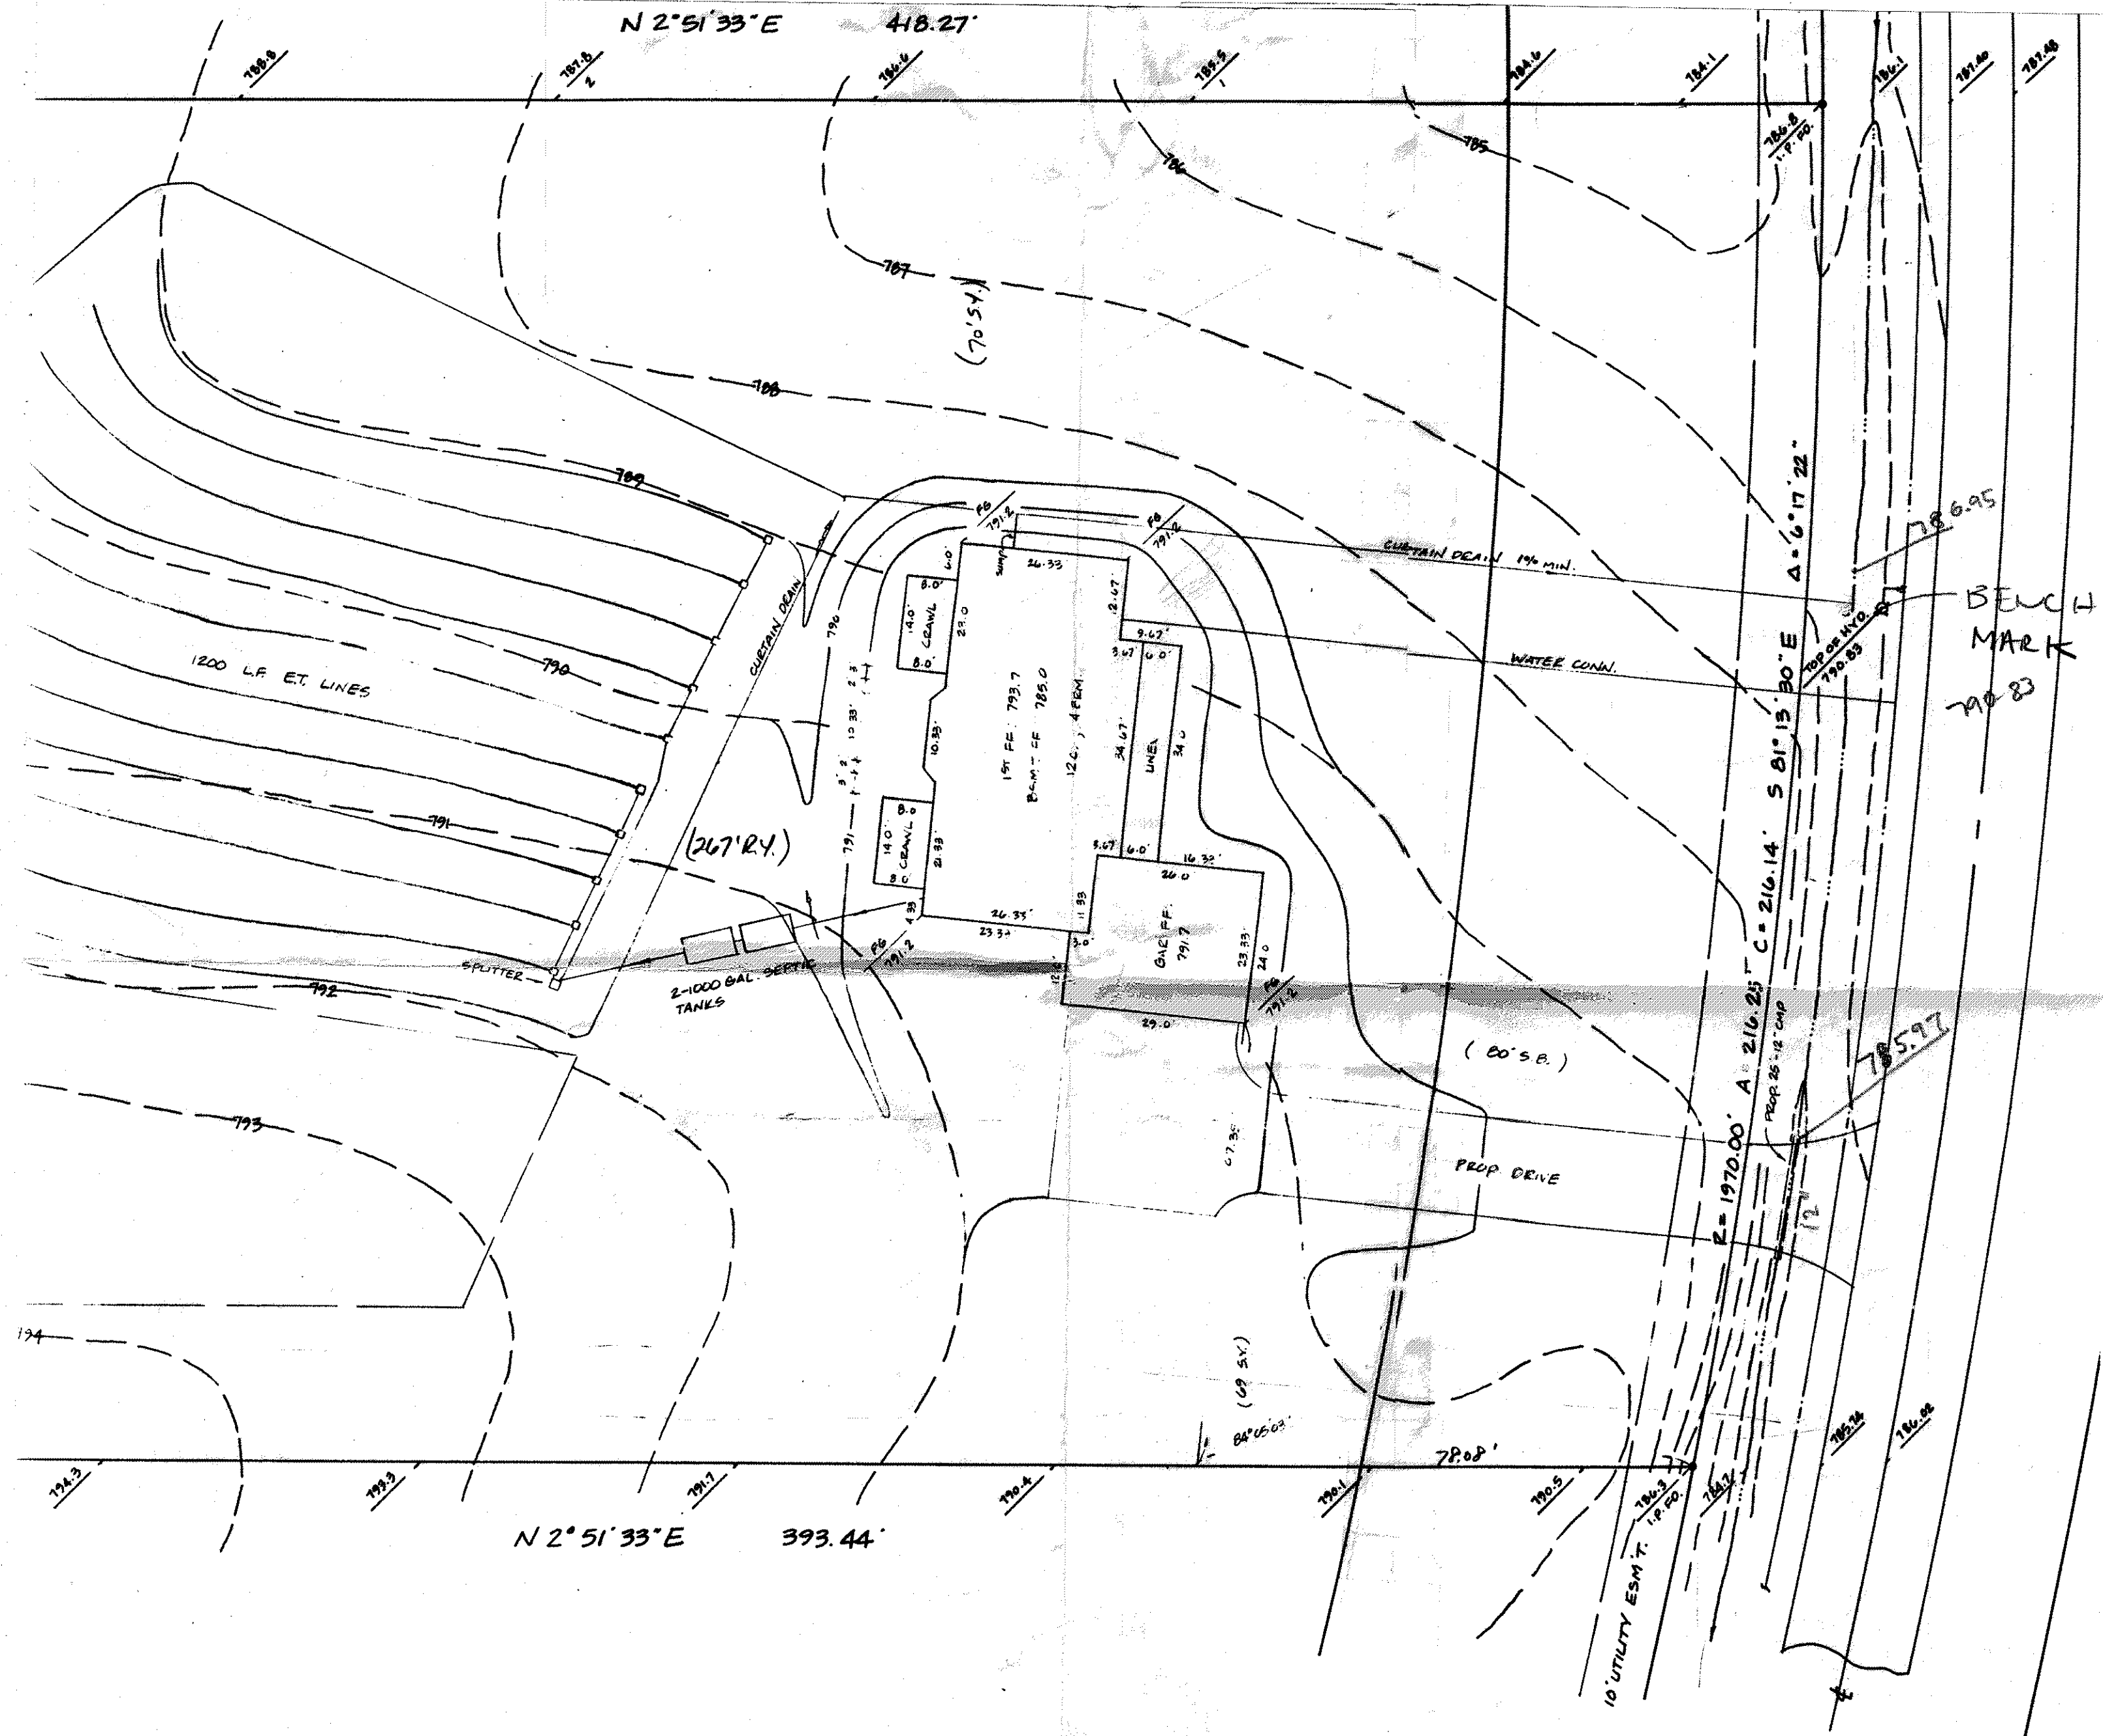

Grading Plan Approved
 and/or noted
 THOMAS P. GILLES, P.E.
 Leno County Engineer

6/14 Date 3/2/95