

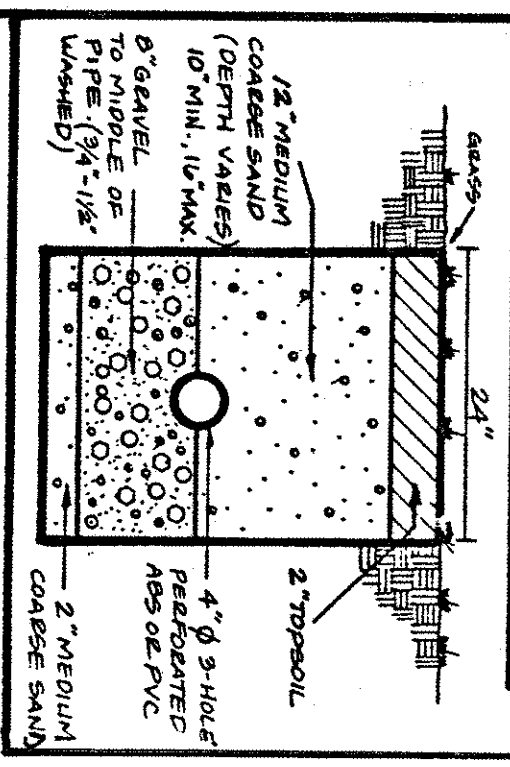


EVAPORATION - TRANSPIRATION
TRENCH CROSS SECTION

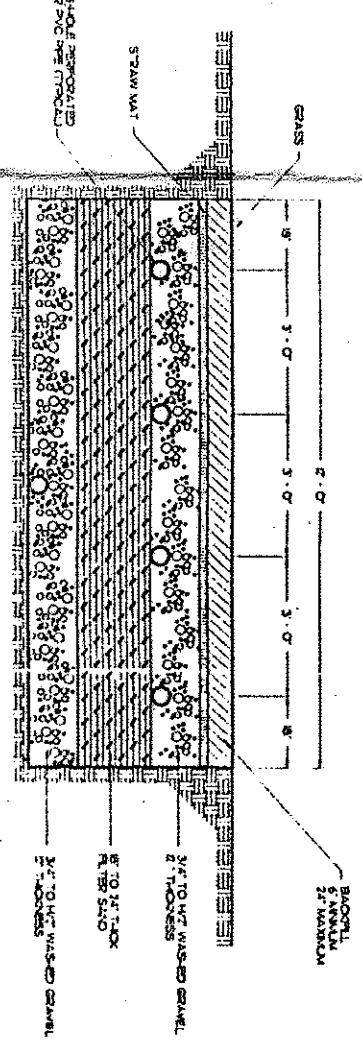

CURTAIN DRAIN
CROSS SECTION

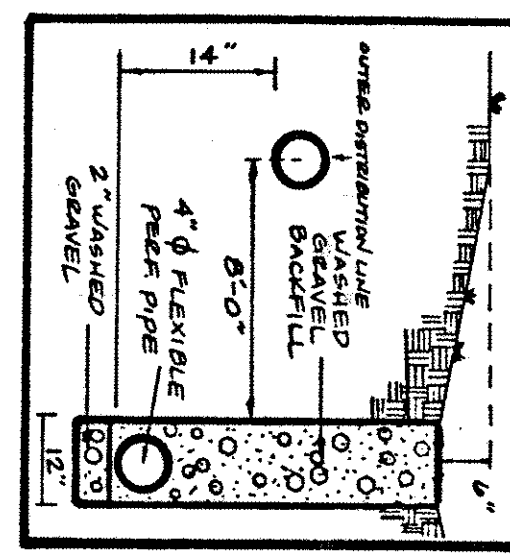

SITE PLAN

Perry Township, Lake County, Ohio

for: Franklin Poffels

ADDRESS: STREET: CITY: ZIP: LOT: TRACT: VOLUME: PAGE: SUBLOT NO.: PERMIT PARCEL NO.: STREET:

LEGEND

SANITARY MANHOLE: WATER VALVE (GAS) WATER METER (GAS) INLET OR CATCH BASIN AS BUILT ELEVATION HYDRANT EXISTING CONTOURS PROPOSED CONTOURS EXIST. ELEV. 100.0 PROP. ELEV. 100.0

REMARKS

ALL BOUNDARY DATA SHOWN WAS OBTAINED FROM IDEEDS, RECORDED SUBDIVISION PLAT OR OTHER PUBLIC RECORDS. LOCATIONS AS SHOWN OF ADJACENT WELLS AND SEPTIC TANKS OBTAINED FROM LAKE COUNTY HEALTH DEPARTMENT.

DESIGN CERTIFICATION

THIS PLAT WAS PREPARED BY ME, AND IS CORRECT TO THE BEST OF MY KNOWLEDGE AND BELIEF.

NAME: SURVEYOR REGISTRATION NO.:

CHECK LIST

NO. OF BEDROOMS: WATER MAIN SIZE, LOCATION, BEARING: SAN. SEWER SIZE & GR. LOC. SAN. MH. CAST ELEV. INV. ELEV. SAN. CONN. SIZE, LOC. DEPTH SURROUNDING OWNERS' ELEC. DIMENSIONS FIN. GR. ELEC. TIE PLY. GRADES: ANION TYPE WIDTH THICKNESS: CULVERT TYPE DIA. LENGTH: ROCK OUTCROPPINGS: ISOLATION RADII FROM WELL:

PLAN PREPARED BY:

BABCOCK • JONES & ASSOCIATES, INC. PAINESVILLE, OHIO

NO.	DATE	BY	SCALE	1" = 40'	PHONE NO.
1	10/5/85	HT			357-1811
2	11/1/85	HT			
3	11/1/85	HT			
4		CHKD.			
5		CHIEF			

"AS BUILT" CERTIFICATION

I, HEREBY CERTIFY THAT THE CIRCLED GRADES ARE EXISTING FINISH GRADES CHECKED IN THE FIELD ON 19 AND ARE CORRECT TO THE BEST OF MY KNOWLEDGE AND BELIEF.


REGISTERED SURVEYOR

78371 - T.S.C.H. - 3610

APPROVED


SIDE LINES & SET BACK PERRY TOWNSHIP ZONING PERMIT NO. 6203

ZONING INSPECTOR

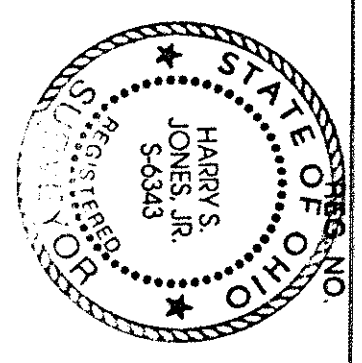

HYDRAULIC PROFILE

HORIZ: 1"=40' VERT: 1"=5'

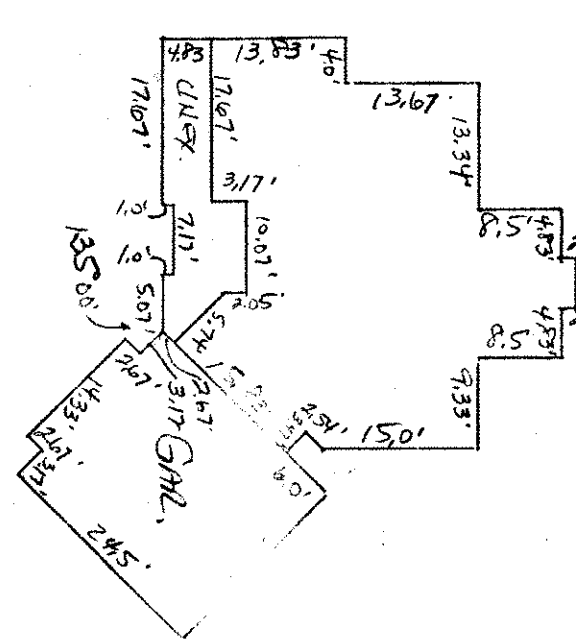

LOW YIELD WATER FIXTURES REQUIRED ON ALL: Shower Head Toilet

- A. To be brought to finished grade
- 1. Septic tank manhole covers
- 2. Splitter box cover
- 3. Distribution box cover
- B. No footer drains or downspouts to be discharged into septic tanks.
- C. All waste water to be discharged into septic tanks

Reviewed and Accepted
LAKE COUNTY GENERAL HEALTH DISTRICT
Date: 11-8-85
JOEL LUCIA, R.S., M.P.H.
Health Commissioner
BY: J. L. L. L.

Grading Plan Approved
THOMAS P. GILLES, P.E.
Lake County Engineer
BY: 61H Date: 11/19/85

TURBIDITY
DANE

THOMAS P. GILLES, P.E.
6343