


SYMBOL LEGEND	
	Iron Pin Found
	Fire Hydrant
	Water Valve

Zoning District ER-2

Front Setback 50'
Side Setback 15'
Rear Setback 15'


49.00'	14.00'	14.00'	34.00'
3 Bedroom House	1st F.F.L. 755.75	Basement	F.F.L. 747.08
Garage (Unex.)	F.F.L. 753.5		
33.00'	33.00'	22.00'	

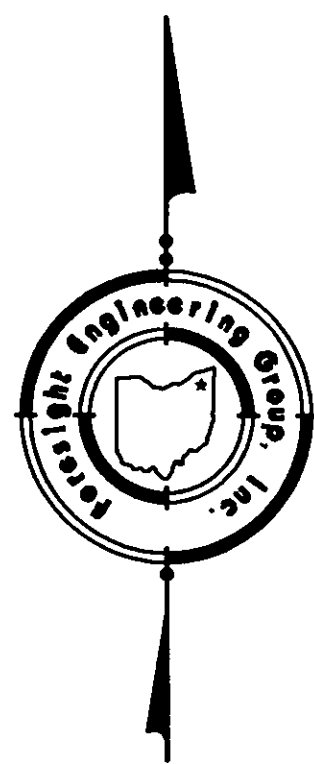

REVIEWED AND ACCEPTED
LAKE COUNTY GENERAL
HEALTH DISTRICT


Date 6/2/98 BY Dan Lal

SEWAGE DISPOSAL PERMIT MUST BE
OBTAINED BY A LAKE COUNTY LICENSED
INSTALLER BEFORE INSTALLATION IS
STARTED

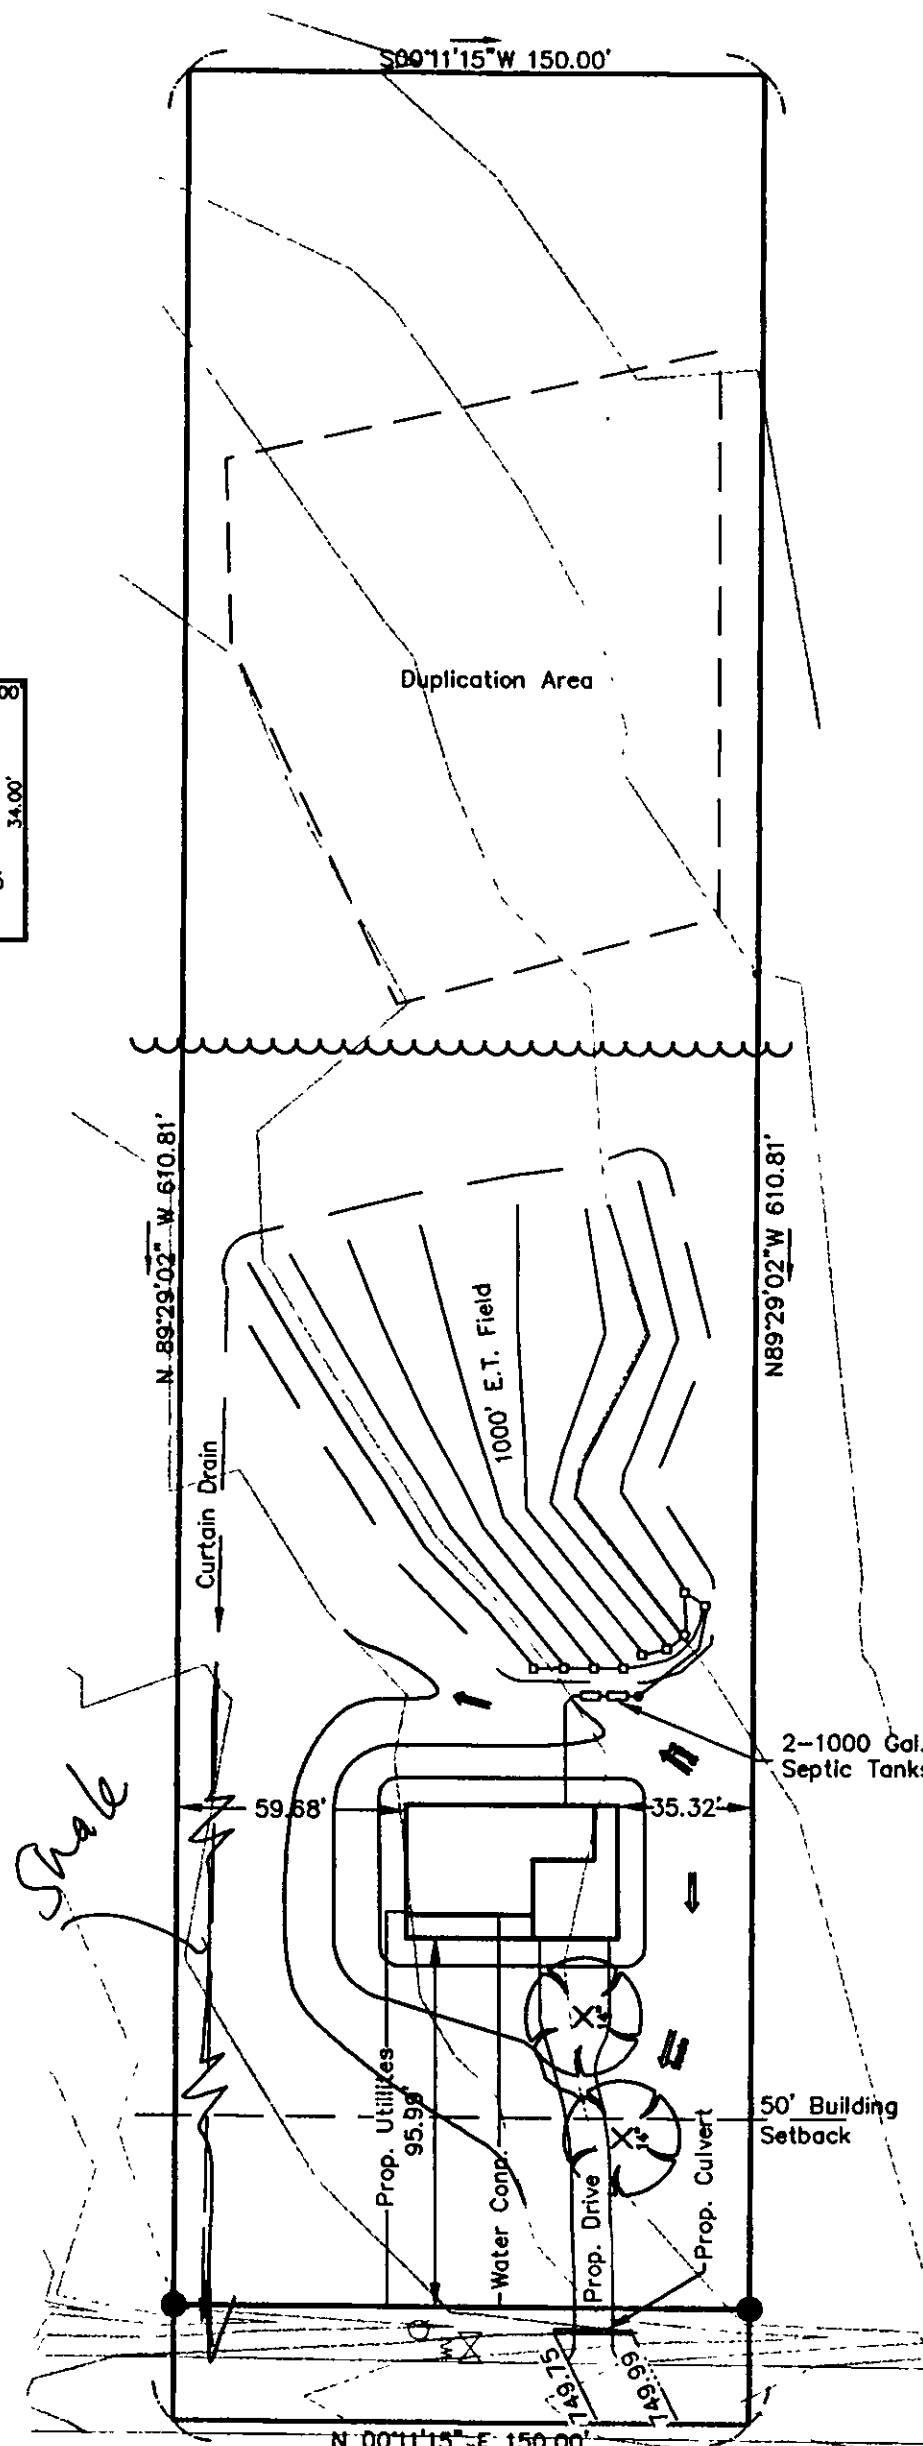


Turney Road - 60'

Grading Plan Approved
as shown and/or noted
THOMAS P. GILLES, P.E.
Lake County Engineer

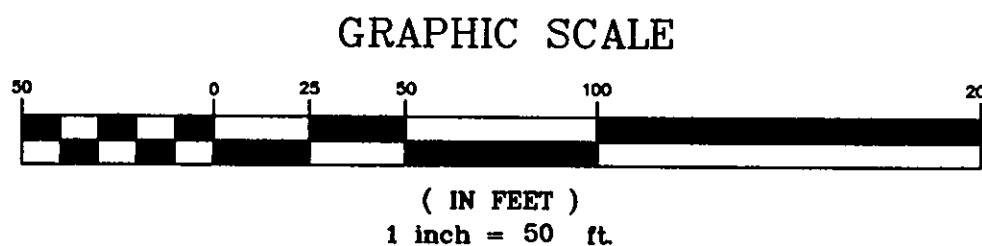


By WH Date 6.9.98
21" Drive culvert

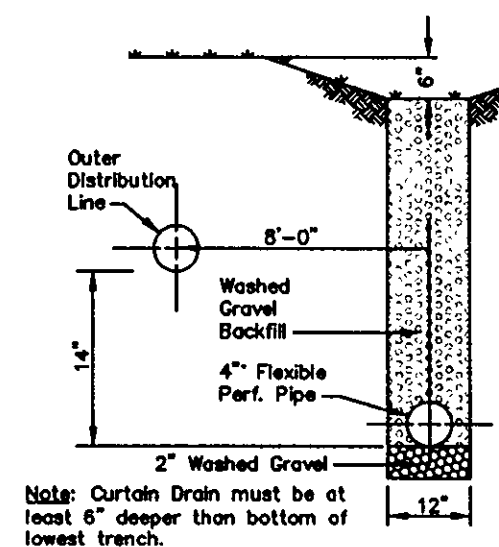

CURTAIN DRAIN CROSS SECTION
NO SCALE


I:\DETAILS\CAD\LCHD\CURDRAIN

APPROVED
SIDE LINES & SET BACK
PERRY TOWNSHIP ZONING
PERMIT NO. 6646
ZONING INSPECTOR

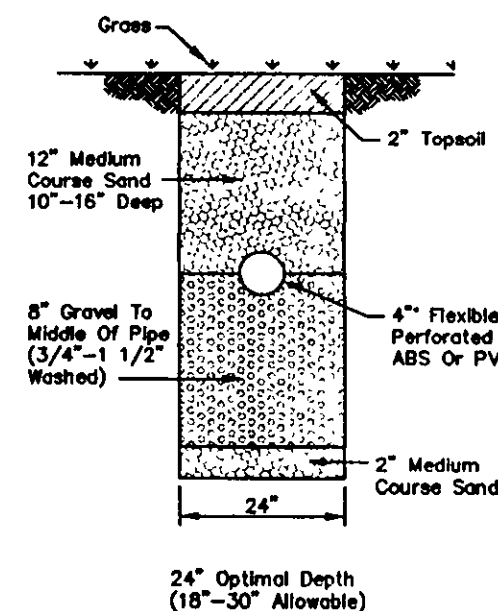

EVAPORATION-TRANSPIRATION
TRENCH CROSS-SECTION
NO SCALE

I:\DETAILS\CAD\LCHD\TRCHSECT

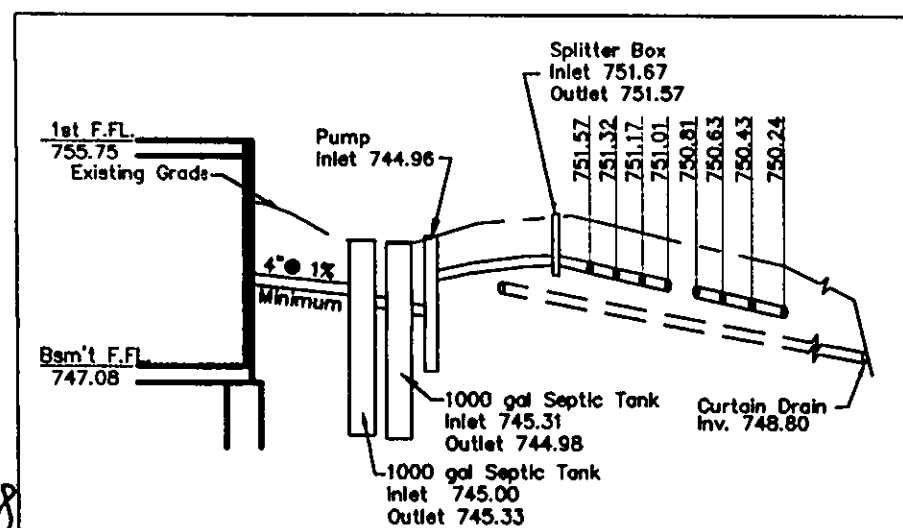

Hydraulic Profile

SITE PLAN

for : McCullough Builders
CLIENT
P.O. Box 349 Perry Ohio 44081
ADDRESS CITY STATE ZIP

SUBLOT No. SUBDIVISION NAME VOL. PAGE
LOT TRACT Perry Twp. Ohio
CITY STATE

Foresight Engineering Group

Engineers &
Surveyors

440 286-1010
440 286-1031 fax
320 Center Street, Unit F
Chardon, Ohio 44024


DESIGN CERTIFICATION

This Site Plan was prepared by Foresight Engineering Group, Inc.,
and is correct to the best of my knowledge and belief.

Stan A. R...
NAME

CHECK LIST

LOT DIMENSIONS & BEARINGS
TIE TO NEAREST STREET
SUBLOT No. (PARCEL No.)
SURROUNDING OWNERS
BUILDING DIMENSIONS
SETBACK, SIDEYARD, REARYARD
FINISH GRADES
DRIVE & APRON TYPE, WIDTH, THICKNESS
SIDEWALK TYPE, WIDTH, THICKNESS
CULVERT TYPE, DIAM., LENGTH
WATER MAIN SIZE, LOCATION
SAN. SEWER SIZE, % GRADE, LOC.
SAN. MH. CAST. ELEV., INV. ELEV.
SAN. CONN. SIZE, % GRADE, LOC.
STORM SEWER SIZE, % GRADE, LOC.
STORM MH. CAST. ELEV., INV. ELEV.
PAVT TYPE, GRADE, CURBS
GAS LINE LOC., SIZE
SEPTIC SYSTEM & DUPLICATION
WELL LOCATION & ISOLATION RADIUS

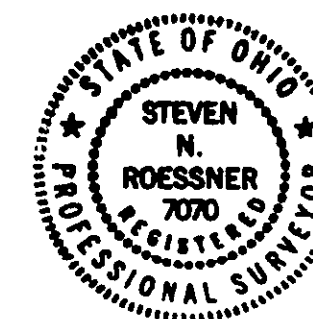

STATE SEAL

"AS BUILT" CERTIFICATION

I hereby certify that the circled information is existing as
obtained on the site _____ 19____ and is
correct to the best of my knowledge and belief.

NAME

SCALE : 1" = 50

FILE NAME:
I:\Mcc19804\Turney2.Dwg

DATE : May 12, 1998

BENCHMARK: Fire Hydrant (Top of Stem) = 752.77

"I, the undersigned hereby certify that this topography, indicated by 6", 1' or 2'
contours, and the elevations shown hereon represent an actual field survey made
by Foresight Engineering Group, Inc. on the 5 day of May
1998 and that the elevations were taken at appropriate intervals and
that as of that date they existed as indicated hereon."

Stan A. R...
NAME



CALL TOLL FREE 800-362-2764
OHIO VALUES PROTECTION SERVICE

EXISTING UNDERGROUND UTILITIES NOTES:

The location both horizontal and vertical of the underground utilities
shown hereon, have been obtained by a diligent and comprehensive
search of available records. Verification by field observation, has been
conducted where practical. However, Foresight Engineering Group, Inc.
does not guarantee the completeness nor accuracy thereof.