



SITE PLAN FOR JOE KOZLOWSKI

BEING SUBLOT NO. 4 OF THE PROPOSED
TURNKEY ROAD SUBD. IN THE TOWNSHIP OF
PERRY COUNTY OF THE STATE OF OHIO

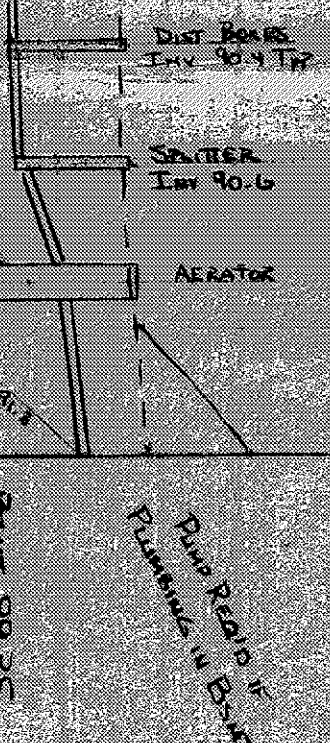

Reviewed and Accepted
LAKE COUNTY GENERAL HEALTH DISTRICT
5-3-90
JUDITH L. LUTHER, R.S., M.P.H.
Health Commissioner
Dr. David B. Jones

AP O'ED
SIDE LIN & ET BACK
PERRY TO SUE ZONING
PERMIT NO. 4382
ZONING INSPECTOR, Don R.

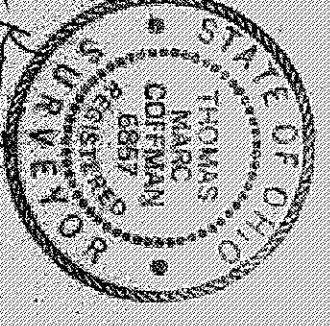

BENCHMARK-100.00 (LASSCHEN)
TOP BOLT HYDRAUNT 4581 TURNKEY RD.

- A. To be brought to finished grade
 1. Septic tank manhole covers
 2. Spillier box cover
 3. Distribution box cover
- B. No more drains or downspouts to be discharged into septic tanks
- C. All waste water to be discharged into septic tanks

LOW YIELD WATER
FIXTURES REQUIRED
ON ALL
Shower Head
Toilet

SEALING MATERIAL PERMIT MUST BE
OBTAINED BY A LAKE COUNTY LICENSED
SEALER BEFORE INSTALLATION IS
STARTED

VILLAGE SURVEYING Co.
202 Third St. Fairport Harb. Ct 44077
(216) 357-1394

Grading Plan Approved
as shown and/or noted
THOMAS P. GILLES, P.E.
Lake County Engineer
GJH
Date 5/4/90
3 M. Coffman P.E.