

SOUTHERLY 160'

HYDRAULIC PROFILE

SCALES

HORIZONTAL - 1" = 50'
VERTICAL - 1" = 5'


EXISTING GROUND
PROPOSED GROUND

NOTE
IN EVENT OF INITIAL SYSTEM FAILURE, THE
AREA BETWEEN EXISTING LEACH FIELD
LINES WILL BE UTILIZED FOR DUPLICATION AREA.

Grading Plan Approved
As shown and/or noted
By **THOMAS P. GILLES, P.E.**
Lake County Engineer

EASTERLY 250'

WESTERLY 250'

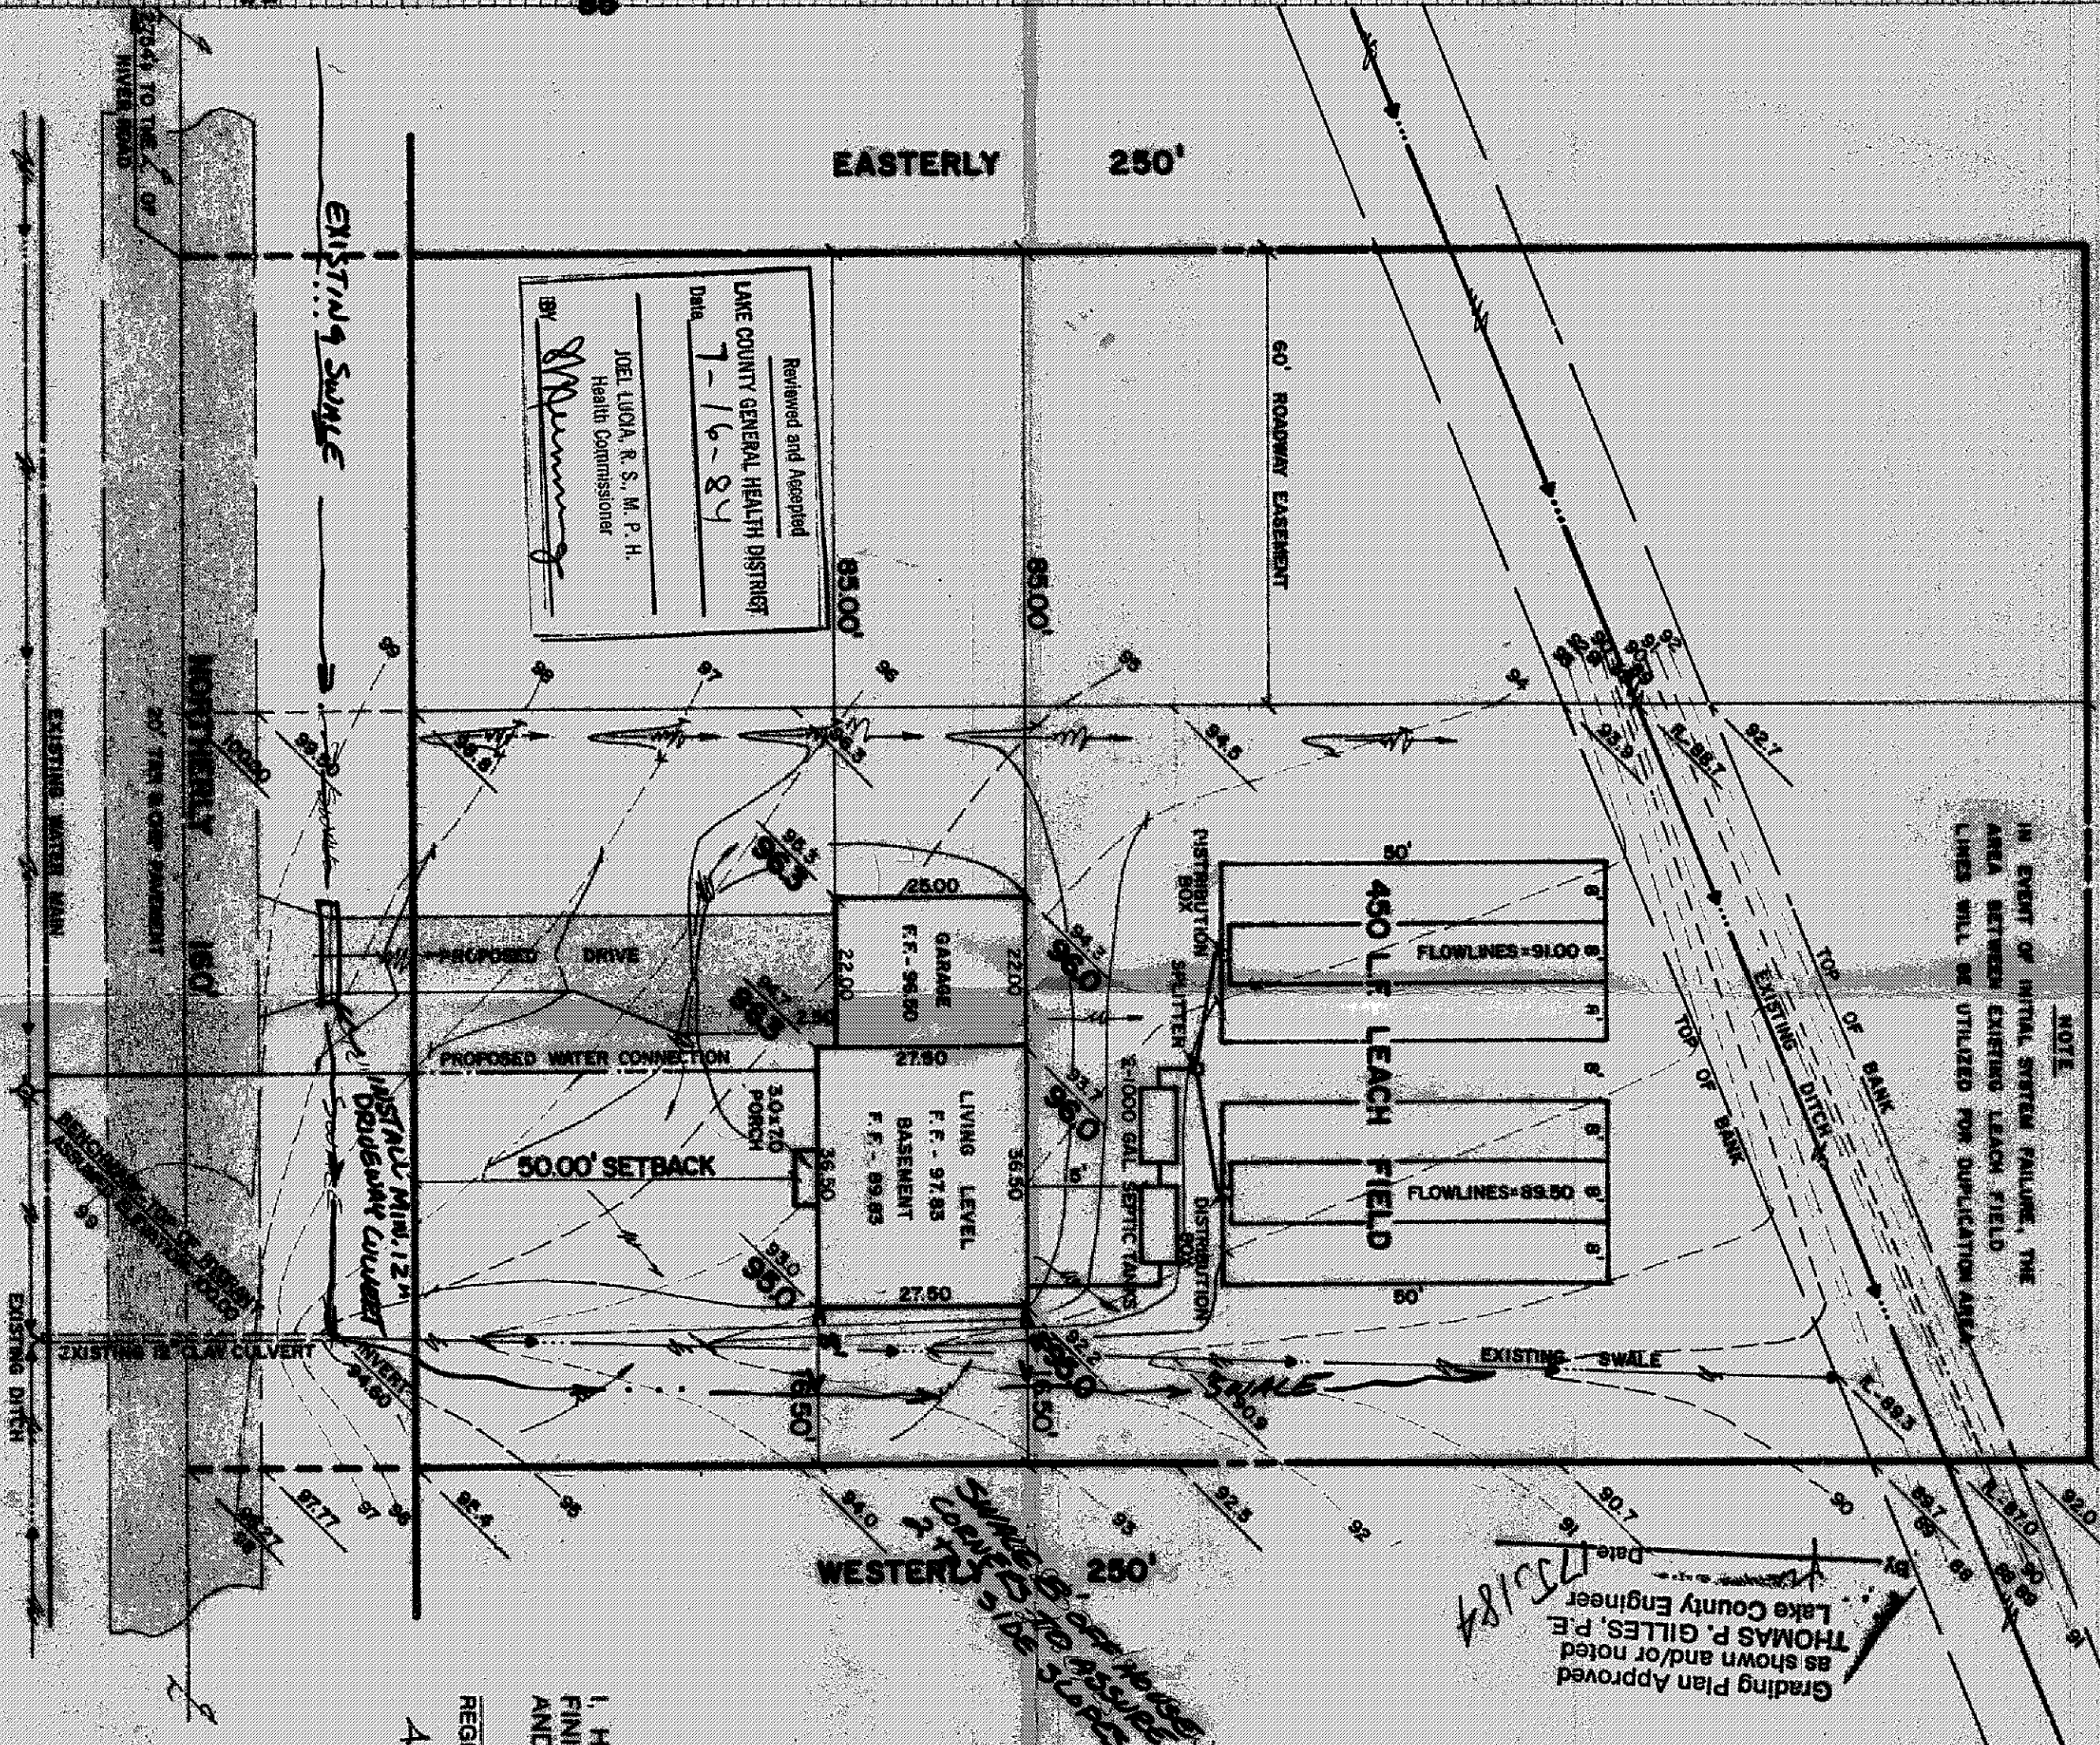

TURNERY ROAD 60'

REVISED

DATE 4/12/87 BY C.C.

SITE PLAN

PERRY LAKE COUNTY, OHIO

for: **J. PARKER & ASSOCIATES, INC.**
CLIENT
4568 TURNERY ROAD PERRY 44081
ADDRESS CITY

SUBDIVISION	NAME	LOT 42	TRACT 1020
VOL. - PG.			PAGE 1020
SUBLOT NO.	STREET	NEW TOWN	TURNERY ROAD

LEGEND

SANITARY MANHOLE	WATER VALVE (GAS)
STORM MANHOLE	WATER METER (GAS)
INLET OR CATCH BASIN	AS BUILT ELEVATION
HYDRANT	INDICATES DIRECTION OF SURFACE DRAINAGE
EXISTING CONTOURS	
PROPOSED CONTOURS	
EXIST. ELEV.	PROJ. ELEV.

REMARKS

ALL BOUNDARY DATA SHOWN WAS OBTAINED FROM (DEEDS, RECORDED
SUBDIVISION PLAT OR OTHER PUBLIC RECORDS)
LOCATIONS AS SHOWN OF ADJACENT WELLS AND SEPTIC TANKS OBTAINED FROM
LAKE COUNTY HEALTH DEPARTMENT

DESIGN CERTIFICATION

THIS PLAN WAS PREPARED BY ME, AND IS CORRECT
TO THE BEST OF MY KNOWLEDGE AND BELIEF.

NAME SURVEYOR REGISTRATION NO.

CHECK LIST

NO. OF BEDROOMS	WATER MAIN SIZE LOCATION
DIMENSIONS	SEWER SIZE & GR. LOC.
BLDG. NO.	MAN. HOLE CAST. ELEV. INV. ELEV.
BLDG. NO.	BLDG. NO. CAST. ELEV. INV. ELEV.
BLDG. NO.	BLDG. NO. CAST. ELEV. INV. ELEV.
PLAN PREPARED BY:

DEBEVEC • SALO & ASSOCIATES, INC.
125 E. ERIE ST. PAINESVILLE, OHIO

NO.	DATE	BY	SCALE	PHONE NO.
1	7/12/84	BY	1" = 20'	352-9290
2		CHK'D	DATE	DRAWING NO.
3		APPRO.	JULY 3, 1984	6172

"AS BUILT" CERTIFICATION

I, HEREBY CERTIFY THAT THE CIRCLED GRADES ARE EXISTING
FINISH GRADES CHECKED IN THE FIELD ON 7/19/84
AND ARE CORRECT TO THE BEST OF MY KNOWLEDGE AND BELIEF.

REGISTERED SURVEYOR

REG. NO.


4610 Turney Rd

APPROVED

SIDE LINES & SET BACK
PERRY TOWNSHIP ZONING
PERMIT NO. 7180

ZONING INSPECTOR

APPROVED

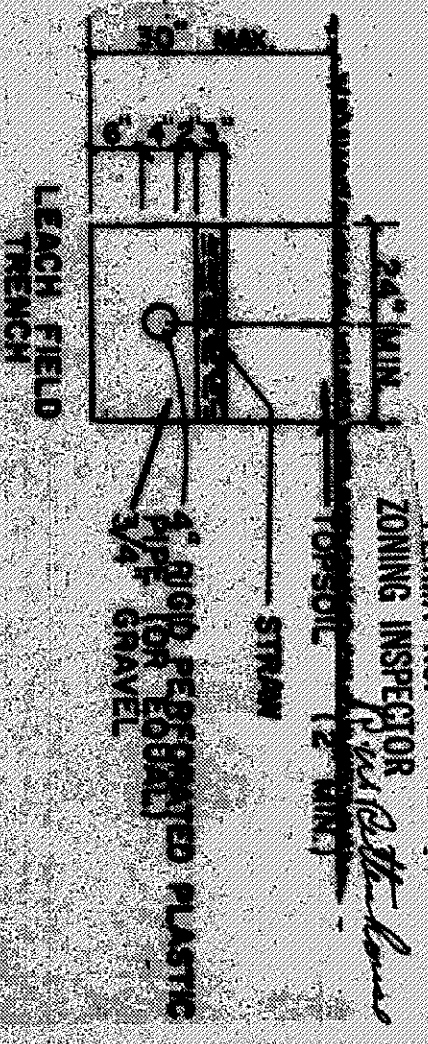

TYPICAL SECTION
SCALE 1/2" = 1'-0"