

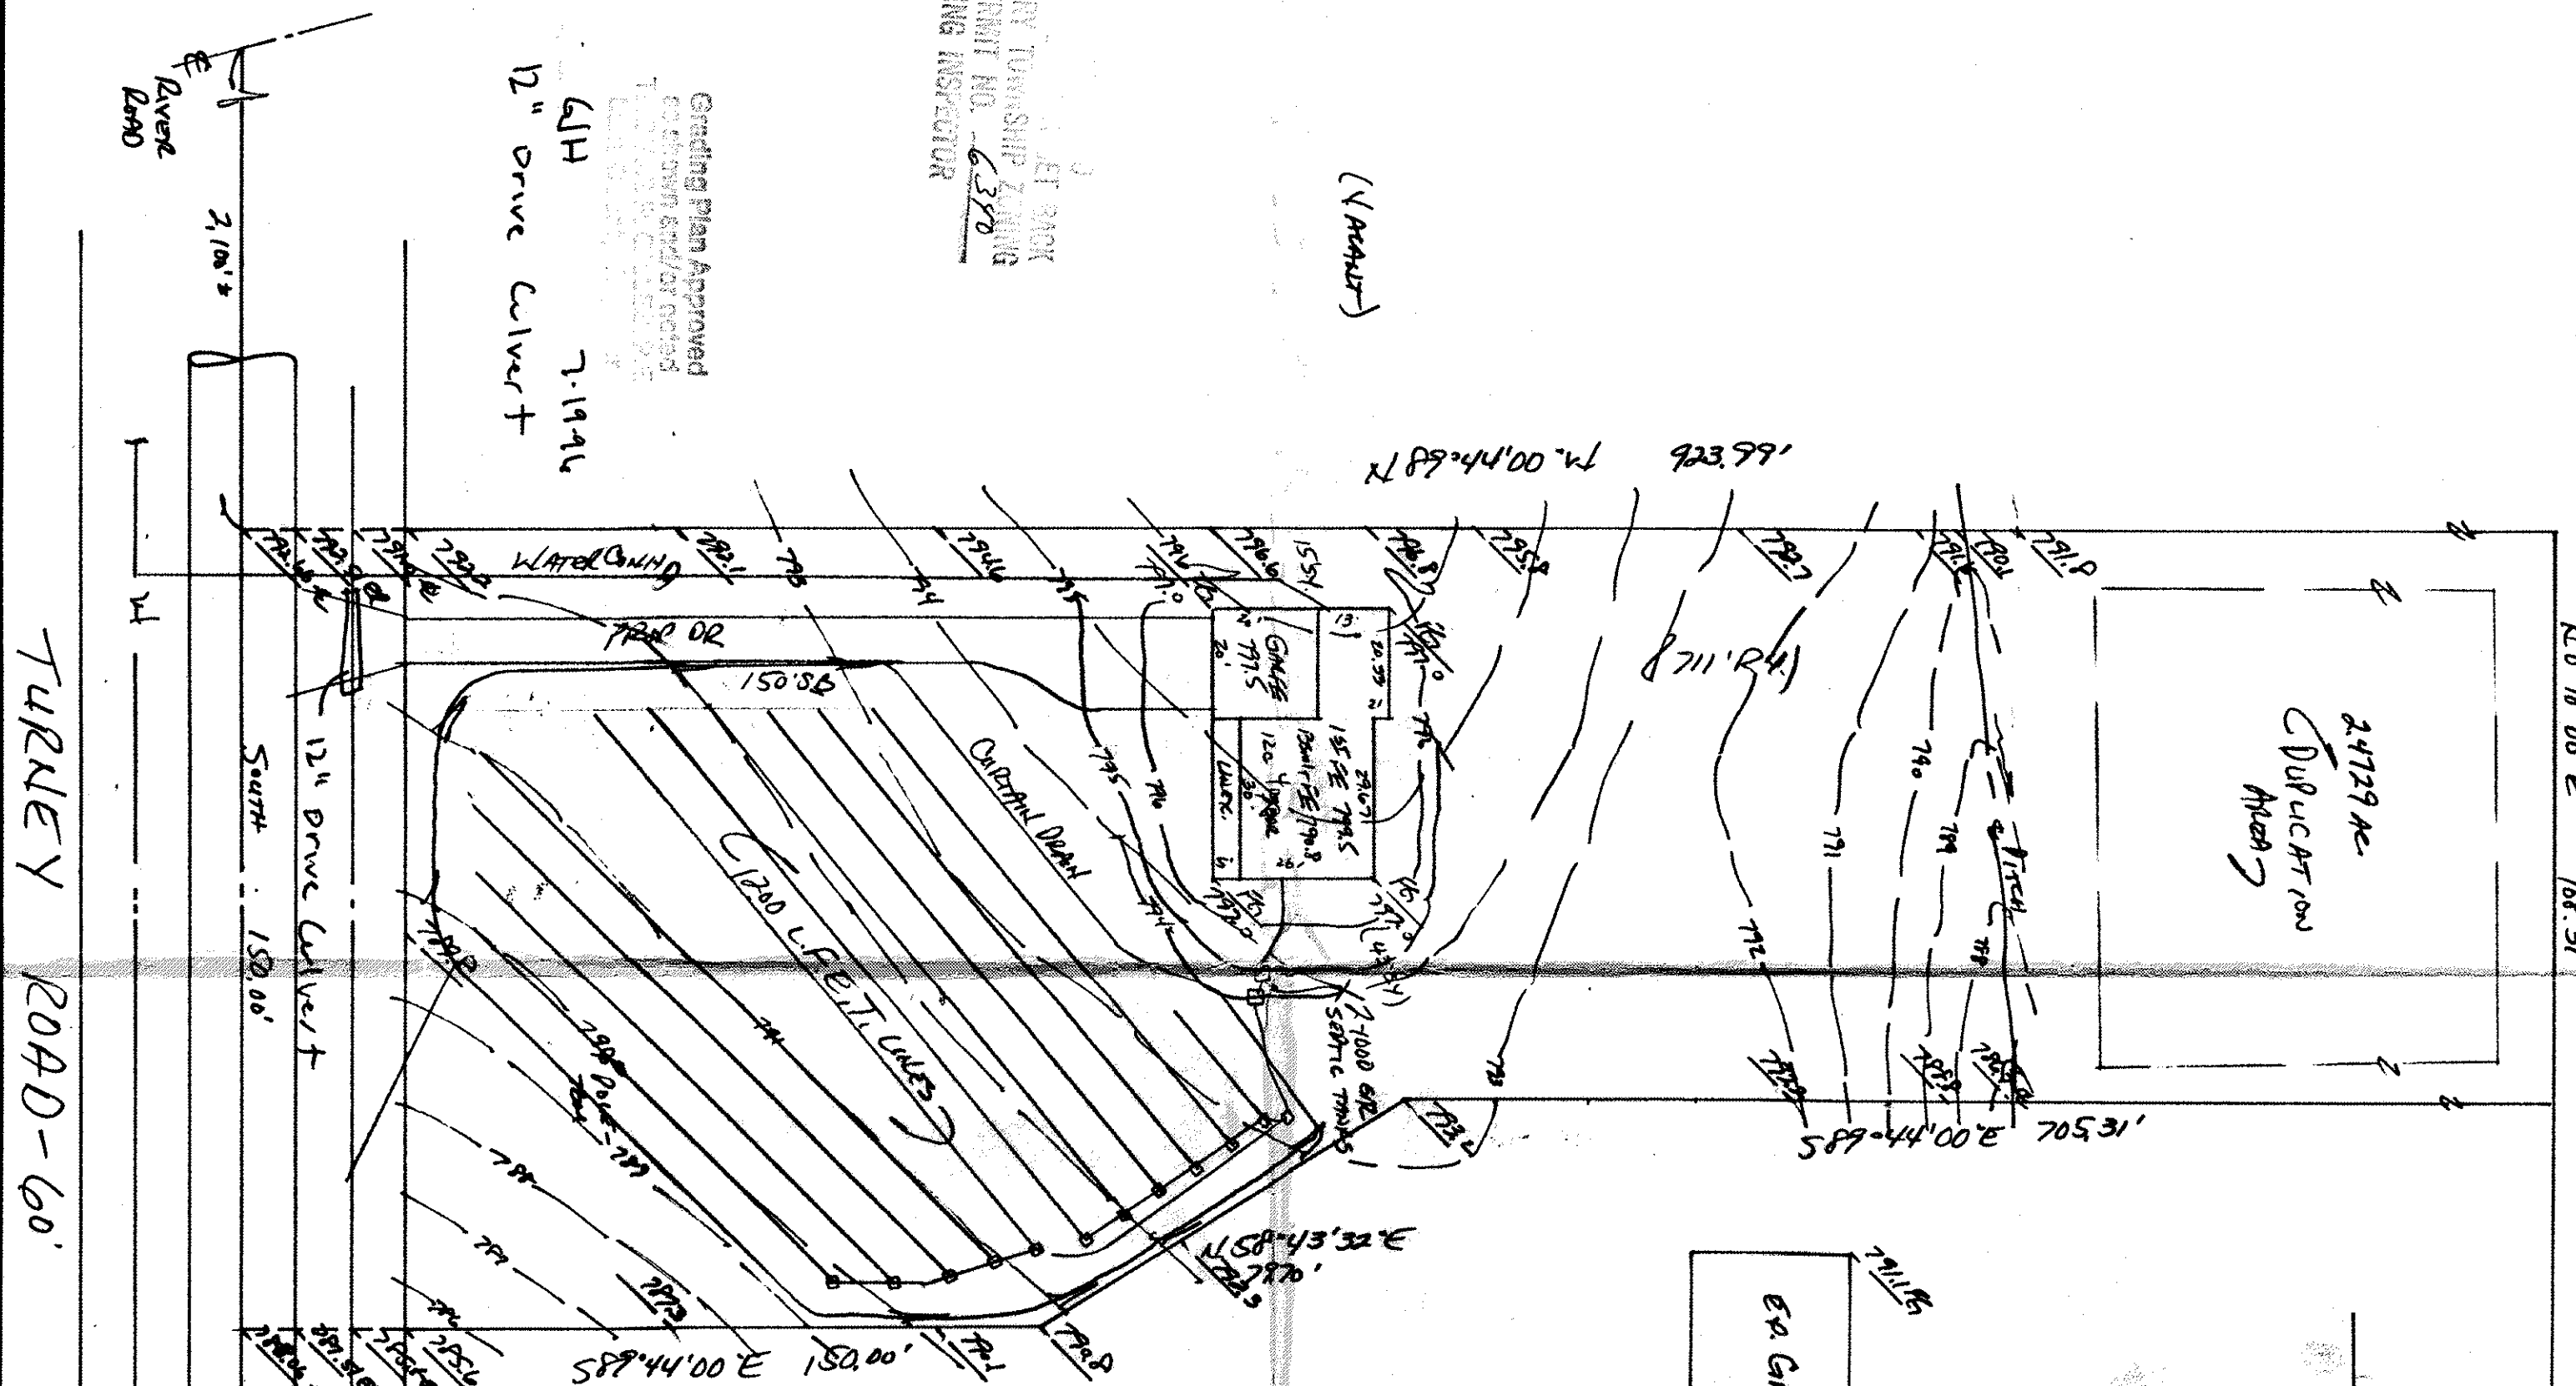
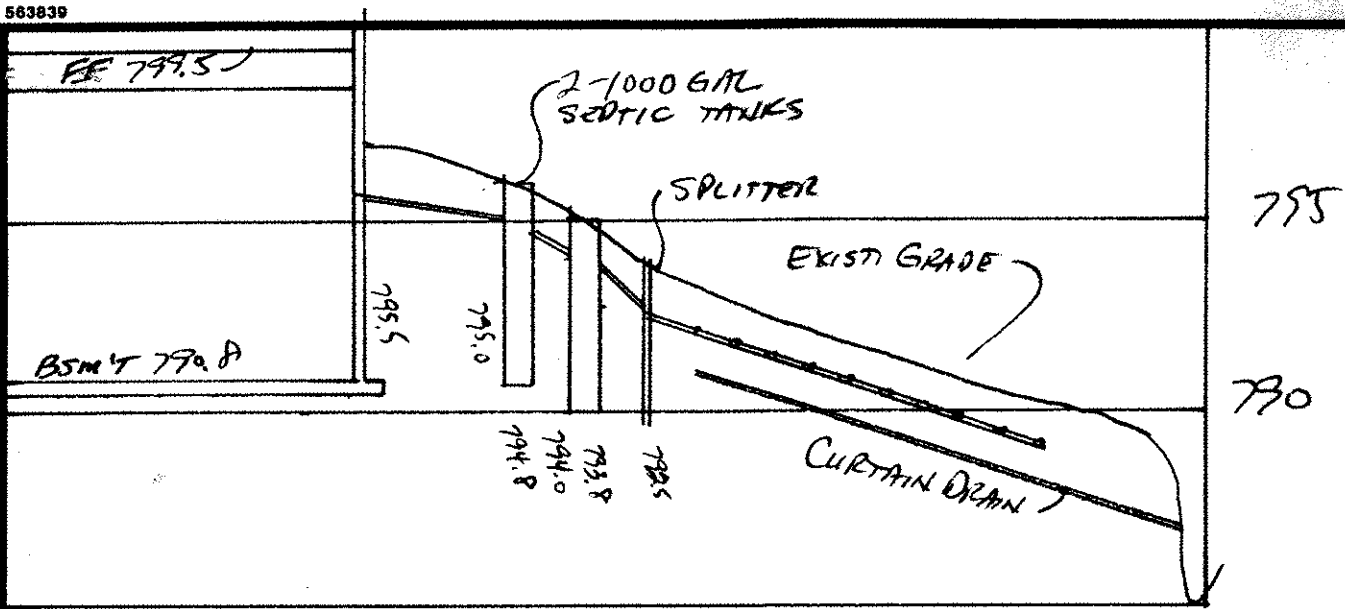
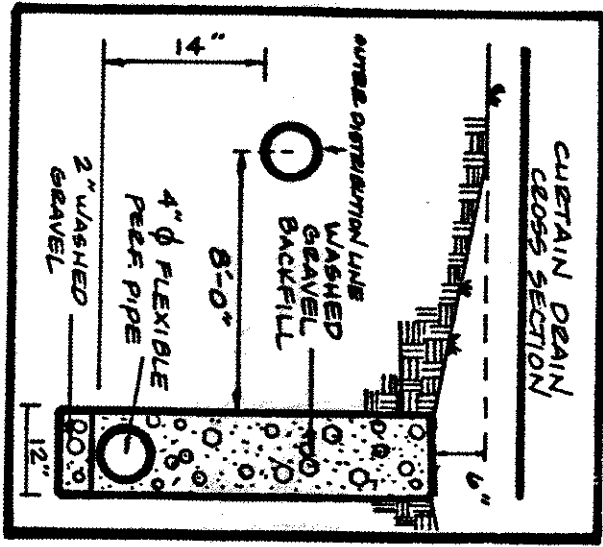


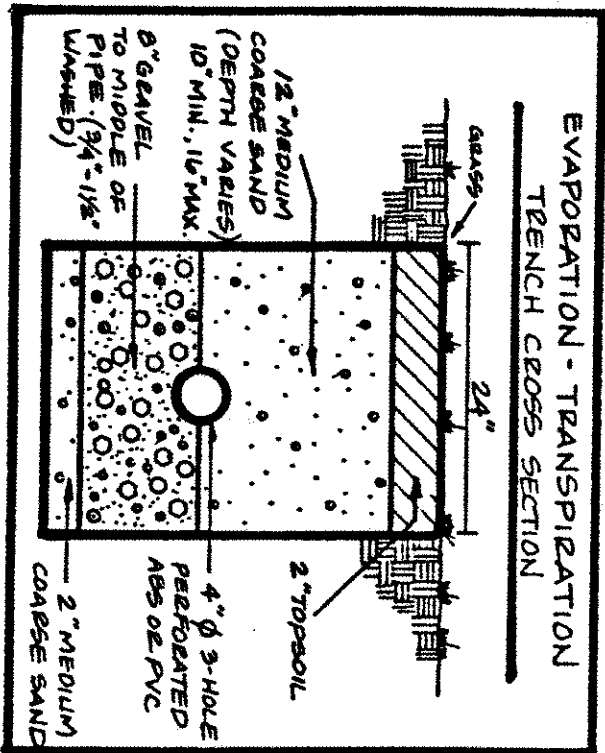

TURLEY ROAD - 60'

LET JOHN
PERRY TOWNSHIP ZONING
PERMIT NO. 6380
ZONING INSPECTOR

Grading Plan Approved
12" Drive Culvert
7-19-96

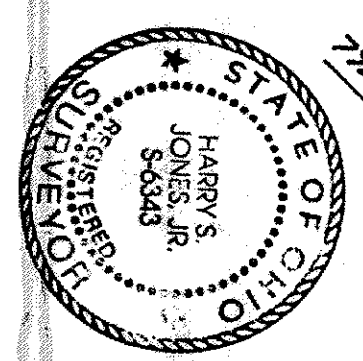

SINCE DISPOSAL PERMITS MUST BE
OBTAINED BY A LAKE COUNTY LICENSED
INSTALLER BEFORE INSTALLATION
STARTED.

- A. To be brought to unexcused SURVEYOR
1. Septic tank manhole covers
 2. Splitter box cover
 3. Distribution box cover
 4. 12" footer drains or downspouts
 5. To be discharged into septic tanks
 6. All waste water to be discharged into septic tanks

TBM - 14" SET IN POLE
ON 1/2" GRADE OF THIS LOT
ELEV. = 791.00

LOW YIELD WATER
FIXTURES REQUIRED
ON ALL:
Shower Head
Toilet

Reviewed and Accepted
LAKE COUNTY GENERAL HEALTH DISTRICT
Date: 6-18-96
JOEL LYON, R. S. M. P. H.
Health Commissioner
BY: J. L. Lister

"I, the undersigned hereby certify that this topography indicated by 6", 1" or 2" contours, and elevations shown hereon represent an actual field survey made by me on the 11th day of June, 1996, and that the elevations were taken at appropriate intervals and that as of that date they existed as indicated hereon."

Name: Harry Jones
Reg. No. 6343

"AS BUILT" CERTIFICATION
I, HEREBY CERTIFY THAT THE CIRCLED GRADES ARE EXISTING
FINISH GRADES CHECKED IN THE FIELD ON 19
AND ARE CORRECT TO THE BEST OF MY KNOWLEDGE AND BELIEF.

PLAN PREPARED BY:
BABCOCK • JONES & ASSOCIATES, INC.
PAINESVILLE, OHIO

NO.	DATE	BY
1		
2		
3		
4		
5		

DRAWN BY: [Signature]
CHECKED BY: [Signature]
DATE: 6/13/96
SCALE: 1" = 30'
PHONE NO.: 357-1811
DRAWING NO.: 96-173

DESIGN CERTIFICATION
THIS PLAN WAS PREPARED BY ME, AND IS CORRECT
TO THE BEST OF MY KNOWLEDGE AND BELIEF.
NAME: [Signature]
SURVEYOR REGISTRATION NO. 6343

CHECK LIST

NO. OF BEDROOMS: _____
DIMENSIONS: _____
BEARINGS: _____
TIE TO NEAREST STREET: _____
SUBJECT NO. PARCEL NO.: _____
SURROUNDING OWNERS: _____
BLDG. DIMENSIONS: _____
BLDG. TIES: _____
APPROX. TYPE WIDTH THICKNESS: _____
SIDEWALK TYPE WIDTH THICKNESS: _____
CULVERT TYPE DIA. LENGTH: _____
ROCK OUTCROPPINGS: _____
WATER MAIN SIZE: _____
SAN. SEWER SIZE: _____
SAN. MH. CAST. ELEV. INV. ELEV.: _____
SAN. CONN. SIZE: _____
STORM SEWER SIZE: _____
STORM MH. CAST. ELEV. INV. ELEV.: _____
PAV'T TYPE GRADE CURBS: _____
GAS LINE LOC. SIZE PRESSURE: _____
SEPTIC TANK LOCATION & DUPLICATION AREA: _____
WELL LOCATION: _____
ISOLATION RADIUS FROM WELL: _____

REMARKS

ALL BOUNDARY DATA SHOWN OBTAINED FROM IDEEDS, RECORDED
SUBDIVISION PLAT OR OTHER PUBLIC RECORDS
LOCATIONS AS SHOWN OF ADJACENT WELLS AND SEPTIC TANKS OBTAINED FROM
LAKE COUNTY HEALTH DEPARTMENT

LEGEND

SANITARY MANHOLE: WATER VALVE (GAS):
STORM MANHOLE: WATER METER (GAS):
INLET OR CATCH BASIN: AS BUILT ELEVATION:
HYDRANT:
EXISTING CONTOURS:
PROPOSED CONTOURS:
EXIST. ELEV.:
PROP. ELEV.:
INDICATES DIRECTION OF SURFACE DRAINAGE:

SITE PLAN
MADISON TOWNSHIP, LAKE COUNTY, OHIO
FOR: SHADLE BUILDERS
CLIENT: OWNER
ADDRESS: _____ STREET: _____ CITY: _____ ZIP: _____

SUBDIVISION: _____ NAME: _____ LOT: 32 TRACT: 1010
VOL. - PG.: _____ SUBLOT NO.: _____ STREET: _____ PERM. PARCEL NO.: _____
DATE: 6-18-96 PAGE: 1010
BY: J. L. Lister