

SITE PLAN

PERRY TOWNSHIP, LAKE COUNTY, OHIO

for: JAMES HAGLE

CLIENT

ADDRESS STREET CITY ZIP

SUBDIVISION VOL. - PG. NAME TRACT LOT 31 420 1000 3A-77-13 TURNER ROAD

SUBLOT NO. STREET PERM. PARCEL NO. TURNER ROAD

LEGEND

SANITARY MANHOLE WATER VALVE (GAS) WATER METER (GAS) AS BUILT ELEVATION INLET OR CATCH BASIN HYDRANT EXISTING CONTOURS PROPOSED CONTOURS EXIST. ELEV. 100.0 100.5 PROP. ELEV. 100.0 100.5 INDICATES DIRECTION OF SURFACE DRAINAGE

REMARKS

ALL BOUNDARY DATA SHOWN WAS OBTAINED FROM IDEEDS, RECORDED SUBDIVISION PLAT OR OTHER PUBLIC RECORD(S)

LOCATIONS AS SHOWN OF ADJACENT WELLS AND SEPTIC TANKS OBTAINED FROM LAKE COUNTY HEALTH DEPARTMENT

DESIGN CERTIFICATION

THIS PLAT WAS PREPARED BY ME, AND IS CORRECT TO THE BEST OF MY KNOWLEDGE AND BELIEF

NAME SURVEYOR REGISTRATION NO. 6343

CHECK LIST

NO. OF BEDROOMS DIMENSIONS OF SEPTIC TANKS TO THE DEEPEST STREET SURFLOT NO. PARCEL NO. SURROUNDING OWNERS BLDG. DIMENSIONS FIN GR. BLDG. TYPE ELEV. GRADIES APPROX. TYPE WIDTH THICKNESS SIDEWALK TYPE WIDTH THICKNESS CULVERT TYPE DIA. LENGTH ROCK OUTCROPPINGS

REVISIONS

NO.	DATE	BY
1		
2		
3		
4		
5		

PLAN PREPARED BY:


BABCOCK • JONES & ASSOCIATES, INC. PAINESVILLE, OHIO

DRAWN BY SCALE 1" = 30' PHONE NO. 357-1811 CHK'D. DATE 4/14/89 DRAWING NO. 89-070 CREW CHIEF APPD. CB

"AS BUILT" CERTIFICATION LOW YIELD WATER FIXTURES REQUIRED. HEREBY CERTIFY THAT THE CIRCLED GRADES ARE EXISTING ON ALL: FINISH GRADES CHECKED IN THE FIELD ON 19 Shower Head AND ARE CORRECT TO THE BEST OF MY KNOWLEDGE AND BELIEF. Toilet

REGISTERED SURVEYOR

REG. NO.

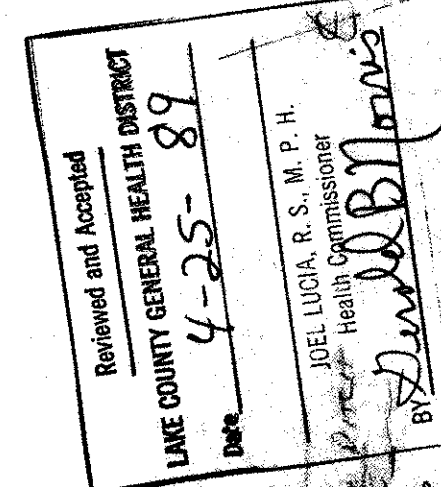

Grading Plan Approved as shown and/or noted THOMAS P. GILLES, P.E. Lake County Engineer

APPROVED

SIDE LINES & SET BACK

PERRY TOWNSHIP ZONING

PERMIT NO. 44540

ZONING INSPECTOR John King

Date 6-2-89

