


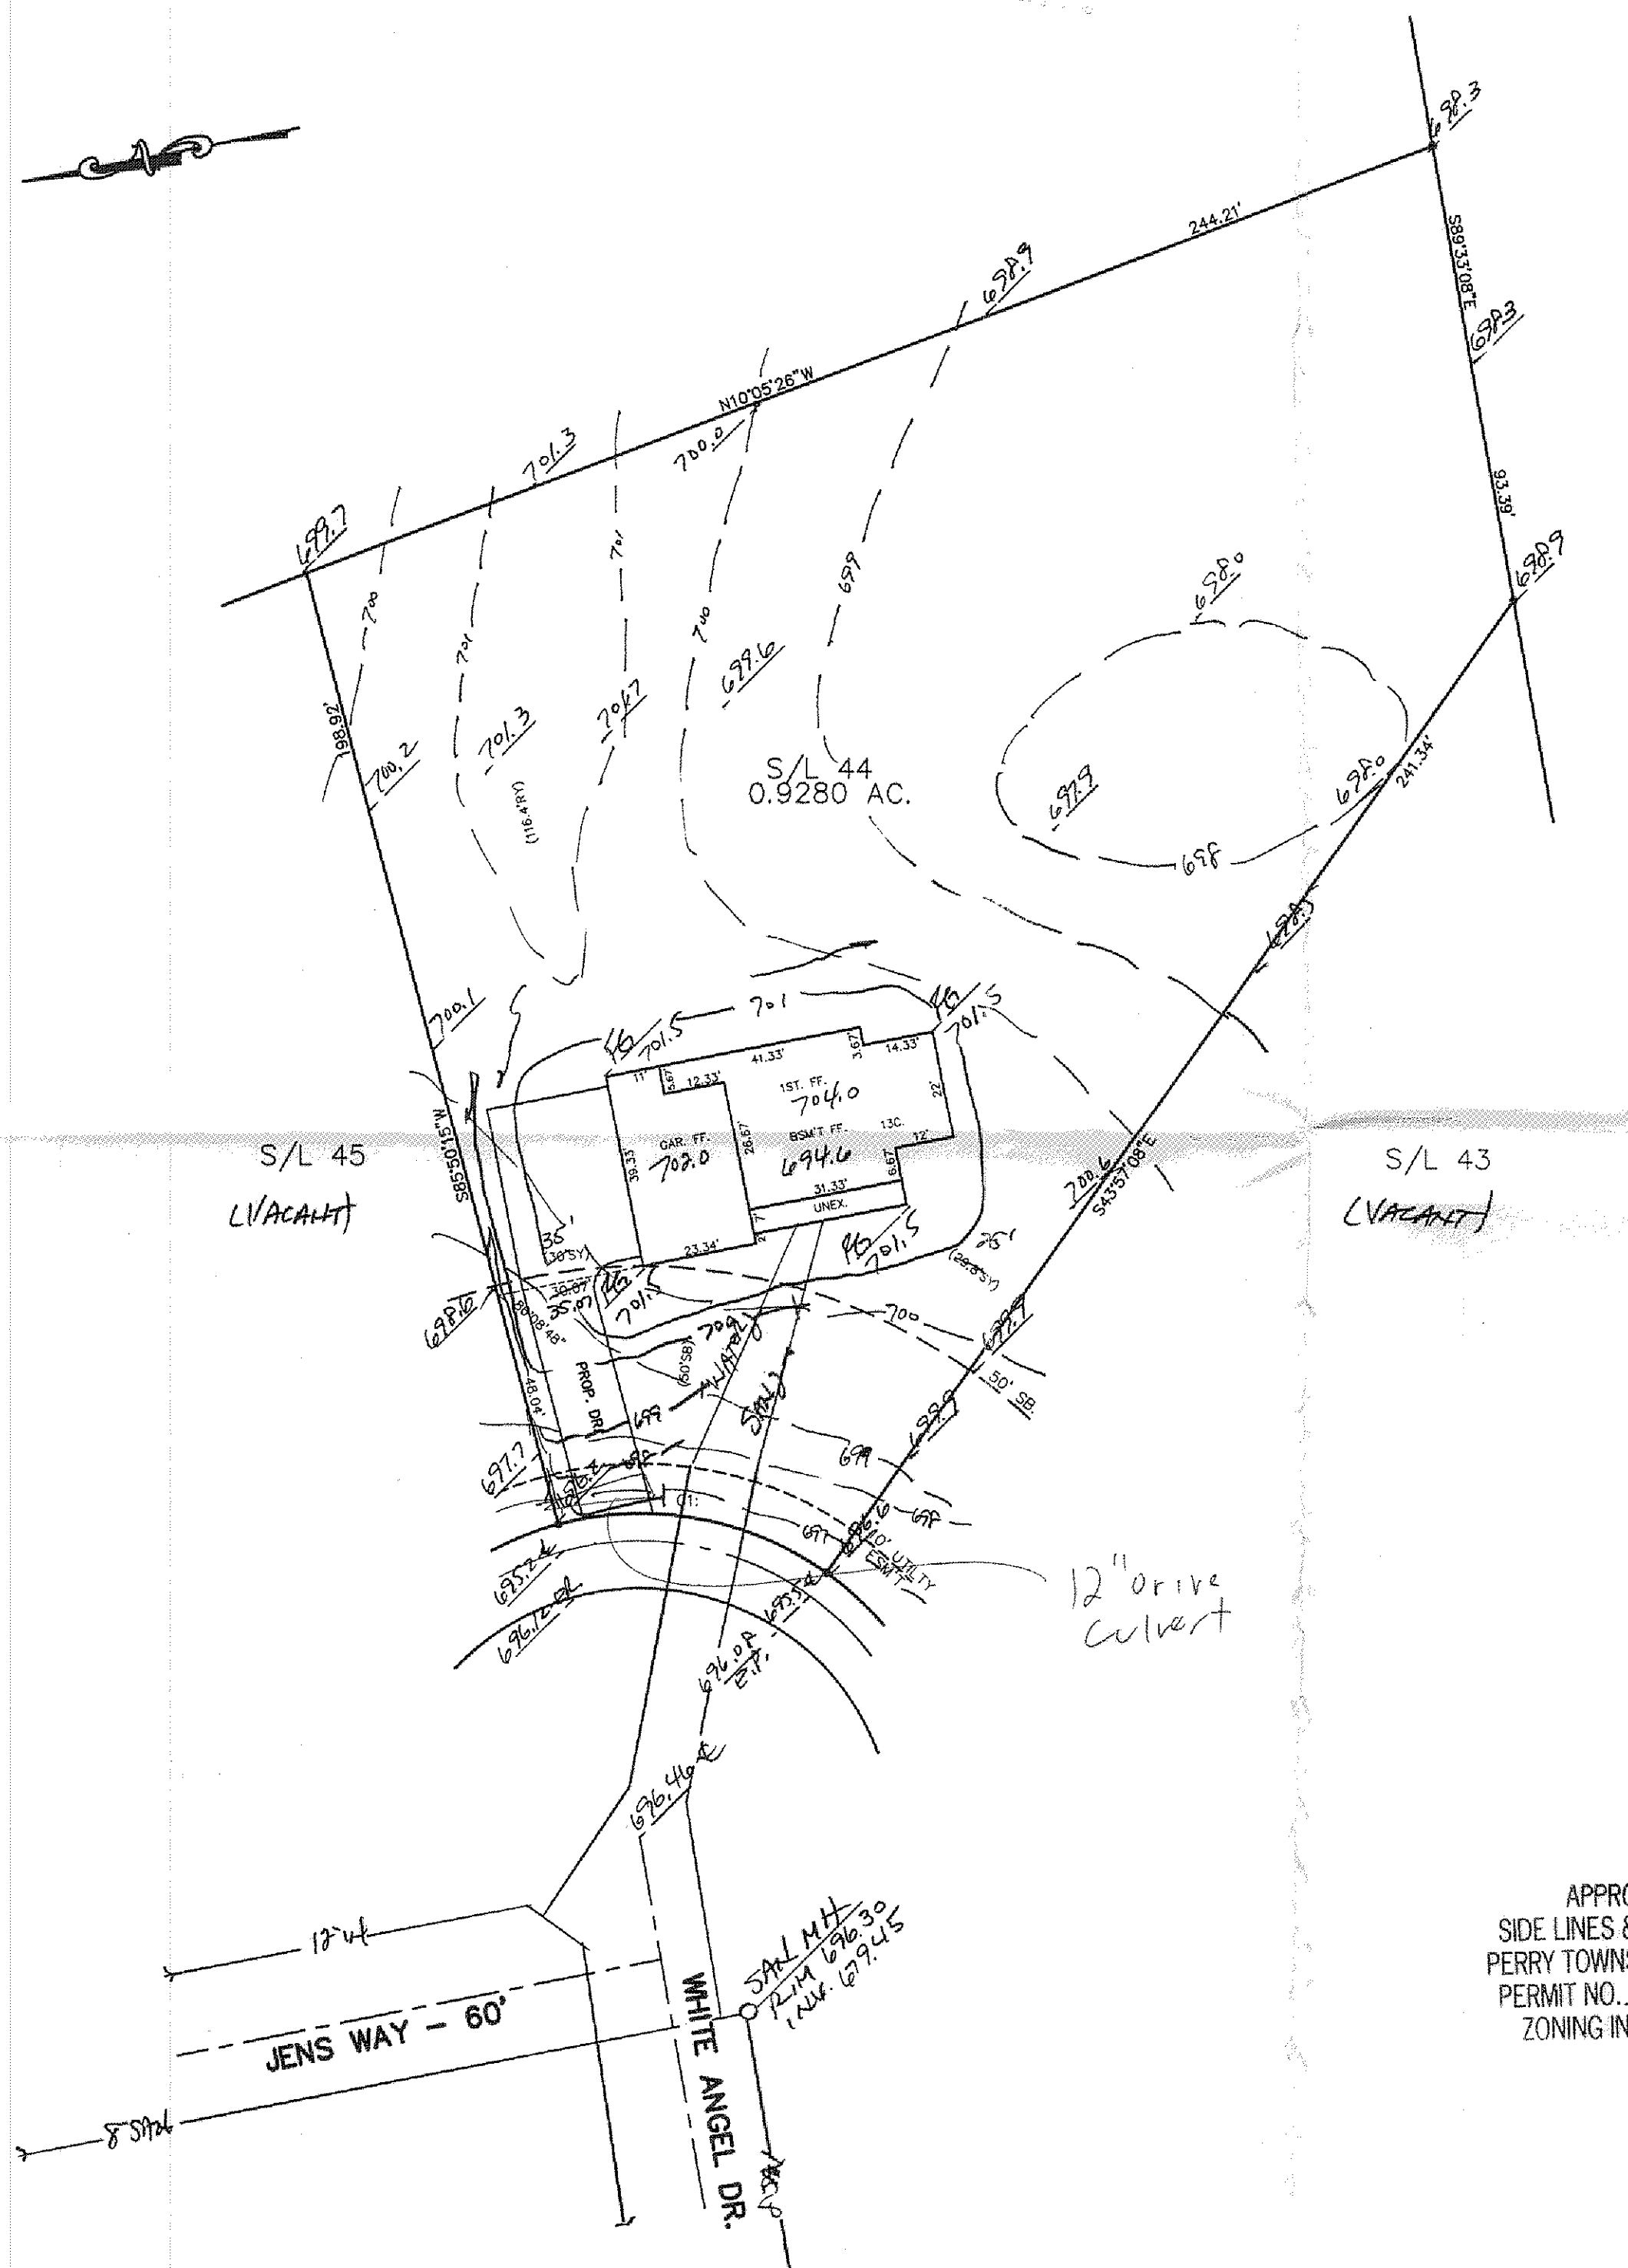

SITE PLAN

PERRY TOWNSHIP, LAKE COUNTY, OHIO

for: HAUGHTON HOMES

CLIENT _____ OWNER _____

ADDRESS _____ STREET _____ CITY _____ ZIP _____

RED MILL RUN

SUBDIVISION 32-26 NAME _____ TRACT _____ STREET _____

44 VOL-PG. JENS WAY LOT _____

SUBLOT NO. _____ STREET _____ VOL-PG. _____ PERM. PARCEL NO. _____

LEGEND

SANITARY MANHOLE --- EXIST. ELEV. --- 100.0 PROP. ELEV. 100.0
STORM MANHOLE --- AS BUILT ELEVATION
INLET OR CATCH BASIN ---
HYDRANT --- INDICATES
EXISTING CONTOURS --- DIRECTION OF
PROPOSED CONTOURS --- SURFACE DRAINAGE

REMARKS

ALL BOUNDARY DATA SHOWN WAS OBTAINED FROM (DEEDS, RECORDED SUBDIVISION PLAT OR OTHER PUBLIC RECORDS)
LOCATIONS AS SHOWN OF ADJACENT WELLS AND SEPTIC TANKS OBTAINED FROM LAKE COUNTY HEALTH DEPARTMENT

DESIGN CERTIFICATION

THIS PLAT WAS PREPARED BY ME, AND IS CORRECT TO THE BEST OF MY KNOWLEDGE AND BELIEF.

NAME Harry S. Jones, Jr. SURVEYOR #6343 REGISTRATION NO. _____

CHECK LIST

NO. OF BEDROOMS _____
DIMENSIONS _____
BEARINGS _____
TIE TO NEAREST STREET _____
SUBLOT NO. PARCEL NO. _____
SURROUNDING OWNERS _____
BLDG. DIMENSIONS FIN GR. _____
BLDG. TIES FL'R. GRADES _____
APRON TYPE WIDTH THICKNESS _____
SIDEWALK TYPE WIDTH THICKNESS _____
CULVERT TYPE DIA., LENGTH _____
ROCK OUTCROPPINGS _____
WATER MAIN SIZE, LOCATION _____
SAN. SEWER SIZE % GR. LOC. _____
SAN. MH. CAST. ELEV. INV. ELEV. _____
SAN. CONN. SIZE, LOC. DEPTH _____
STORM SEWER SIZE % GR. LOC. _____
STORM MH. CAST. ELEV. INV. ELEV. _____
PAV'T TYPE GRADE CURBS _____
GAS LINE LOC. SIZE PRESSURE _____
SEPTIC TANK LOCATION & DUPLICATION AREA _____
WELL LOCATION _____
ISOLATION RADIUS FROM WELL _____

REVISIONS

NO.	DATE	BY	PLAN PREPARED BY:
1	9/2/98	HJ	BABCOCK JONES & ASSOCIATES, INC.
2			PAINESVILLE, OHIO
3			DRAWN BY T.R. SCALE 1"=30' PHONE NO. 440-357-1811
4			CHK'D. H.J. DATE 9/2/98 DRAWING NO. 93-032-44
5			CREW CHIEF W.B. APP'D H.J.

"AS BUILT" CERTIFICATION

I, HEREBY CERTIFY THAT THE CIRCLED GRADES ARE EXISTING FINISH GRADES CHECKED IN THE FIELD ON _____, 19____ AND ARE CORRECT TO THE BEST OF MY KNOWLEDGE AND BELIEF.

REGISTERED SURVEYOR

REG. NO.

TSM - RIM SAN. MH. ELEV. = 696.30

C1: D=50'12'37"
R=65.00'
T=30.46'
L=56.96'
C=55.16'
N20°56'34"E



APPROVED
SIDE LINES & SET BACK
PERRY TOWNSHIP ZONING
PERMIT NO. 6711
ZONING INSPECTOR

Grading Plan Approved
as shown and/or noted
THOMAS P. GILLES, P.E.
Lake County Engineer

By GJH Date 9-8-98