


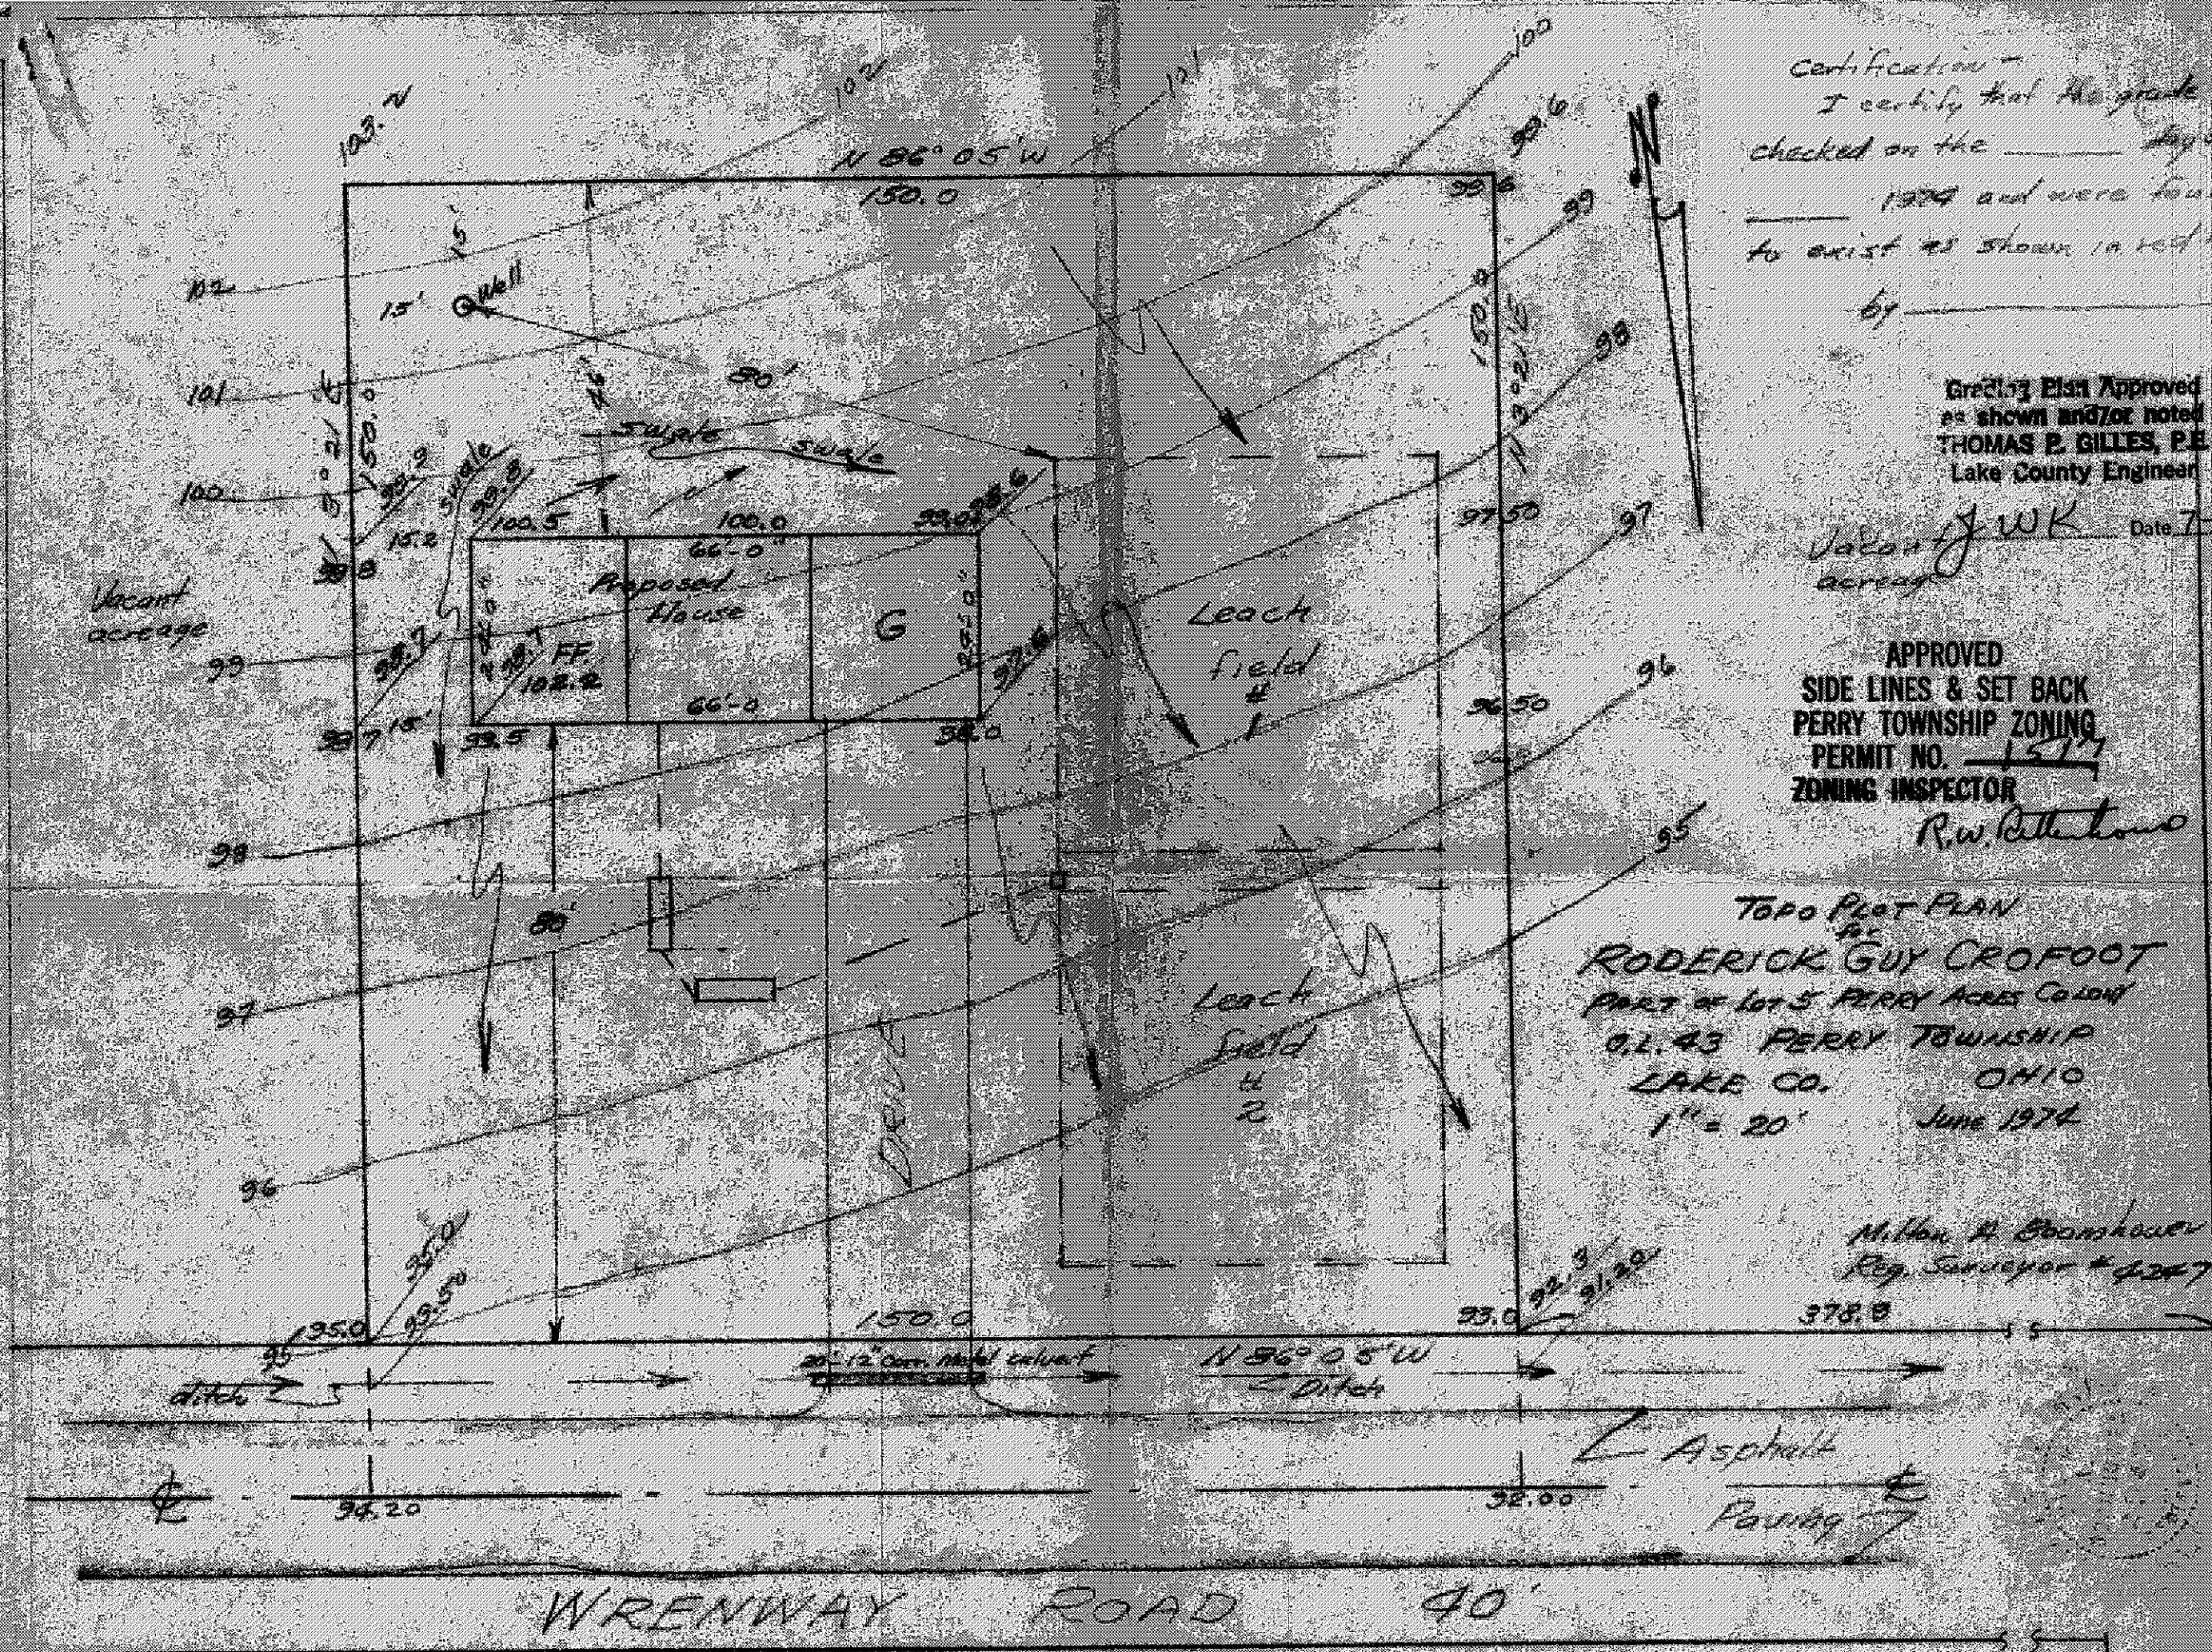

Certification -
 I certify that the grade were
 checked on the _____ day of
 _____ 1974 and were found
 to exist as shown in red hereon.
 by _____

Grading Plan Approved
 as shown and/or noted
 THOMAS E. GILLES, P.E.
 Lake County Engineer

Vacant JWK acreage Date 7-1-74

APPROVED
 SIDE LINES & SET BACK
 PERRY TOWNSHIP ZONING
 PERMIT NO. 1577
 ZONING INSPECTOR

R.W. Rethman

Topo Plot Plan
 for
 RODERICK GUY CROFOOT
 PART of lot 5 PERRY ACRES COLONY
 O.L. 43 PERRY TOWNSHIP
 LAKE CO. OHIO
 1" = 20' June 1974

Milton A. Boonshaver
 Reg. Surveyor #4347

ELBERTA RD 30'