


"I, the undersigned hereby certify that the topography shown hereon, indicated by one foot contours and elevations represents an actual field topographic survey made by me on the 14th day of March, 1992 and that the elevations were taken at appropriate intervals and that as of that date they existed as indicated hereon."

James W. Alban E-54132
 Registered Engineer Reg. No.

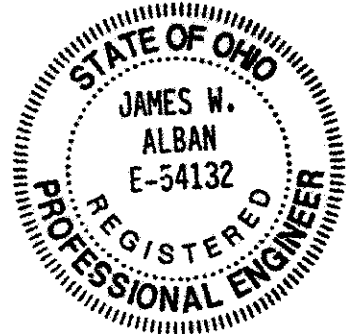

DESIGN CERTIFICATION		
THIS WAS PREPARED BY ME, AND IS CORRECT TO THE BEST OF MY KNOWLEDGE AND BELIEF.		
<i>James W. Alban</i>		REG. NO. 54132
JAMES W. ALBAN, P.E.		
REVISIONS		PREPARED BY
NO.	DATE	
1		 PAINESVILLE, OHIO
2		
3		
4		
5		
DRAWN BY JWA		SCALE 1" = 50'
DATE 6/10/92		DRAWING NO. S3