



SURVEY AND SITE PLAN

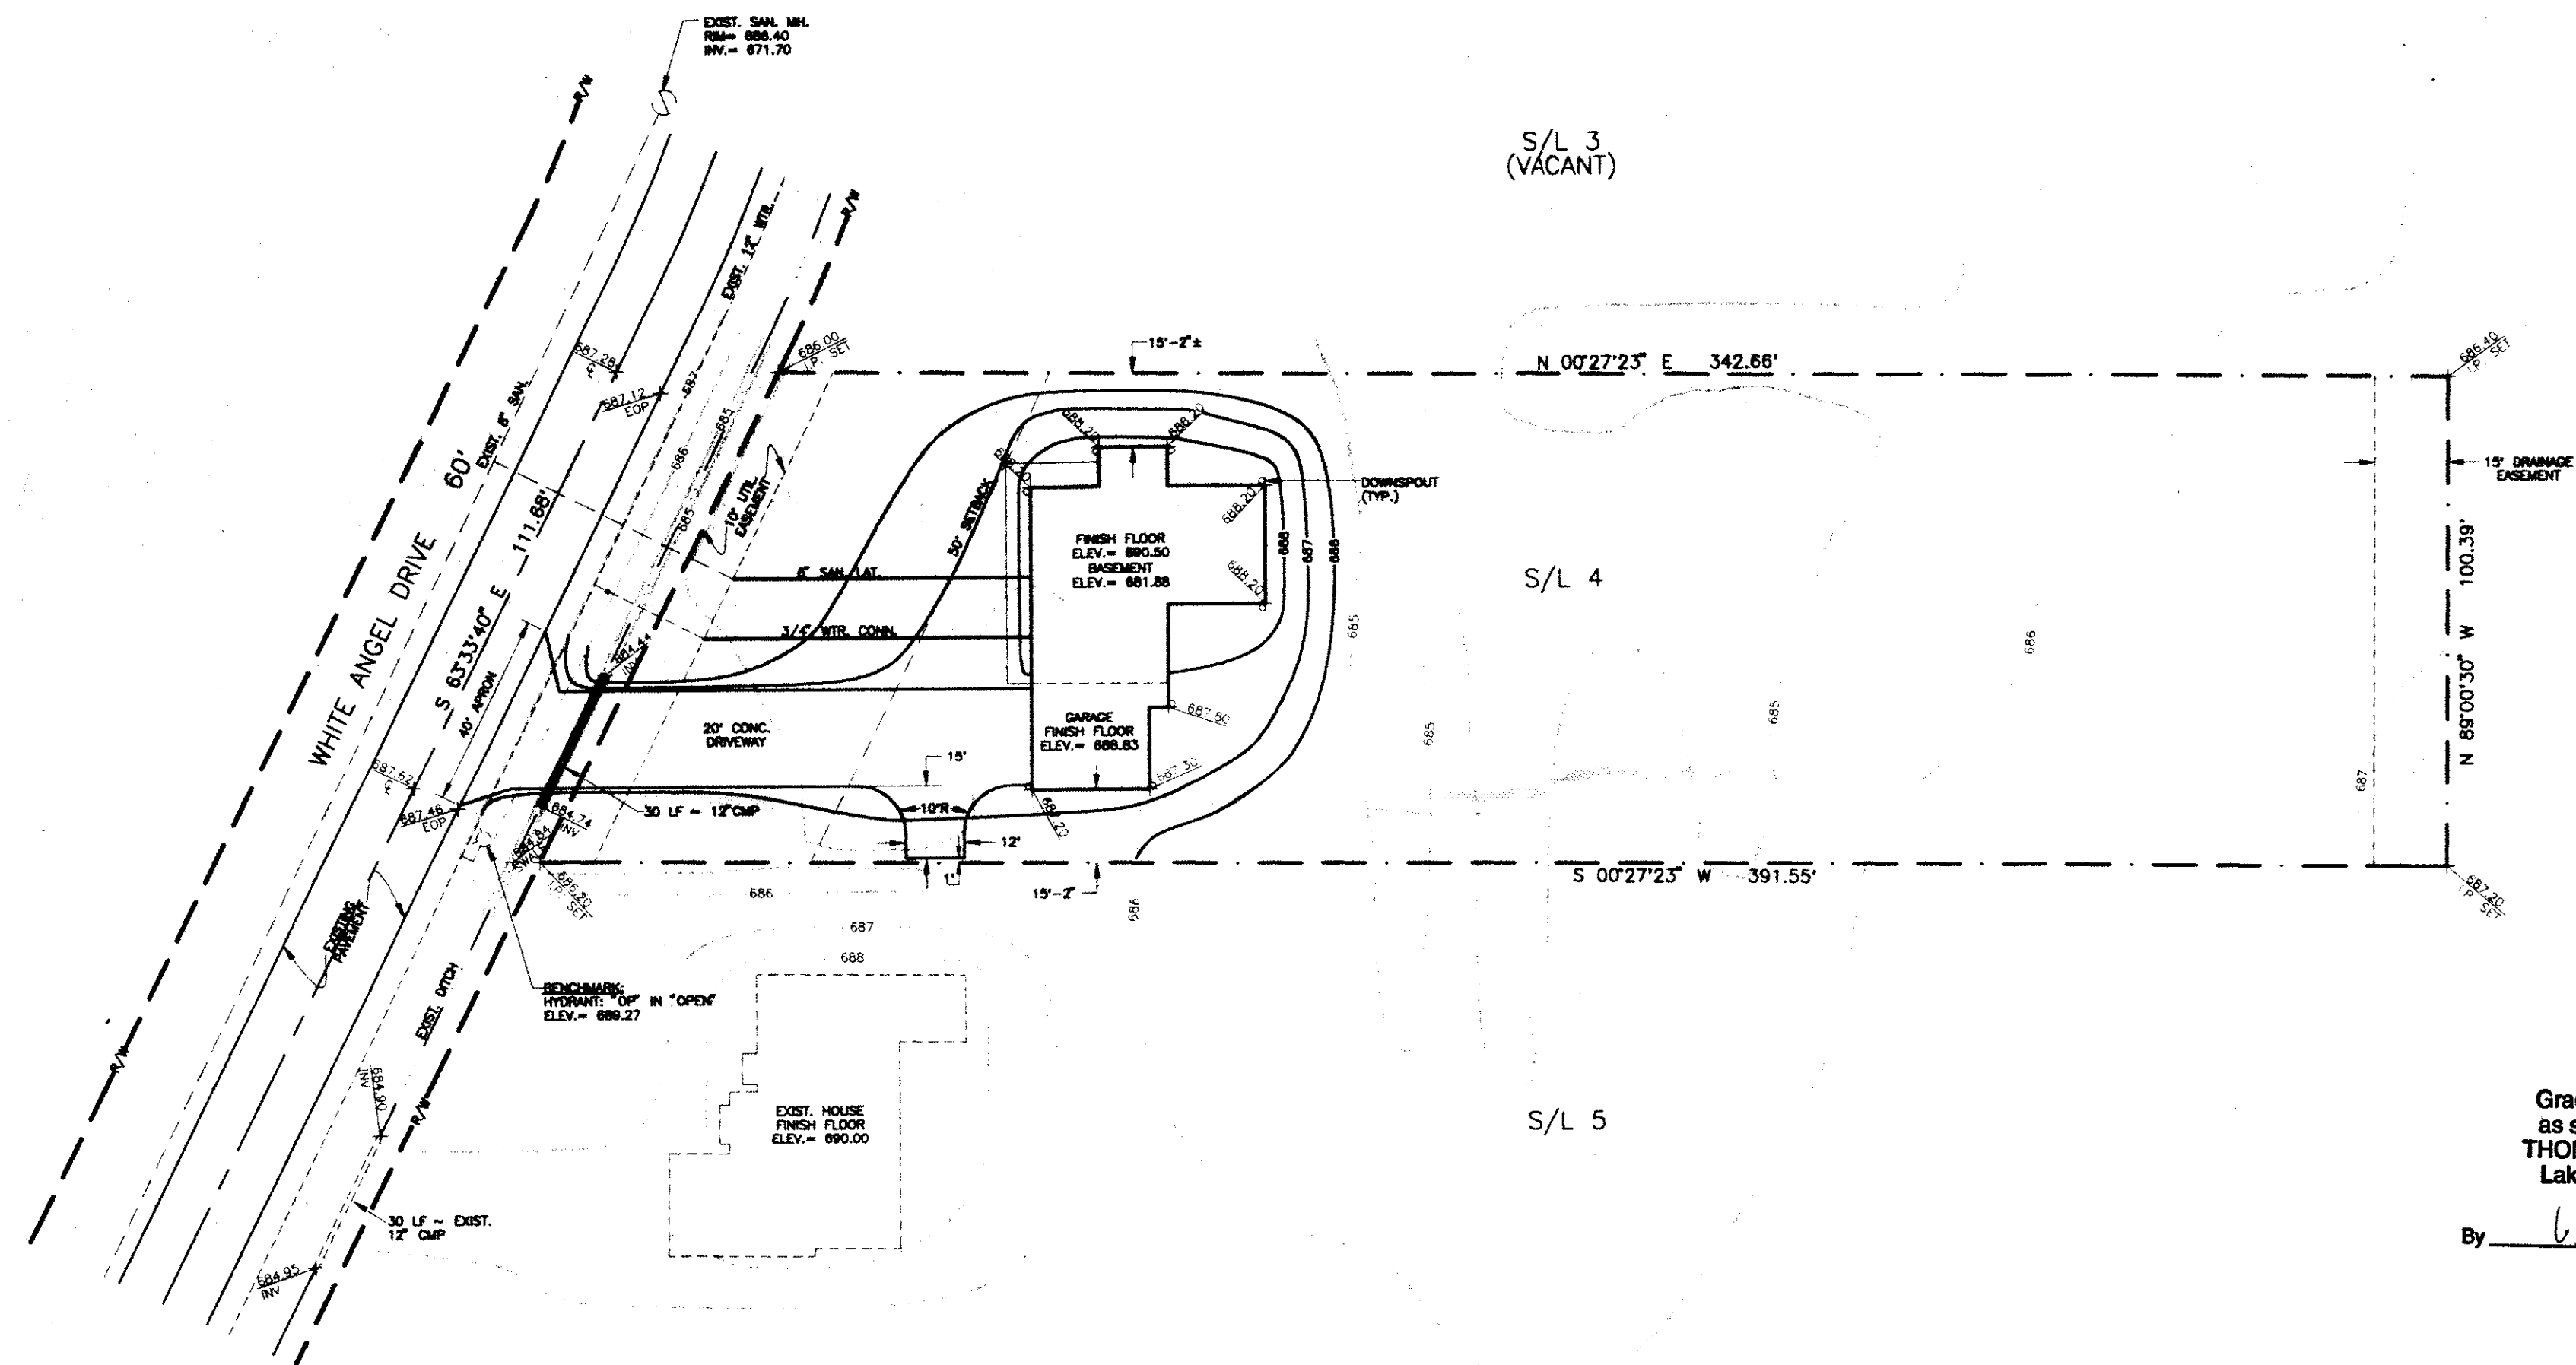

Grading Plan Approved
as shown and/or noted
THOMAS P. GILLES, P.E.
Lake County Engineer

By 6/14 Date 4.14.97

MAR 25 1997

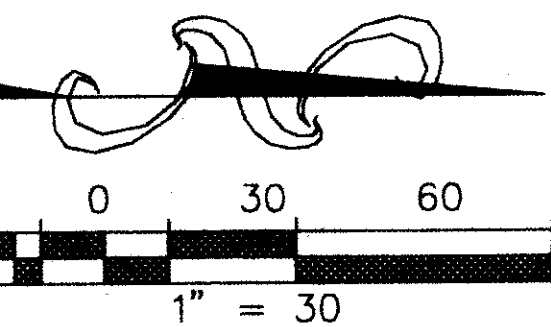

PROPERTY SURVEY IS PURSUANT
CHAPTER 4733-37 OF THE OHIO
NISTRATIVE CODE.

APPROVED
SIDE LINES & SET BACK
PERRY TOWNSHIP ZONING
PERMIT NO. 6447
ZONING INSPECTOR

		10 WEST ERIE STREET BUILDING, SUITE 101 PAINESVILLE, OHIO 44077 PHONE: (216) 357-5841 FAX: (216) 357-1818 1-800-488-3968				
		TIMOTHY E. STOCKER P.S. 7245 COPYRIGHT 1994 CRABBS' SURVEYING SERVICE				
REVISIONS 	DRAWN BY J H	SCALE 1" = 30'	DATE 03-21-97	PRINTED 	DRAWING NO. 6551-1	SHEET NO. 1 - 1