

LOW YIELD WATER
FIXTURES REQUIRED
ON ALL:

- Shower Head
- Toilet

SEWAGE DISPOSAL PERMIT MUST BE
OBTAINED BY A LAKE COUNTY LICENSED
INSTALLER BEFORE INSTALLATION IS
STARTED.

WOODHILL STREET EXT.

SCALE: 1" = 20'

Grading Plan Approved
as shown and/or noted
THOMAS F. GILLES, P.E.
Lake County Engineer
Date 8/4/93
By Swale 15 shown



Reviewed and Accepted	Date
LAKE COUNTY GENERAL HEALTH DISTRICT	7.30.93
By <u>Lucia R. S., M.P.H.</u>	
Health Commissioner	

- To be brought to finished grade
- Septic tank manhole cover
- Splitter box cover
- Distribution box cover
- No footer drains or downspouts to be discharged into septic tanks
- All waste water to be discharged into septic tanks

BEING S/L 16 IN THE WOODRIDGE SUBD.
IN THE TOWNSHIP OF PERRY, COUNTY OF
LAKE, STATE OF OHIO.

SITE PLAN
FOR
BILL MERIDETH
FF-99.43

APPROVED
PERRY TOWNSHIP ZONING
PERMIT NO. 4865
ZONING INSPECTOR

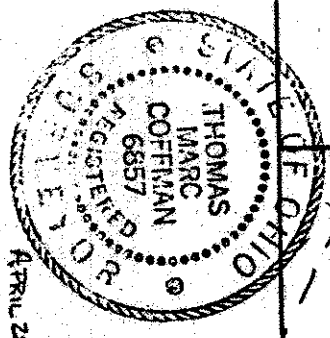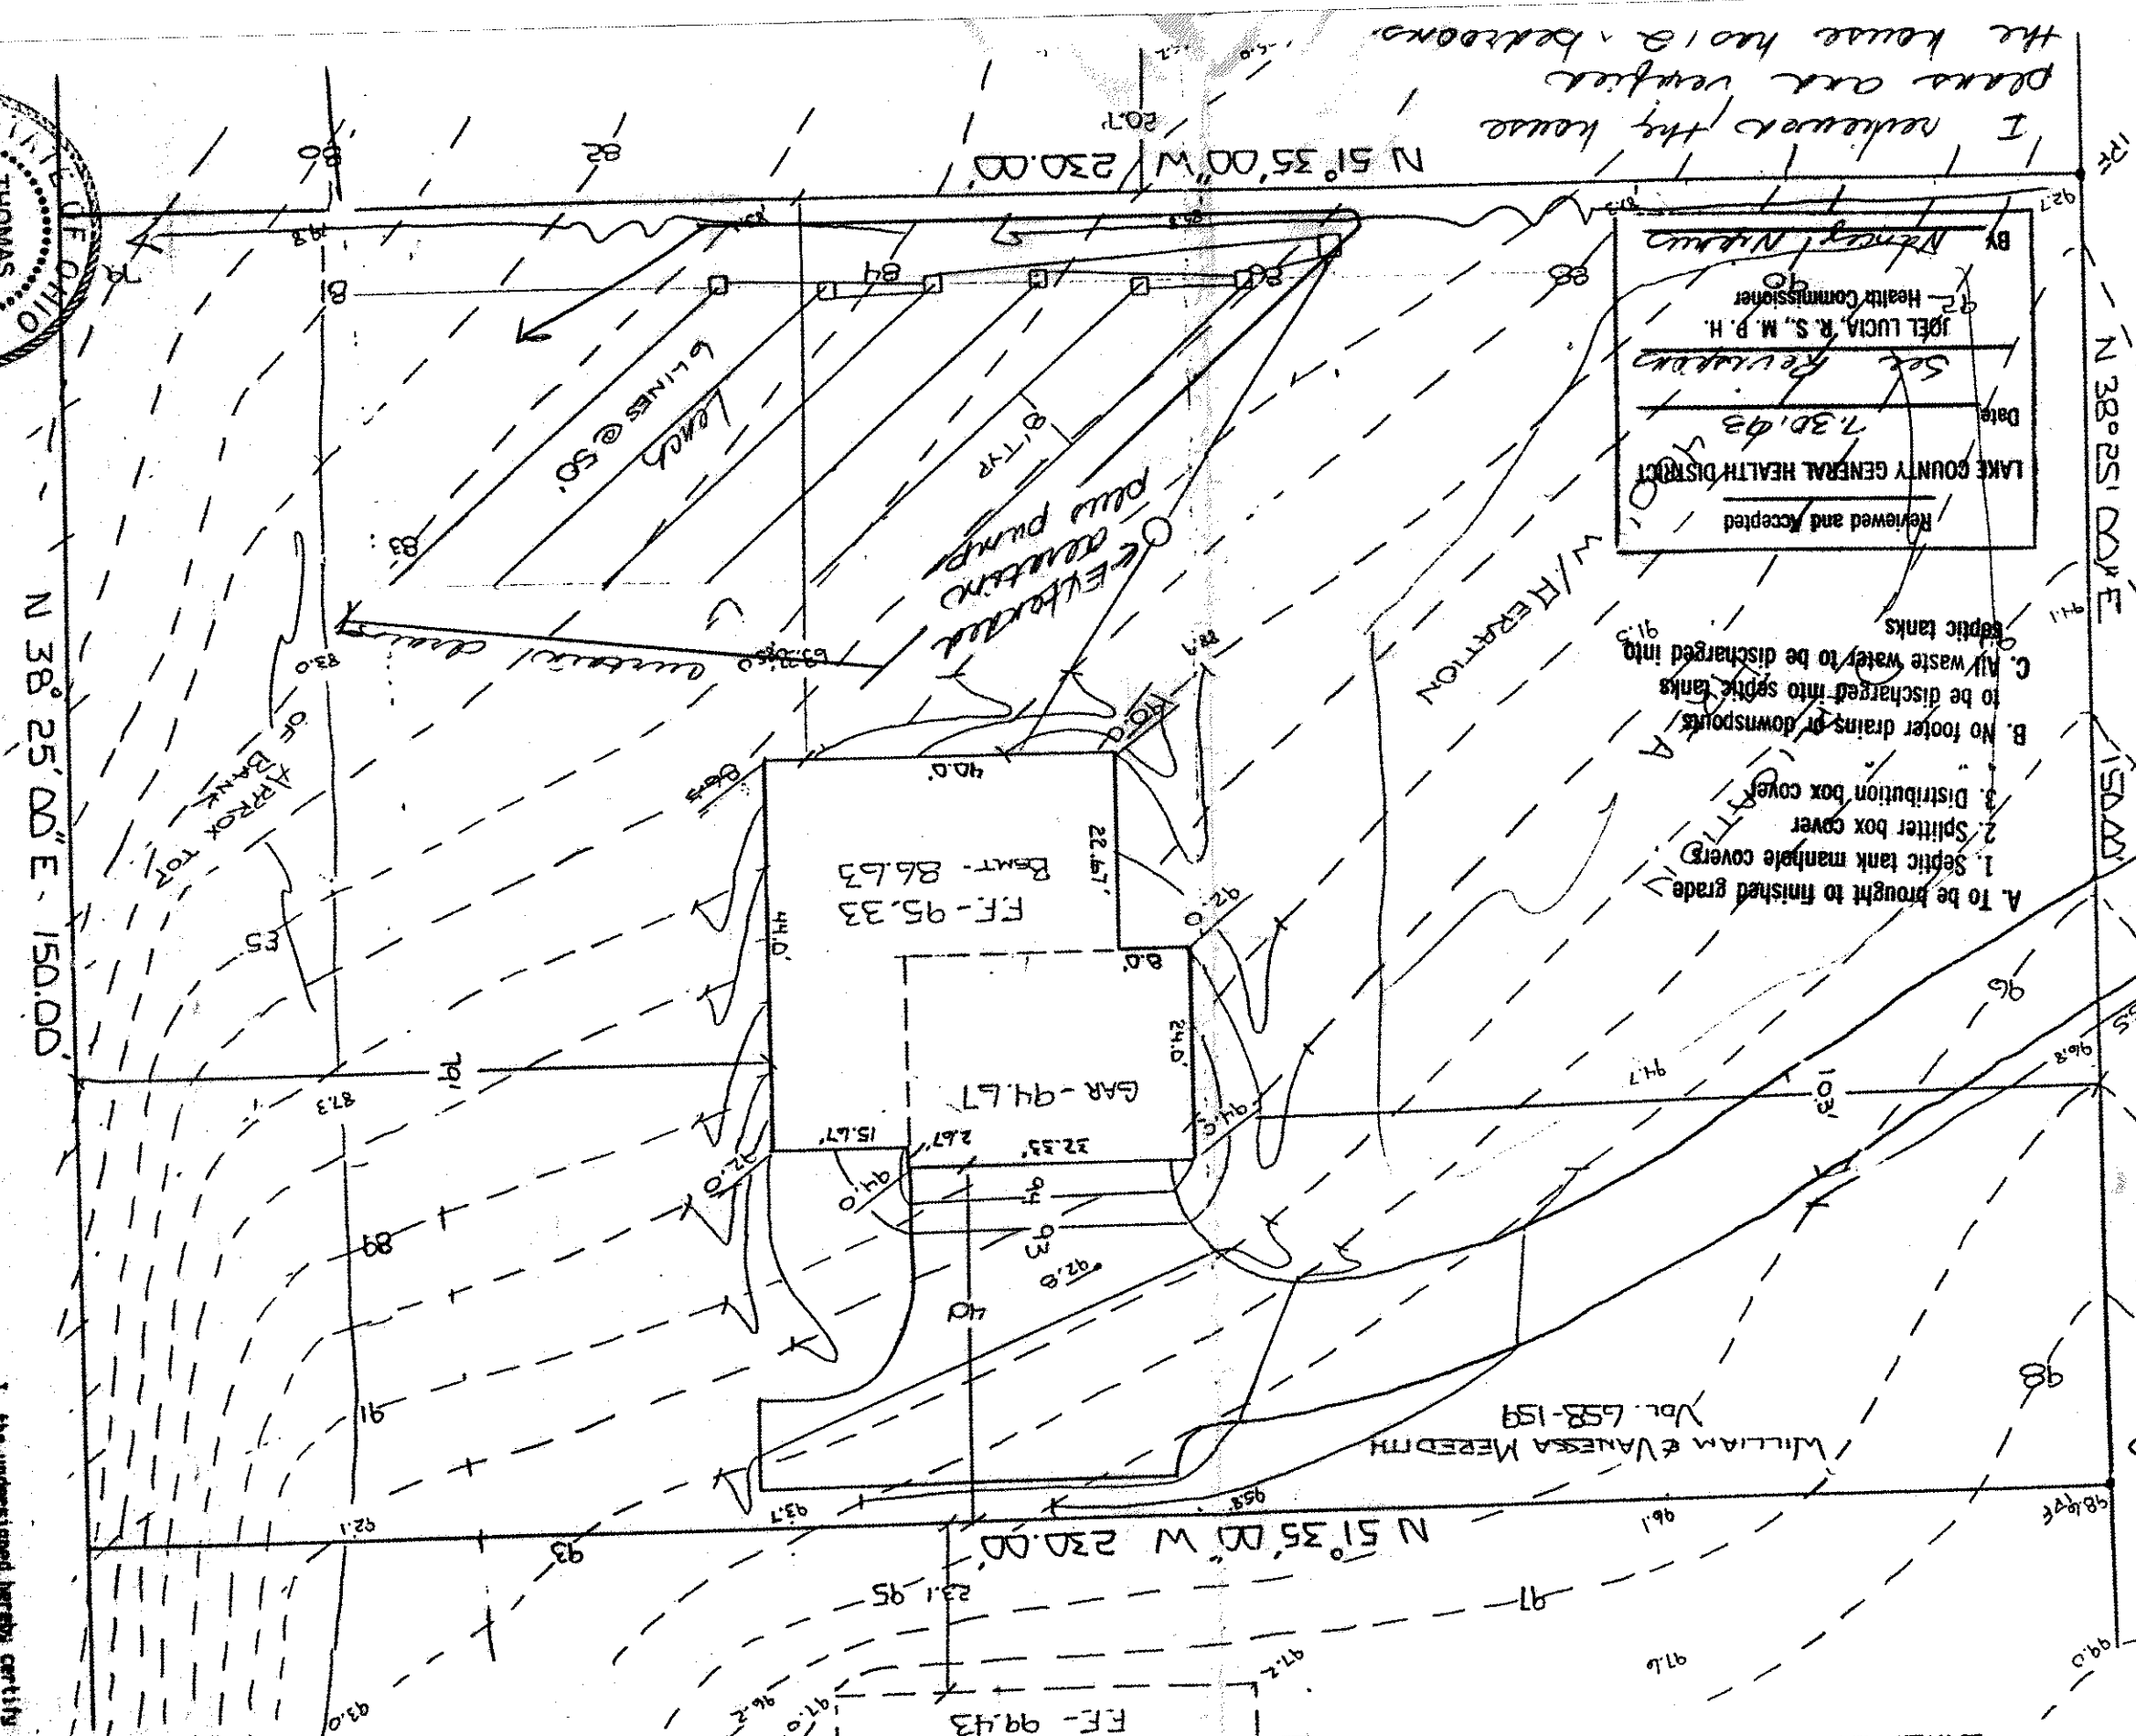

April 28, 1993

VILLAGE SURVEYING CO.
202 THIRD ST. FAIRPORT HARBOR, OHIO 44077
(216) 357-1359

I, the undersigned hereby certify that this topography, indicated by 1' contours, and elevations shown hereon represent an actual field survey made by me on 9-25-91 and that the elevations were taken at appropriate intervals and that as of that