

S/L 3 AREA: 0.2014 AC.
S/L 4 AREA: 0.2014 AC.

GAR.FLR. = GARAGE DOOR FRONT
FIN.FRL. = FINISHED FIRST FLOOR
(ELEV. PROVIDED PER BUILDER)

"AS-BUILT" CERTIFICATION

I HEREBY CERTIFY THAT THE CIRCLED INFORMATION IS EXISTING AS OBTAINED ON THE SITE AND IS CORRECT TO THE BEST OF MY KNOWLEDGE AND BELIEF.

I ALSO HEREBY CERTIFY THAT AS OF THAT DATE EROSION CONTROL ITEMS WERE IN PLACE PER THE APPROVED SITE PLAN.

DATE _____ NAME _____

SITE PLAN GENERAL NOTES:

EROSION CONTROL DEVICES SHOWN ON THE
MASTER SITE PLAN SHOULD BE MAINTAINED
THROUGHT OUT CONSTRUCTION OF ALL UNITS.

CONTRACTOR TO REPAIR ANY DAMAGE TO
EXISTING 4' CONC. WALK THAT OCCURS.

THE CONDOMINIUM BOUNDARY MUST BE STAKED
TO CONFIRM BUILDING LOCATIONS.

DRIVEWAYS SHALL BE 6" THICK AND HAVE 3' FLARES ON EACH SIDE. *Approved as shown and/or noted*

JAMES R. GILLS, P.E.


County Drainage Engineer

By L.S. Date 11/2

000.00 = SPOT ELEVATIONS



STONE CONSTRUCTION ENTRANCE

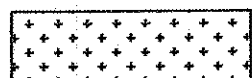


AREAS REQUIRING TEMPORARY
STABILIZATION (SEE E.S.C. NOTES)




INLET PROTECTION




SILT FENCE

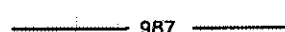

PROPOSED CONTOUR

 


EXISTING CONTOUR

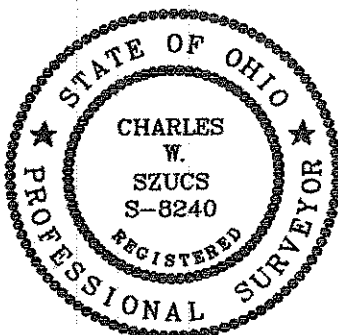

I, THE UNDERSIGNED, HEREBY CERTIFY THAT THIS TOPOGRAPHY, INDICATED BY 6", 1' OR 2' CONTOURS, WERE TAKEN AT APPROPRIATE INTERVALS AND THAT AS AND ELEVATIONS SHOWN HEREON, REPRESENT AN ACTUAL FIELD SURVEY MADE BY ME ON THE 9th DAY OF MARCH, 2006, AND THAT THE ELEVATIONS WERE TAKEN AT APPROPRIATE INTERVALS AND THAT AS OF THAT DATE, THEY EXISTED AS INDICATED HEREON.

Charles W. Szucs
CHARLES W. SZUCS, P.S. # 8240

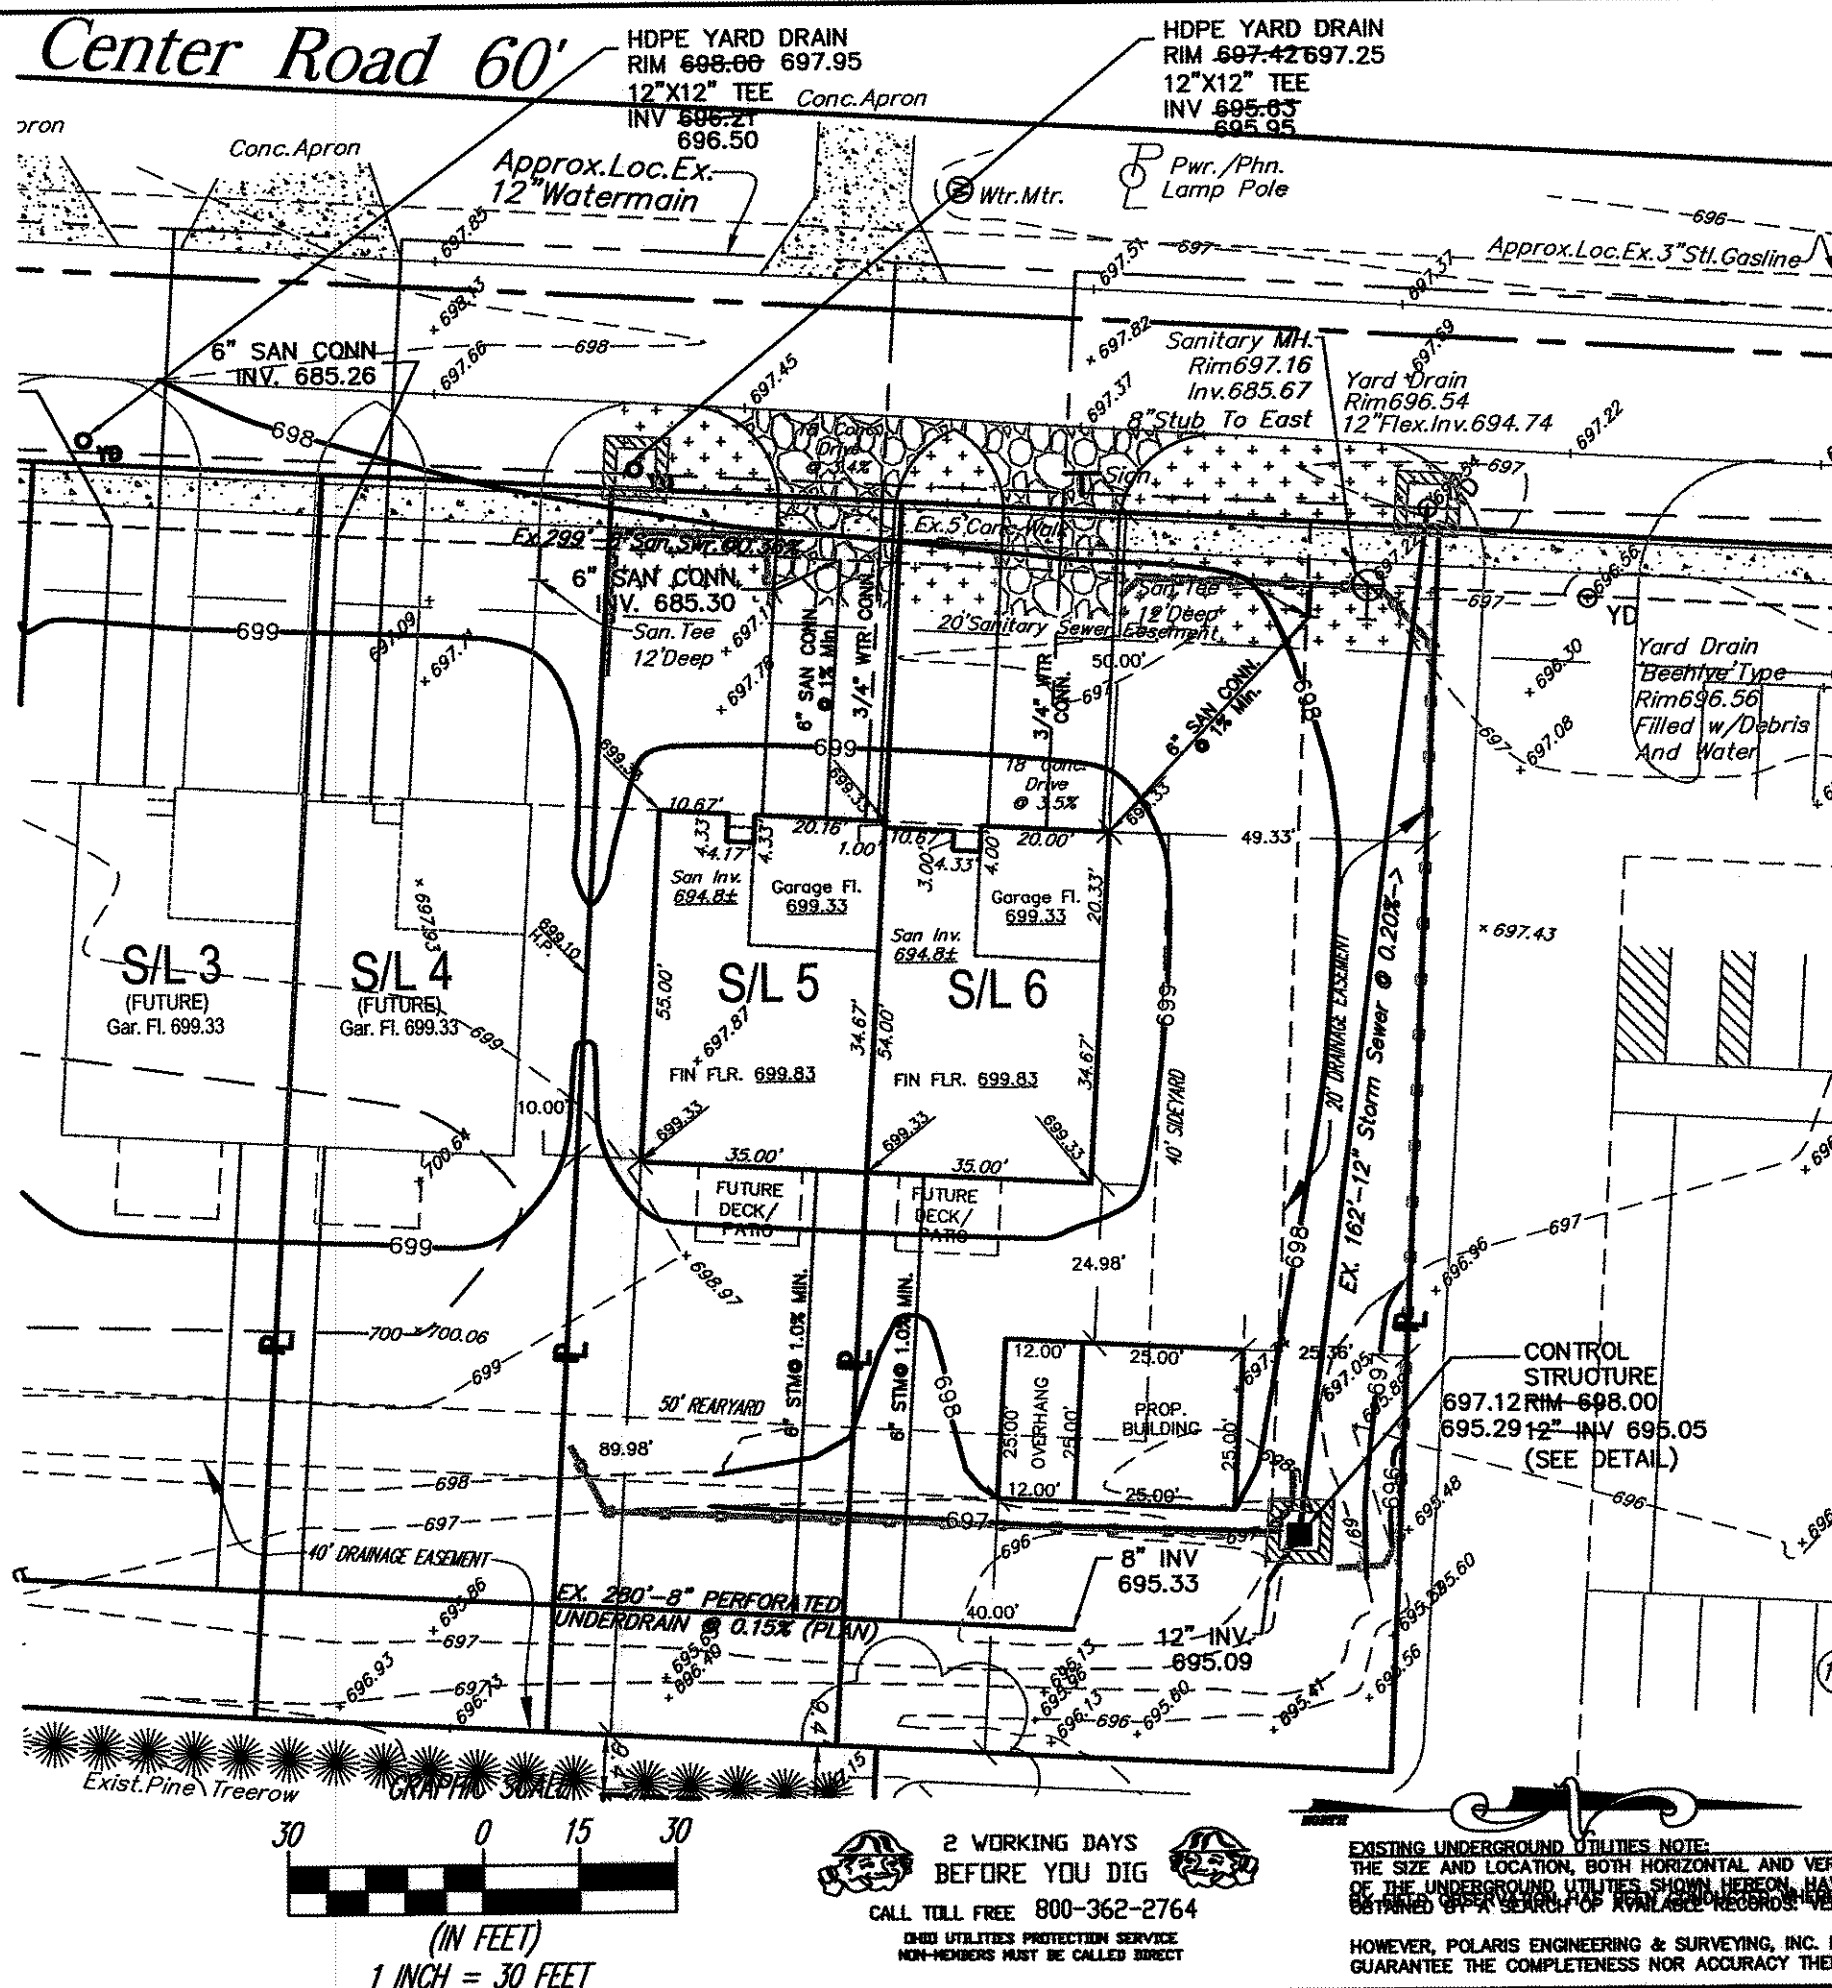

**POLARIS ENGINEERING
& SURVEYING, INC.**
34600 CHARDON ROAD
SUITE D
WILLOUGHBY HILLS, OH 44094
(440) 944-4433
(440) 944-3722 (Fax)
www.polaris-es.com

DATE: 11/17/11

SCALE: HOR. 1"=30'
VERT. none

FILENAME: Siteplan_5&6

Tab: Unit 5&6

SITE PLAN FOR:
SUBLOT No. 5 and 6
Dugan's Corner
PERRY VILLAGE -- LAKE COUNTY -- OHIO

OWNER:

ANGELORO CONSTRUCTION
3966 REDMILL COVE
PERRY VILLAGE, OHIO 44081

PHONE: (440) 258-4139

CONTACT:
Frank Angeloro

CONTRACT No.

11129

SHEET	0
-------	---

1	
---	--