
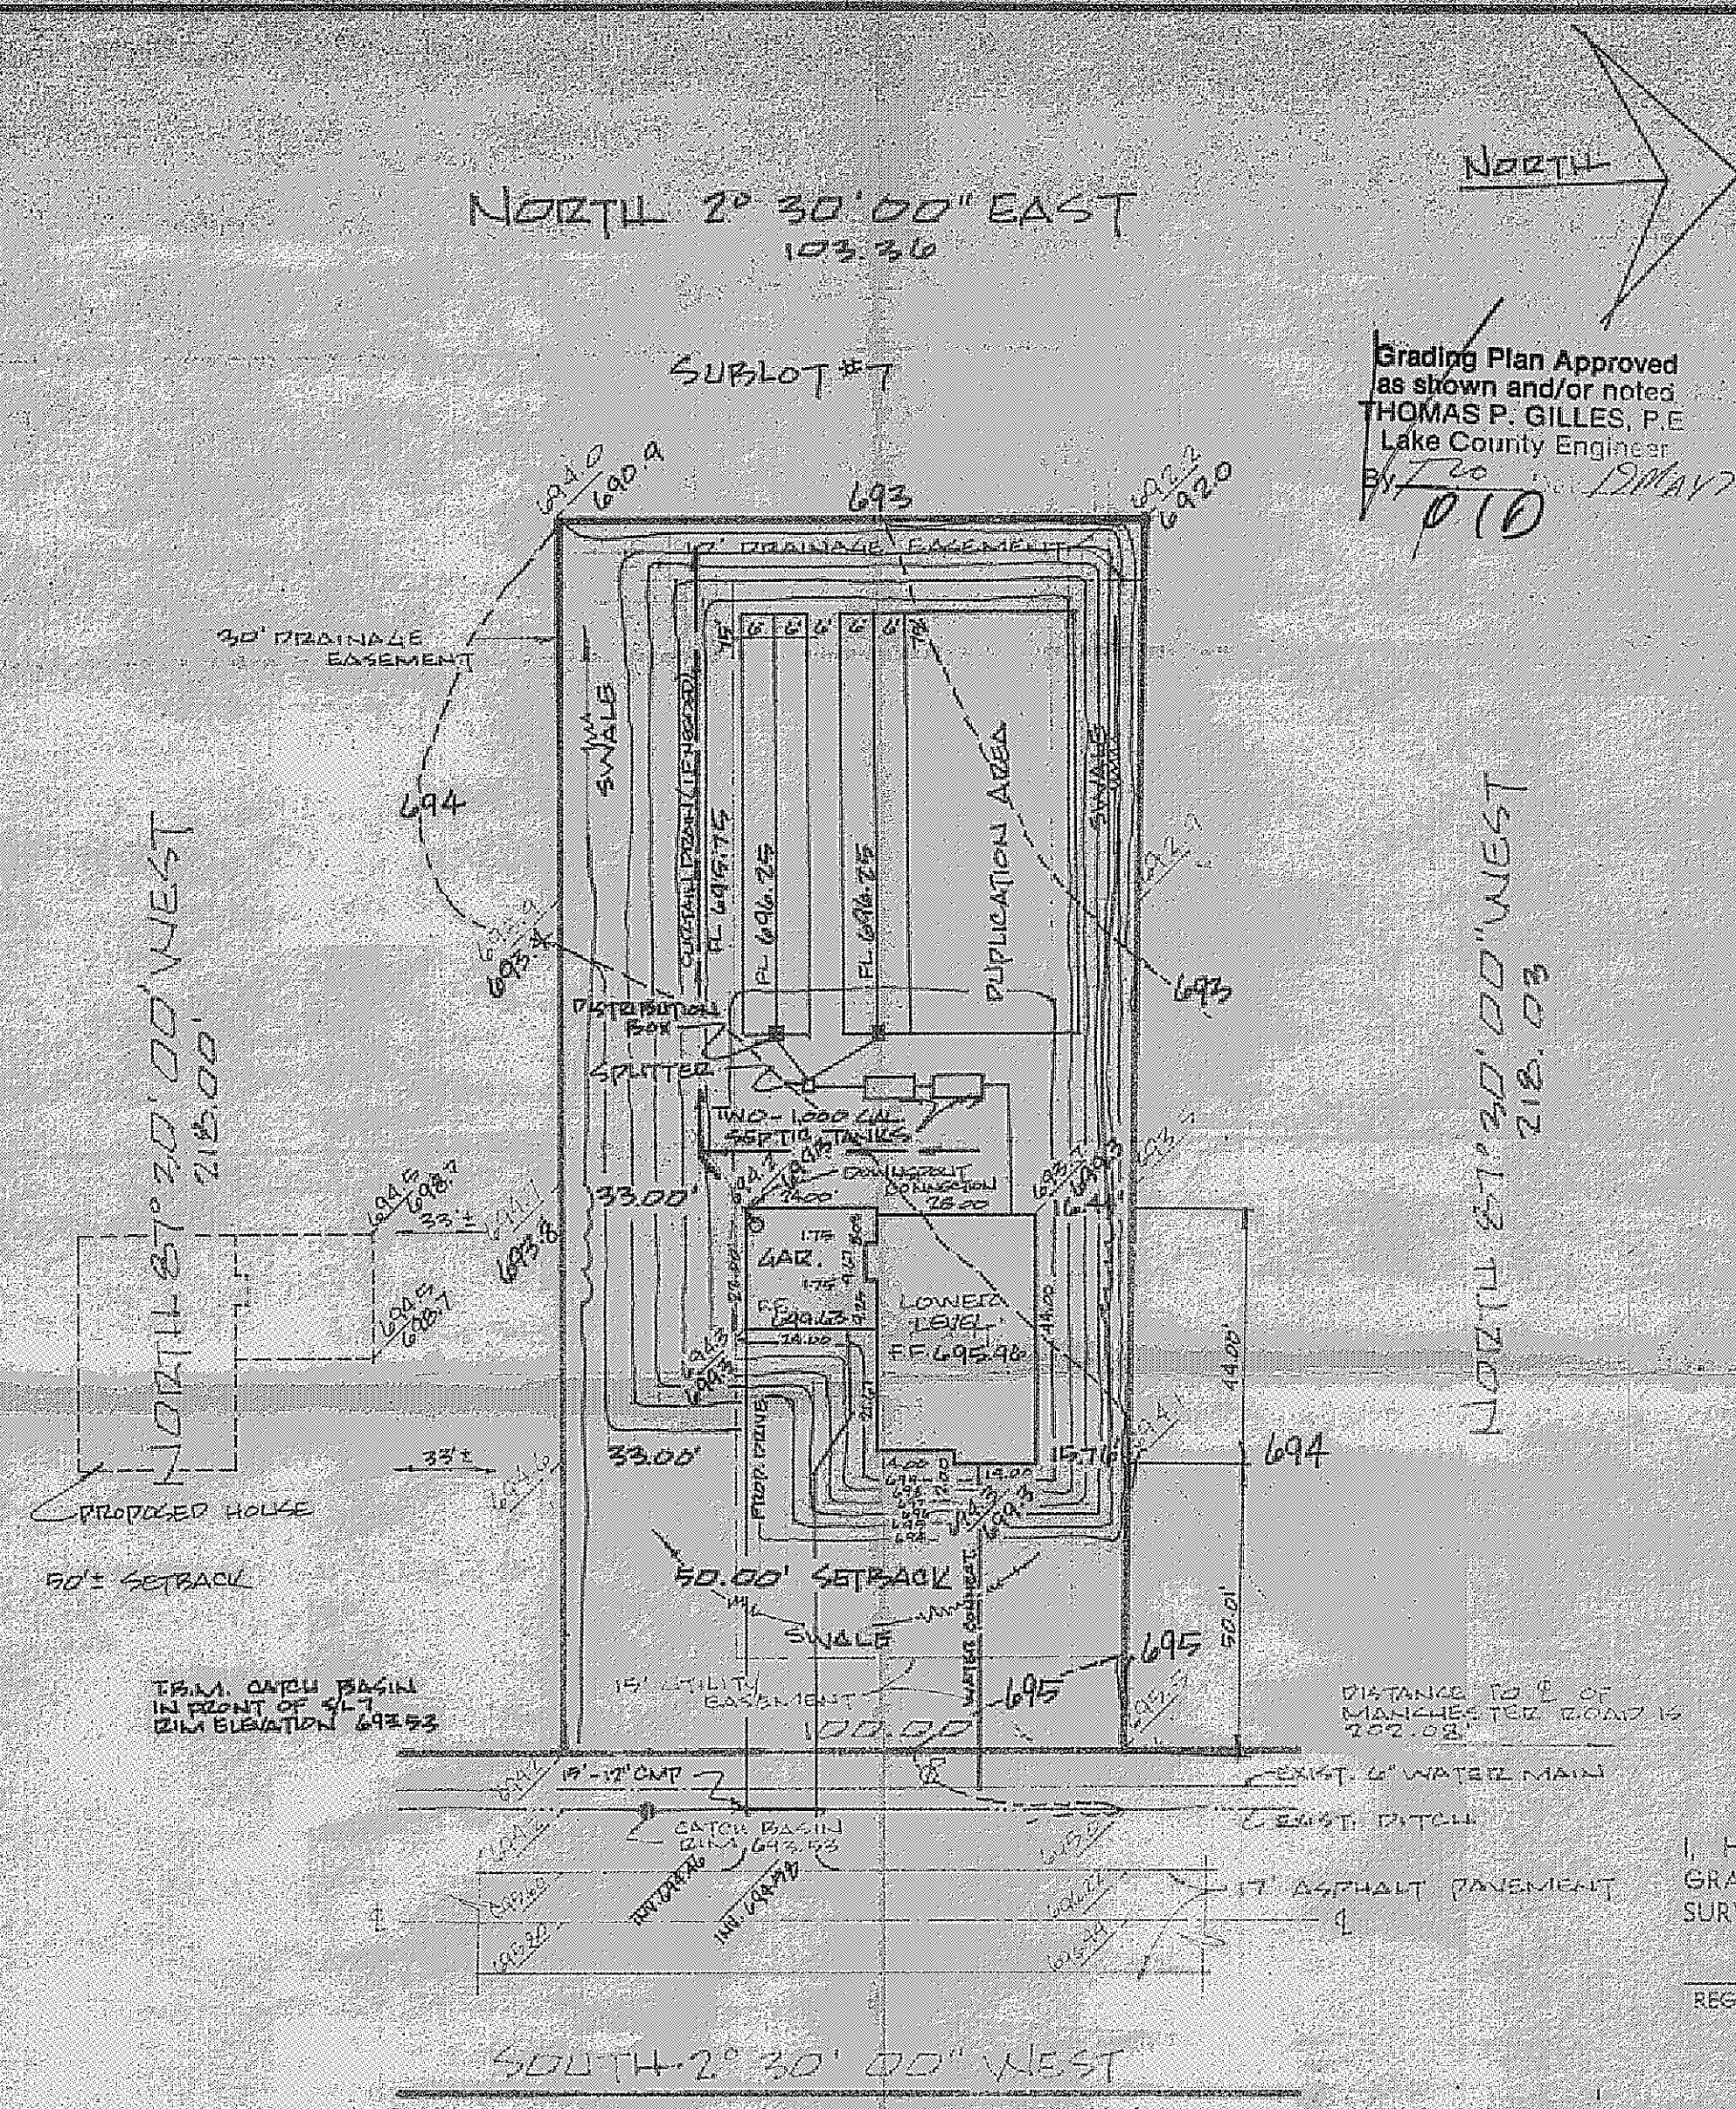


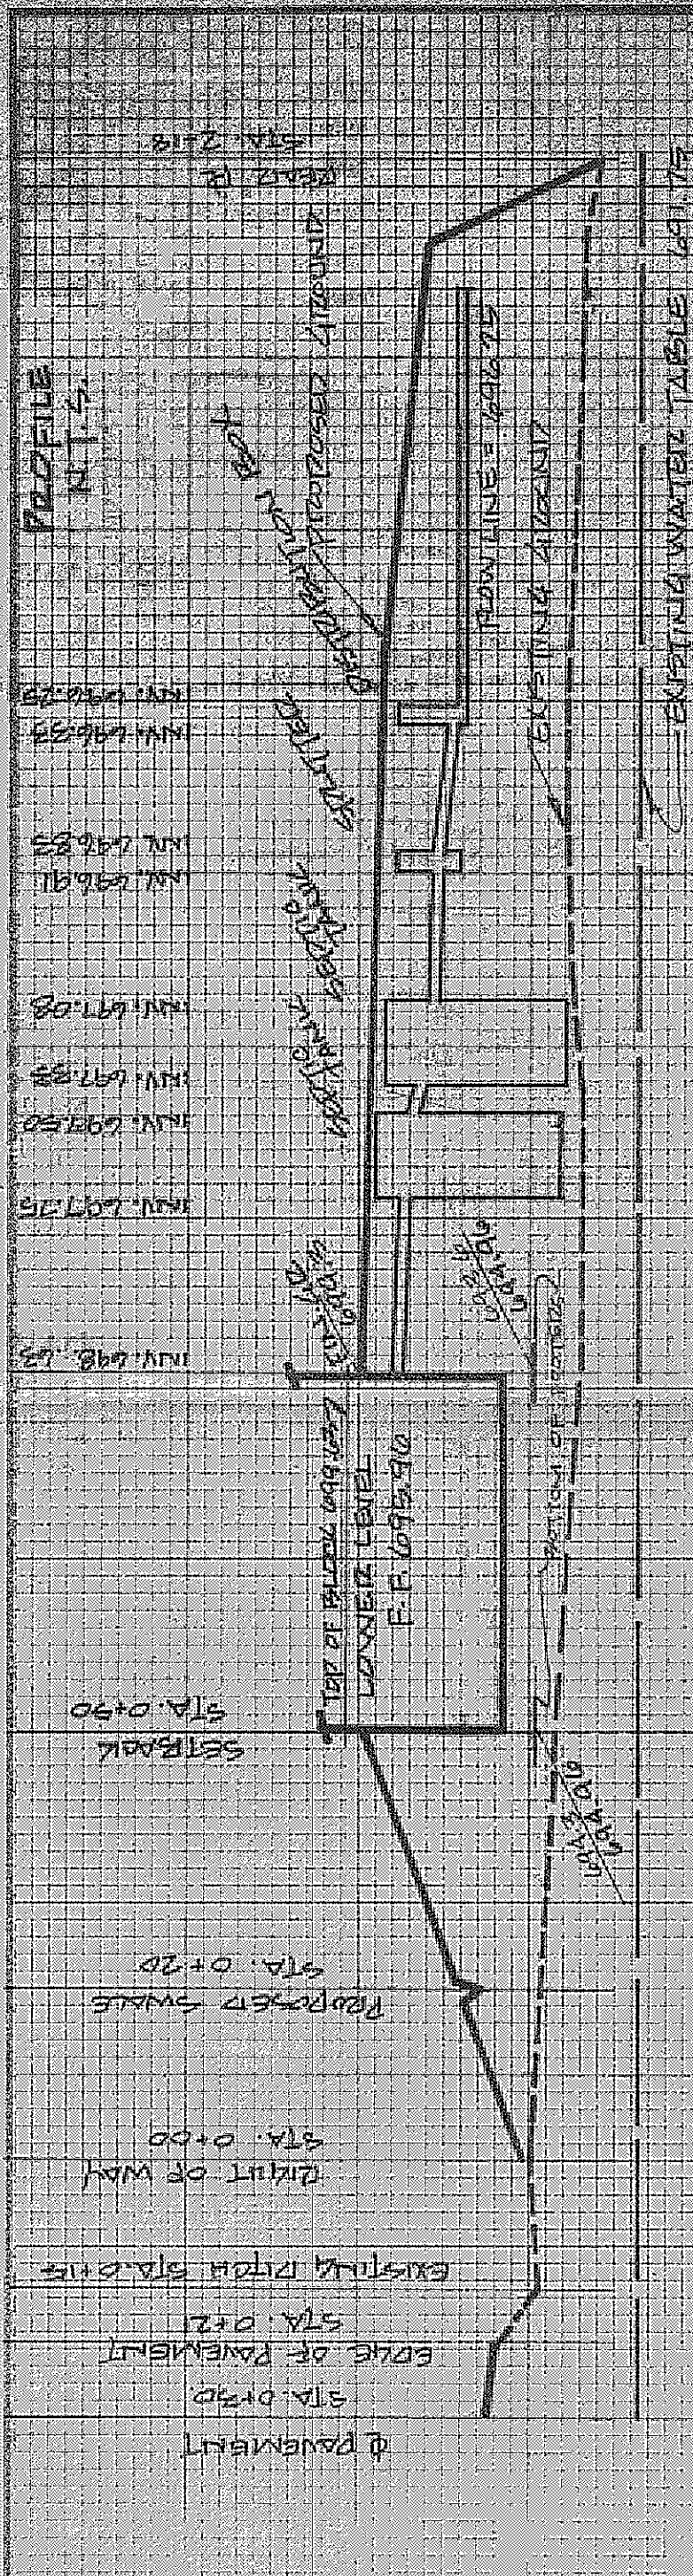

Grading Plan Approved
as shown and/or noted
THOMAS P. GILLES, P.E.
Lake County Engineer
B-120 12 MAY 78
010

SITE PLAN

VILLAGE OF PERRY LAKE COUNTY, OHIO

for: B.G.M. CLIENT OWNER

ADDRESS STREET CITY ZIP

RUSTIC VILLAGE # 1		LOT	TRACT
SUBDIVISION	NAME	VOLUME	PAGE
7	GREEN RD.	PERM. PARCEL NO.	STREET
SUBLOT NO.		STREET	

LEGEND

SANITARY MANHOLE	WATER VALVE (GAS)
STORM MANHOLE	WATER METER (GAS)
INLET OR CATCH BASIN	AS BUILT ELEVATION
HYDRANT	INDICATES
EXISTING CONTOURS	DIRECTION OF
PROPOSED CONTOURS	SURFACE DRAINAGE
EXIST. ELEV.	100.0
100.0	PROP. ELEV.

REMARKS

ALL BOUNDARY DATA SHOWN WAS OBTAINED FROM (DEEDS, RECORDED SUBDIVISION PLAT OR OTHER PUBLIC RECORDS)

LOCATIONS AS SHOWN OF ADJACENT WELLS AND SEPTIC TANKS OBTAINED FROM LAKE COUNTY HEALTH DEPARTMENT

DESIGN CERTIFICATION

THIS PLAT WAS PREPARED BY ME, AND IS CORRECT TO THE BEST OF MY KNOWLEDGE AND BELIEF.

NAME: Edward J. White SURVEYOR REGISTRATION NO. 4511

CHECK LIST

NO. OF BEDROOMS	WATER MAIN SIZE, LOCATION
DIMENSIONS	SAN. SEWER SIZE % GR. LOC.
BEARINGS	SAN. MH. CAST ELEV. INV. ELEV.
TIE TO NEAREST STREET	SAN. CONN. SIZE, LOC. DEPTH
SUBLOT NO. PARCEL NO.	STORM SEWER SIZE % GR. LOC.
SURROUNDING OWNERS	STORM MH. CAST ELEV. INV. ELEV.
BLDG. DIMENSIONS FIN. GR.	PAVT. TYPE GRADE CURBS
BLDG. TIES F.L.B. GRADES	GAS LINE LOC. SIZE, PRESSURE
SEWER TYPE, WIDTH, THICKNESS	SEPTIC TANK LOCATION & DUPLICATION AREA
SIDWALK TYPE, WIDTH, THICKNESS	WELL LOCATION
CULVERT TYPE, DIA., LENGTH	ISOLATION RADIUS FROM WELL
ROCK OUTCROPPINGS	

REVISIONS			PLAN PREPARED BY:	
NO.	DATE	BY		
1	5/9/78	WJW	DEBEVEC - SALO & ASSOCIATES, INC.	
2			PAINESVILLE, OHIO	
3			DRAWN BY	SCALE
4			CHK'D.	DATE
5			CREW CHIEF	APP'D.

PHONE NO. 332-9250
DRAWING NO. 4811-7

"AS BUILT" CERTIFICATION

I, HEREBY CERTIFY THAT THE CIRCLED GRADES ARE EXISTING FINISH GRADES CHECKED IN FIELD ON 19 BY SURVEYING AND ARE CORRECT TO THE BEST OF MY KNOWLEDGE AND BELIEF.

REGISTERED SURVEYOR REG. NO.

TYPICAL SECTION
SCALE 1/2" = 1'-0"

MAY 10 1978

4811-7