

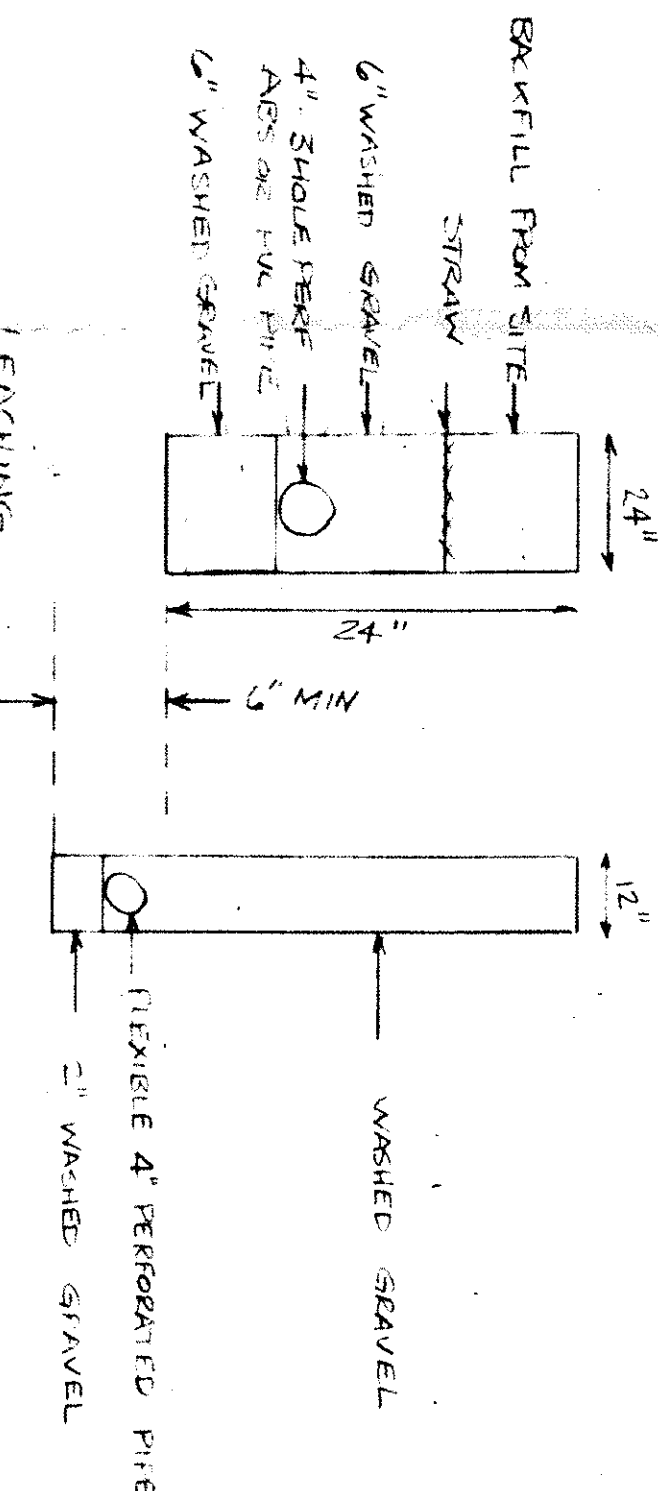


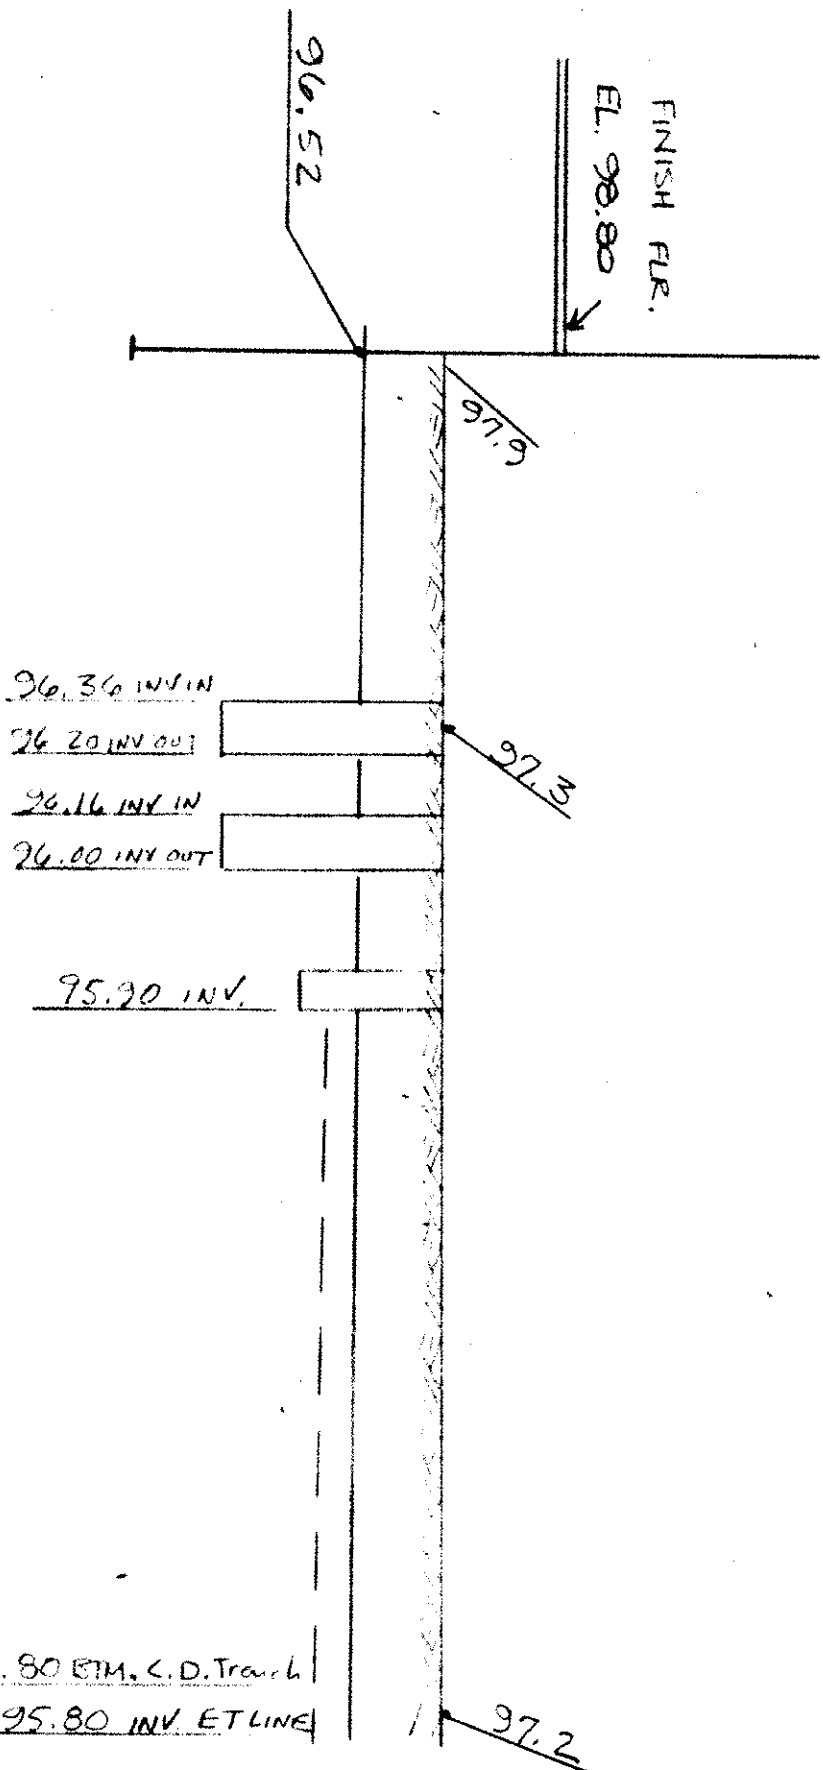

SEPTIC SYSTEM PROFILE

I, THE UNDERSIGNED HEREBY CERTIFY THAT THE TOPOGRAPHY SHOWN HEREIN, INDICATED BY ONE FOOT CONTOURS & ELEVATIONS REPRESENTS AN ACTUAL FIELD TOPOGRAPHIC SURVEY MADE BY ME ON THE 25TH DAY OF MARCH, 1991 AND THAT THE ELEVATIONS WERE TAKEN AT APPROPRIATE INTERVALS AND THAT AS OF THAT DATE THEY EXISTED AS SHOWN HEREON.

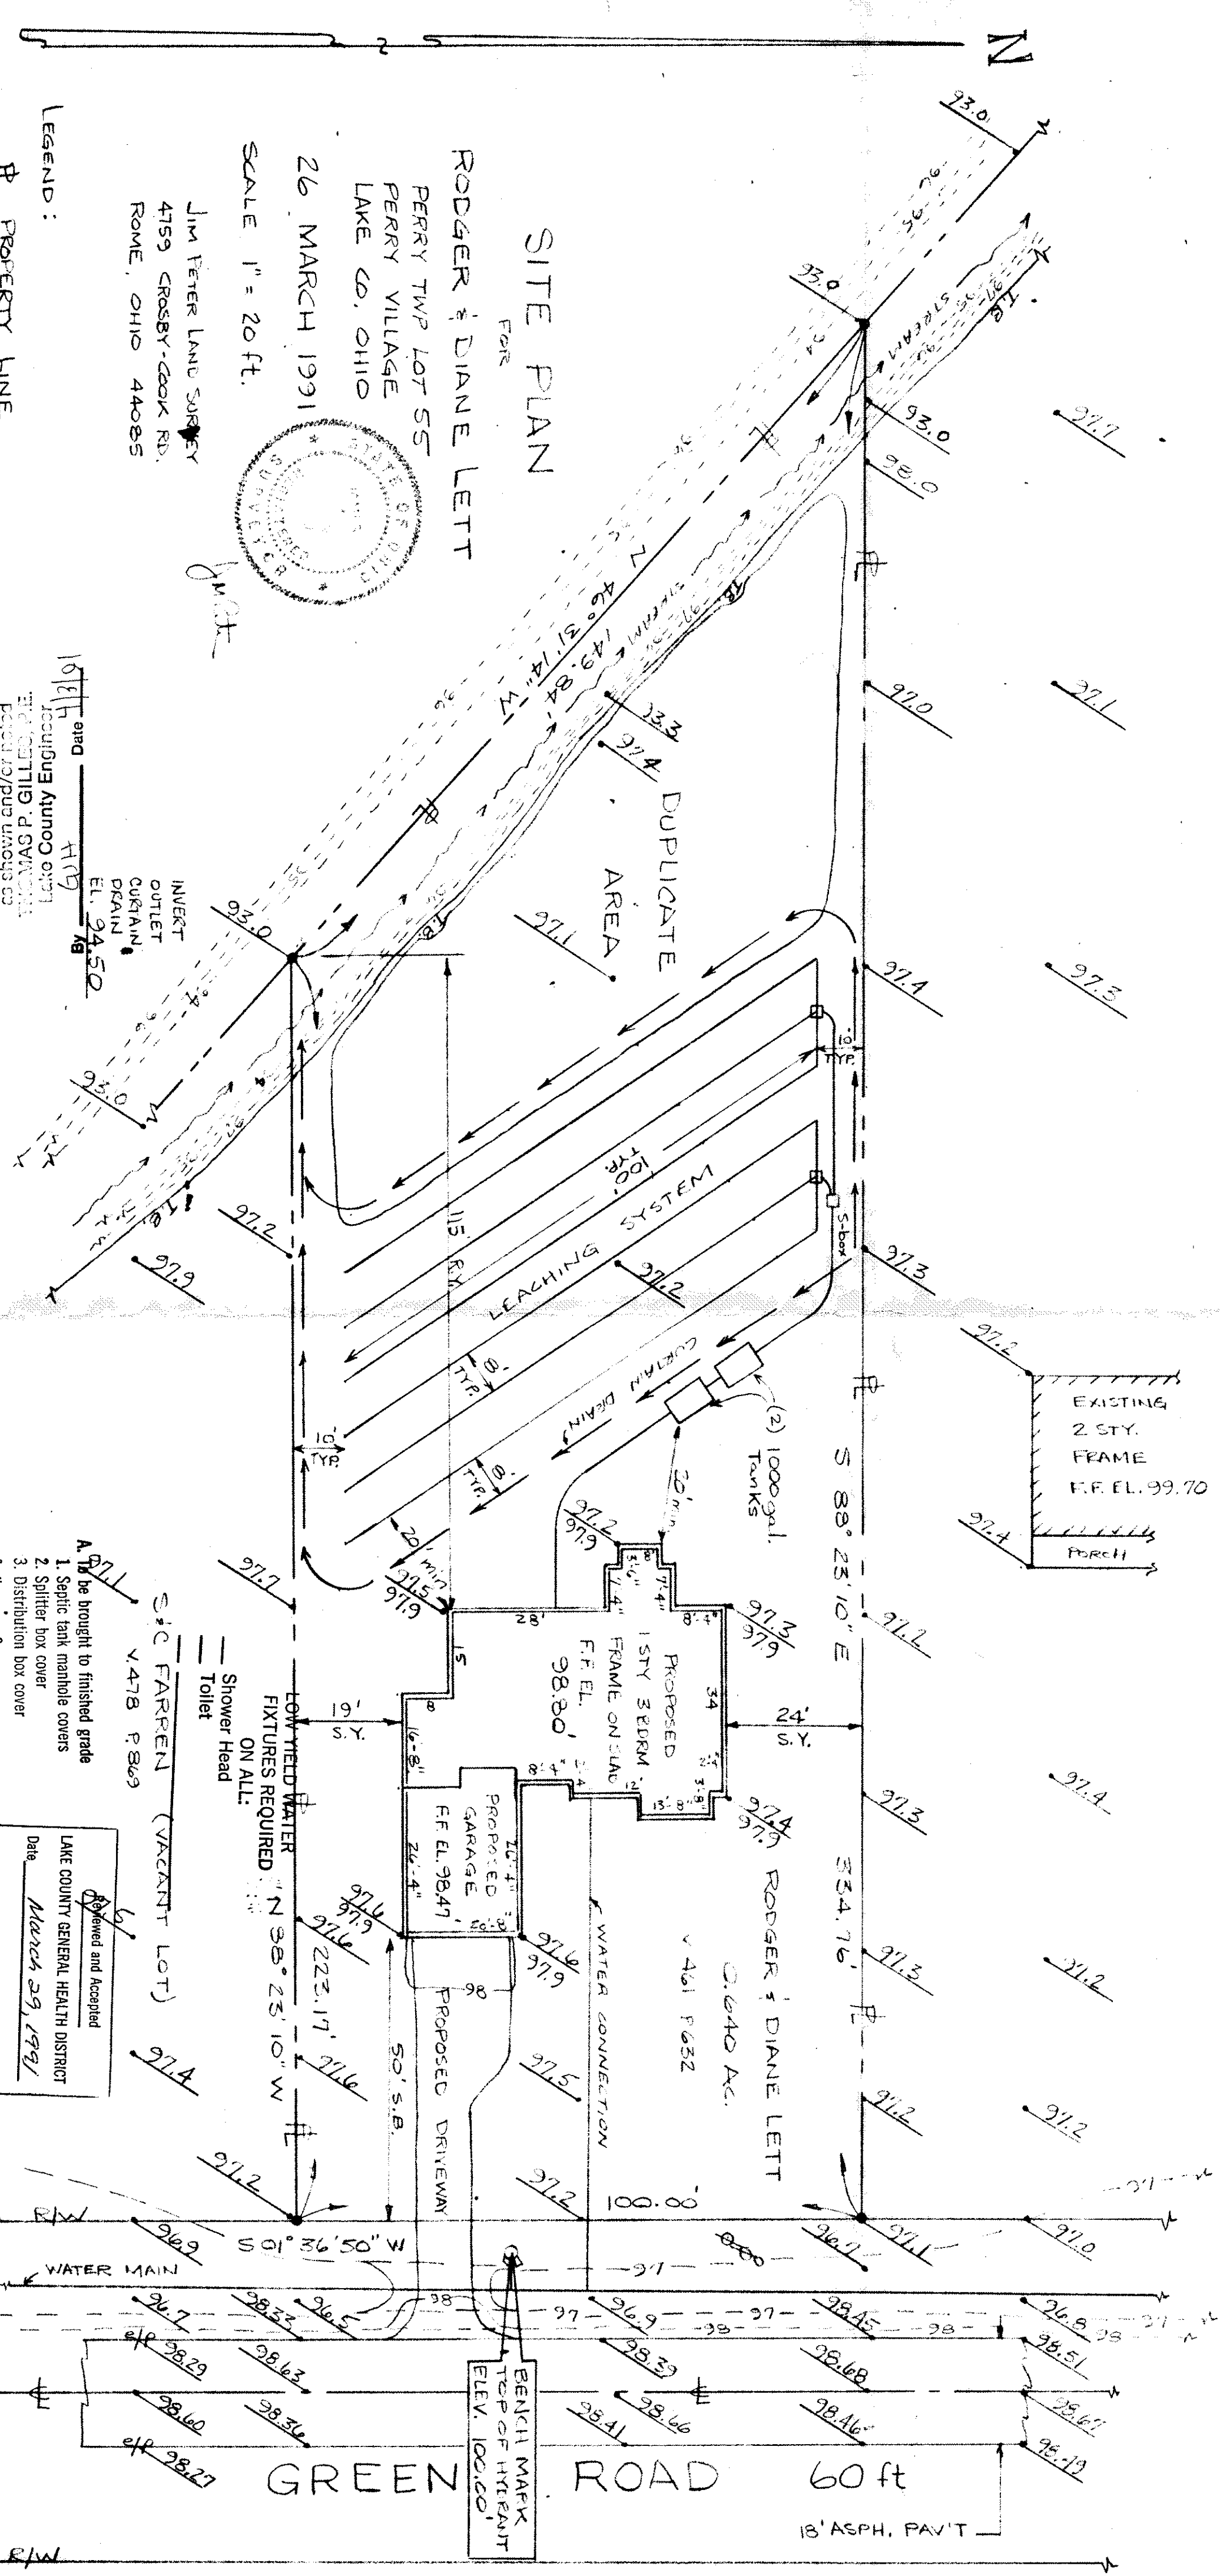

LEGEND:
 P PROPERTY LINE
 T.B. TOP OF BANK
 ---96--- EXISTING CONTOUR ELEVATION

Grading Plan Approved
 as shown and/or noted
 by
 MAS P. GILLESPIE, P.E.
 Lake County Engineer
 Date 4/19/91
 EL. 94.50

SEWAGE DISPOSAL PERMIT MUST BE OBTAINED BY A LAKE COUNTY LICENSED INSTALLER BEFORE INSTALLATION IS

NO FLOOR DRAINS OR DOWNSPOUTS TO BE DISCHARGED INTO SEPTIC TANKS
 A1 waste water to be discharged into septic tanks

Approved and Accepted
 LAKE COUNTY GENERAL HEALTH DISTRICT
 Date March 29, 1991
 JOEL LUCIA, R.S., M.P.H.
 Health Commissioner