

Name _____ Reg. No. _____

"I, the undersigned hereby certify that this topography indicated by 6", 1", or 2" contours, and elevations shown hereon represent an actual field survey made by me on the 14th day of May, 2010 and that the elevations were taken at appropriate intervals and that as of that date they existed as indicated hereon."

Maintenance
Erosion and sediment controls shall be inspected every seven(7) days or within 24 hours of a 0.5" or greater rainfall event. Necessary repairs shall be made at this time.

Stabilization of critical areas within fifty(50) feet of any stream or wetland shall be complete within two(2) days of the disturbance if the site is to remain inactive for longer than fourteen(14) days.



Disturbed areas of the site that are to remain idle for more than thirty(30) days shall be properly seeded and straw mulched within seven(7) days of completion of initial grading. Temporary seeding along the front of the lot shall be maintained on the site once the entire front of the lot shall be maintained on the site once initial grading is complete.

[Unintelligible] A stone access drive complete with underlying geo-textile fabric (20 feet wide and 50 feet long) for ingress and egress at the site shall be installed. This drive shall be the only entrance and exit to the site.

Erosion and Sediment Control Schedule

Temporary Seeding Species Selection			
Seeding Dates	Species	Lb./1,000 ft. ²	Per Ac.
March 1 to August 15	Oats	3	4 bushel
	Tall Fescue	1	40 lb.
	Annual Ryegrass	1	40 lb.
	Perennial Ryegrass	1	40 lb.
August 16 to November 1	Rye	3	2 bushel
	Tall Fescue	1	40 lb.
	Annual Ryegrass	1	40 lb.
	Wheat	3	2 bushel
	Tall Fescue	1	40 lb.
	Annual Ryegrass	1	40 lb.
	Perennial Ryegrass	1	40 lb.
	Annual Ryegrass	1	40 lb.
November 1 to Spring Seeding	Use much only, seeding practices or dormant seeding.		

Note. Other approved seed species may be substituted.

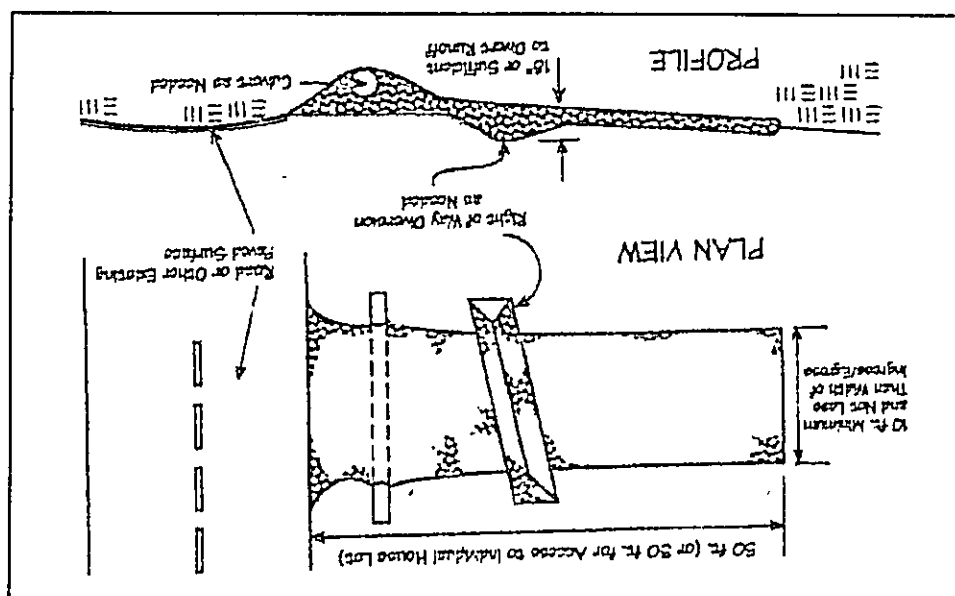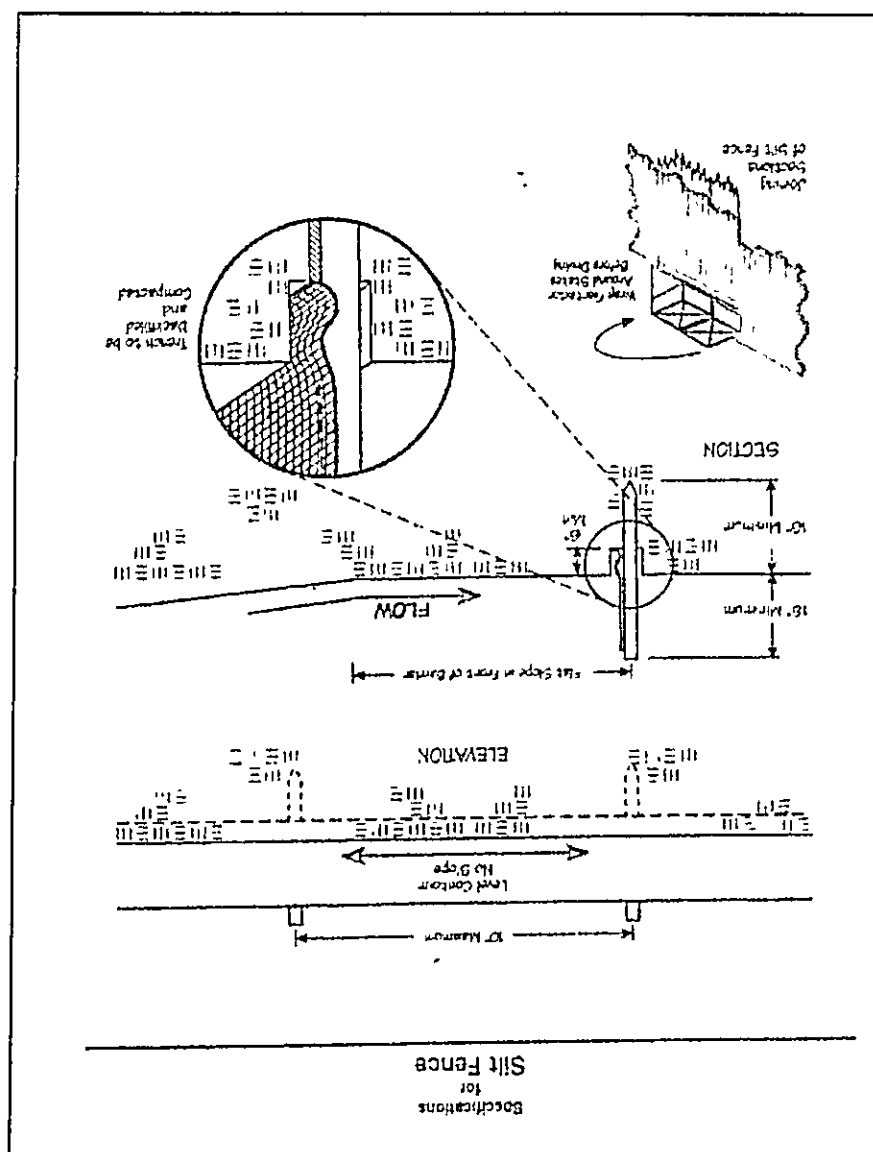

LEGEND AS BUILT ELEVATION: 1000 EAST. ELEV. 1000 PROP. ELEV. 1000 SURFACE DRAINAGE: 1000 DIRECTION OF: 1000 INDICATES: 1000 AS BUILT ELEVATION: 1000 EAST. ELEV. 1000 PROP. ELEV. 1000		REMARKS ALL BOUNDARY DATA SHOWN WAS OBTAINED FROM (DEEDS, RECORDED SUBDIVISION PLAT OR OTHER PUBLIC RECORDS) LOCATIONS AS SHOWN OF ADJACENT WELLS AND SEPTIC TANKS OBTAINED FROM LAKE COUNTY HEALTH DEPARTMENT	
DESIGN CERTIFICATION THIS PLAT WAS PREPARED BY ME, AND IS CORRECT TO THE BEST OF MY KNOWLEDGE AND BELIEF.			
CHECK LIST			
NO. OF BEDROOMS DIVISIONS BATHS NO. OF NEAREST STREET SURROUNDING OWNERS ELEV. DIMENSIONS FIN. ELEV. ELEV. TIES FLR. GRADES APRON TYPE WIDTH THICKNESS SIDEWALK TYPE DIA. LENGTH ROCK OUTCROPPINGS		NO. OF SEPTIC TANKS DIVISIONS BATHS NO. OF NEAREST STREET SURROUNDING OWNERS ELEV. DIMENSIONS FIN. ELEV. ELEV. TIES FLR. GRADES APRON TYPE WIDTH THICKNESS SIDEWALK TYPE DIA. LENGTH ROCK OUTCROPPINGS	
DESIGN CERTIFICATION THIS PLAT WAS PREPARED BY ME, AND IS CORRECT TO THE BEST OF MY KNOWLEDGE AND BELIEF.			
REVISIONS			
NO. DATE BY		PLAN PREPARED BY:	
BABCOCK & ASSOCIATES, INC.		PAINESVILLE, OHIO	
DRAWING NO. 440-357-1811		SCALE 1" = 40'	
DATE 3/26/04		APP'D. 181	
00-175-43		181	