
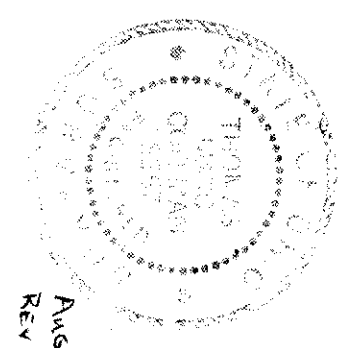


SITE PLAN
FOR
LARRY BRAINARD JR.
 BEING PARCEL NO. 14 ON MAIN STREET IN
 IN THE VILLAGE OF PERRY LAKE COUNTY, OHIO

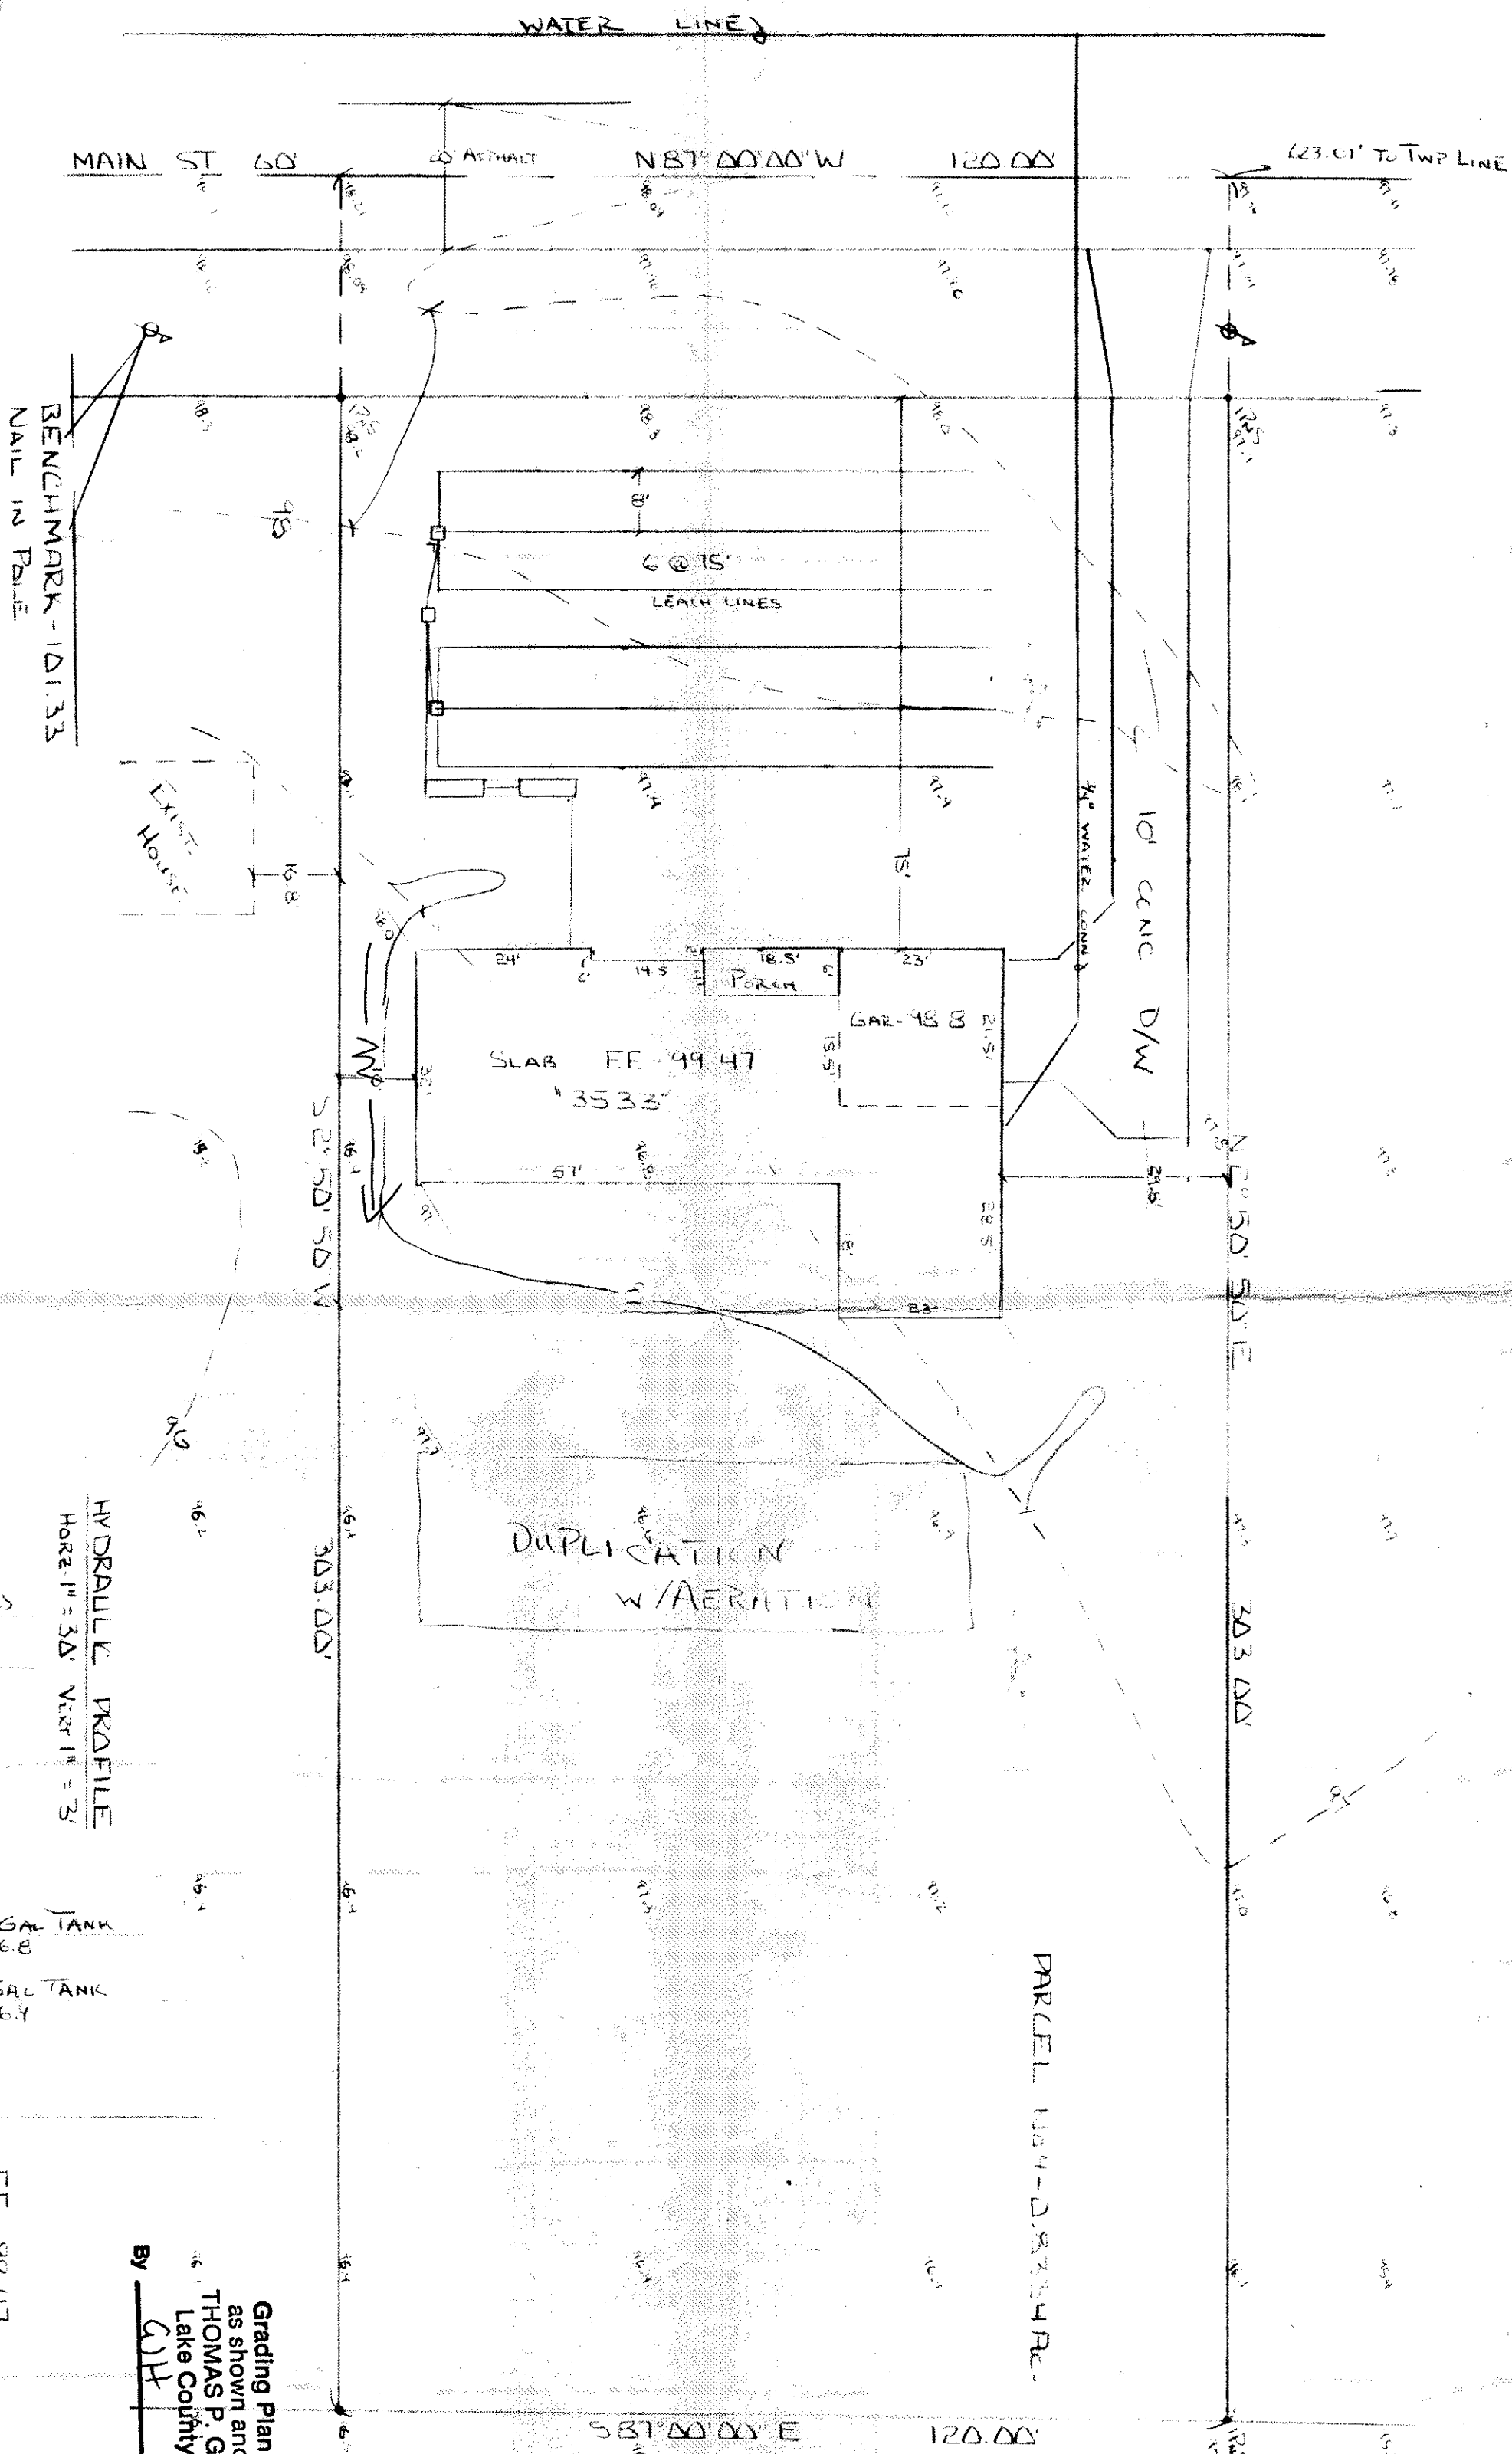

I, the undersigned hereby certify that this topography, indicated by 1" contours and elevations shown hereon represent an actual field survey made by me on Aug. 14, 1991 and that the elevations were taken at appropriate intervals and that as of that date they existed as indicated hereon.


J.M. Coffman P.S.
 No. 657

VILLAGE SURVEYING Co.
 202 THIRD ST. FAIRPORT HBR. OH 44017
 (216) 357-1351



LOW YIELD WATER
 FIXTURES REQUIRED
 ON ALL:
 Shower Head
 Toilet

SEWAGE DISPOSAL PERMIT MUST BE
 OBTAINED BY A LAKE COUNTY LICENSED
 INSTALLER BEFORE INSTALLATION IS
 STARTED.

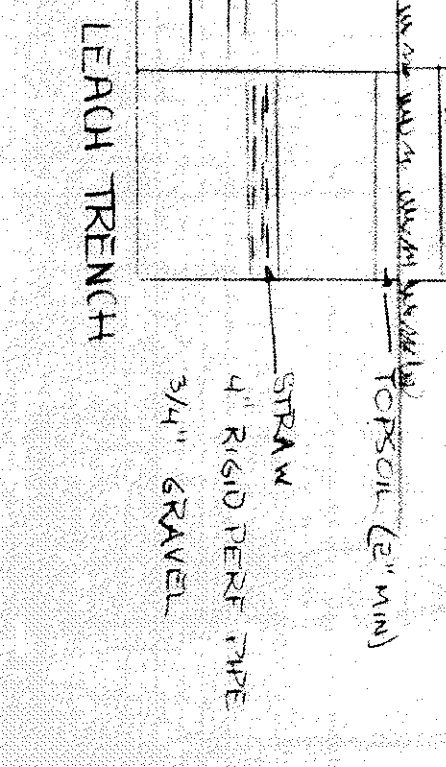

Grading Plan Approved
 as shown and/or noted
 THOMAS P. GILLES, P.E.
 Lake County Engineer
 By TH Date 8/31/91

Reviewed and Accepted
 LAKE COUNTY GENERAL HEALTH DISTRICT
 Date 8.29.91
 JOEL LUCIA, R.S., M.P.H.
 Health Commissioner
 By N. Nielsen

- A. To be brought to finished grade
- 1. Septic tank manhole covers
- 2. Splitter box cover
- 3. Distribution box cover
- B. No footer drains or downspouts to be discharged into septic tanks
- C. All waste water to be discharged into septic tanks

LAKE COUNTY NURSERY INC.
 VOL. 571-110