
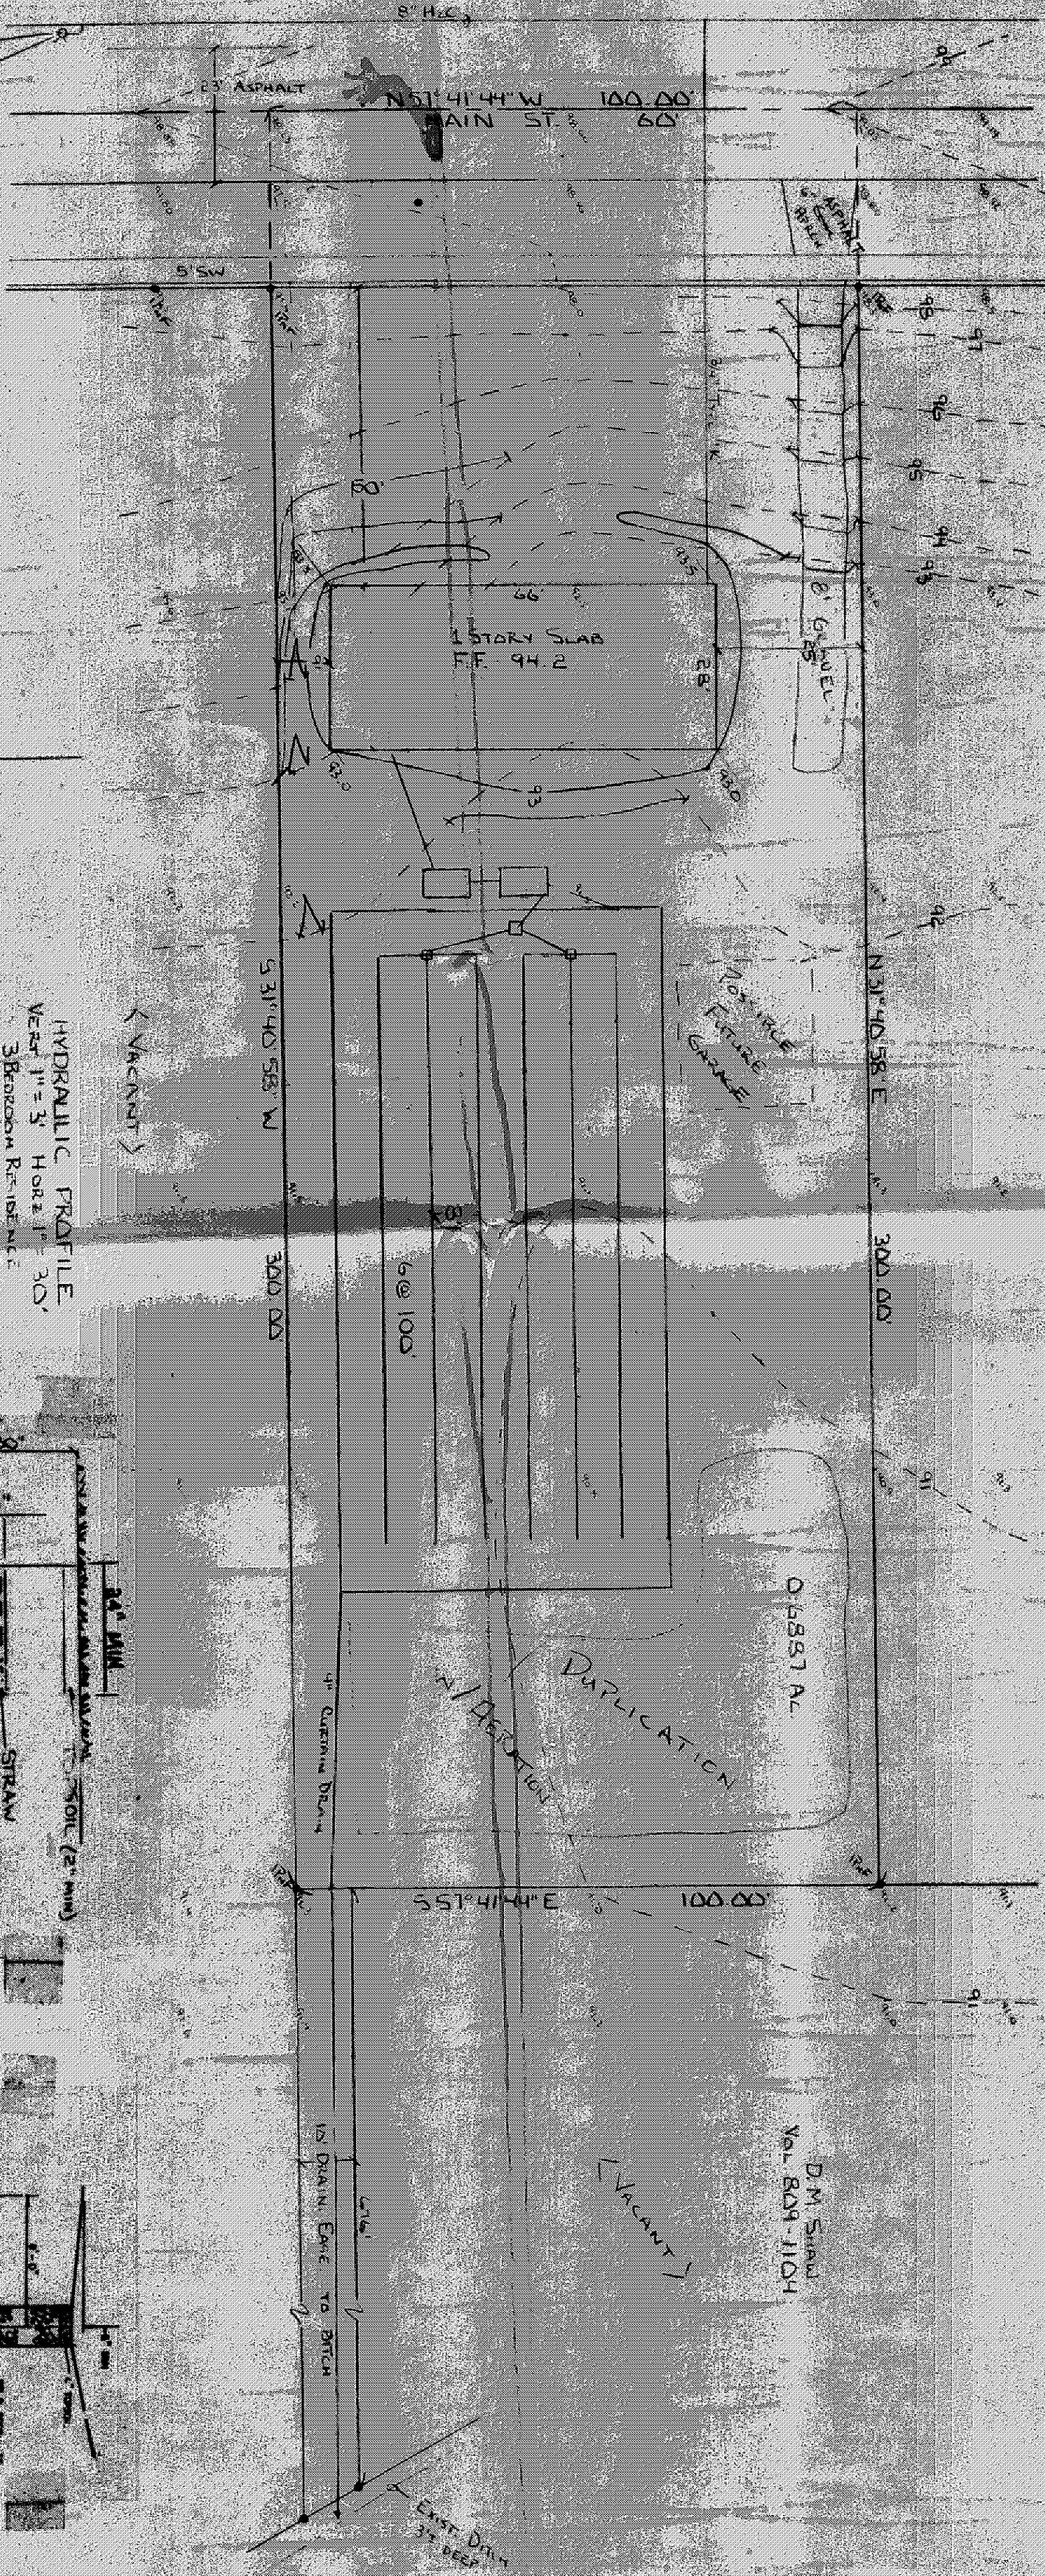


SITE PLAN
 FOR
MIKE & LINDA MEDLEN
 BEING PP 4A 44D 044 IN THE VILLAGE
 OF PEERY COUNTY OF LAKE STATE OF OHIO

S.T. MORAND
 VOL 532 - PG 59

D.M. SHAW
 VOL 809 - PG 1104

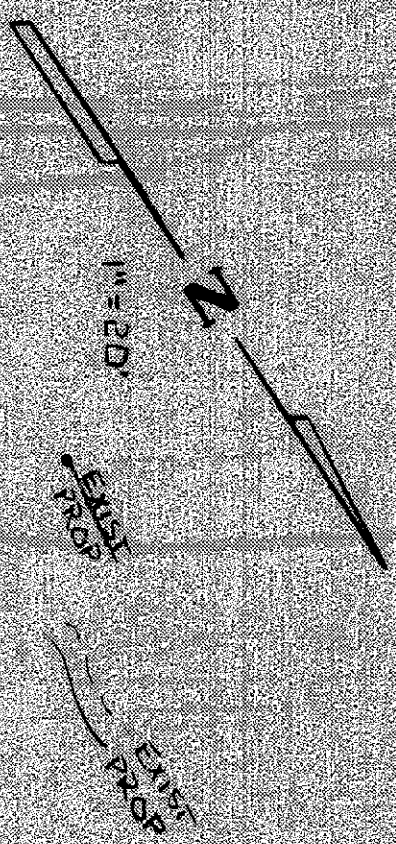


BENCHMARK
 100.00
 Top Bench 11/19/93



Grading Plan Approved
 as shown and/or noted
THOMAS P. GILLES, P.E.
 Lake County Engineer
 By G.H. Date 5.2.93

**ROOF DRAINS
 SHALL DISCHARGE
 TO SPLASH BLOCKS.**

VILLAGE SURVEYING CO.
 242 TULLOCH ST. FAIRPORT HARBOR, OH 44131
 (216) 351-1359

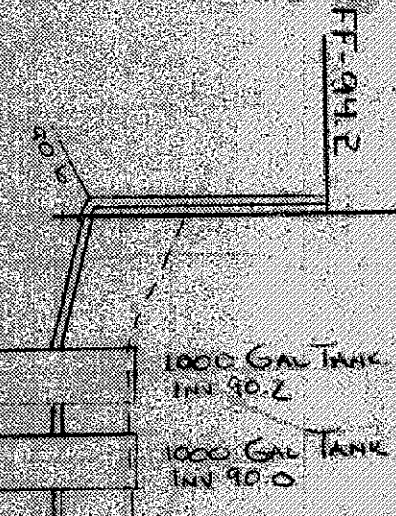

HYDRAULIC PROFILE
 VERT. 1" = 3' HORIZ. 1" = 30'
 3 Bedroom Residence

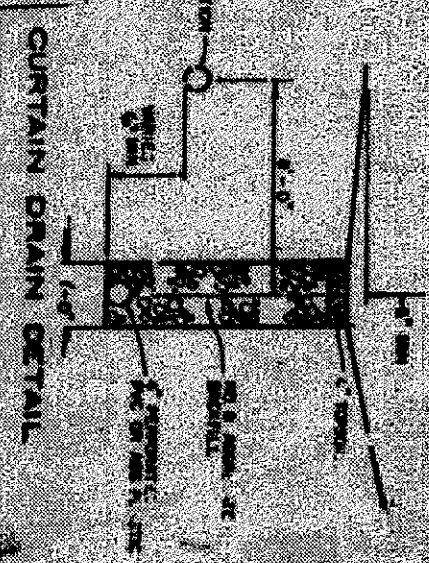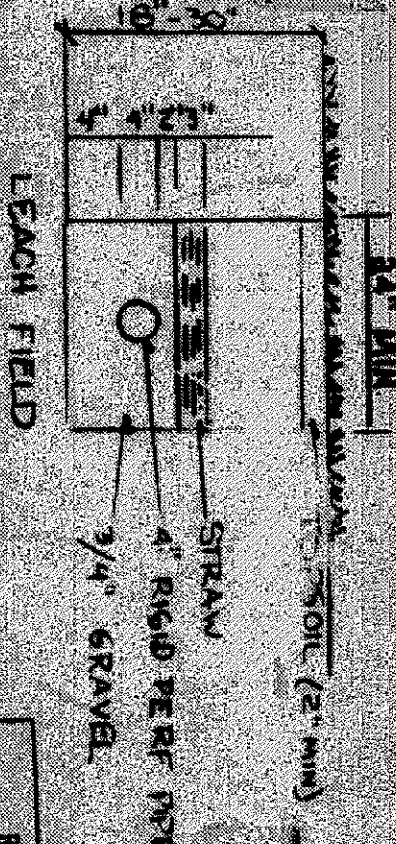

**LOW YIELD WATER
 FIXTURES REQUIRED
 ON ALL:**

- 1. Shower Head
- 2. Toilet
- 3. Distribution box cover

**SEWAGE DISPOSAL PERMIT MUST BE
 OBTAINED BY A LAKE COUNTY LICENSED
 ENGINEER**

Reviewed and Accepted
LAKE COUNTY GENERAL HEALTH DISTRICT
 Date April 19, 1993
 By JOEL LUDAK, R.S., M.P.H.
 Health Commissioner

Mr. Medlen should call