

SITE PLAN

for : GARY WHEELER CLIENT

972 CENTER ROAD EASTLAKE
ADDRESS STREET CITY

1 PORTSMOUTH COLONY No. 1 22 29
SUBLOT No. SUBDIVISION NAME VOL. PAGE
65 PERRY VILLAGE OHIO
LOT TRACT




DESIGN CERTIFICATION

THIS PLAN WAS PREPARED BY ME AND IS CORRECT TO THE BEST OF MY KNOWLEDGE AND BELIEF.

NAME

CHECK LIST

LOT DIMENSIONS & BEARINGS
BE TO NEAREST 1/4" (1/4" = 1/4")
SUBLOT No. (PARCEL No.)
SURVEYING METHOD
FIELD NOTES
FIELD BOOKS
FIELD SKETCHES
FIELD MAPS
FIELD PHOTOGRAPHS
FIELD MEASUREMENTS
FIELD CALCULATIONS
FIELD CORRECTIONS
FIELD ADJUSTMENTS
FIELD VERIFICATION
FIELD REVISIONS
FIELD FINAL CHECK
FIELD SIGNATURE
FIELD DATE

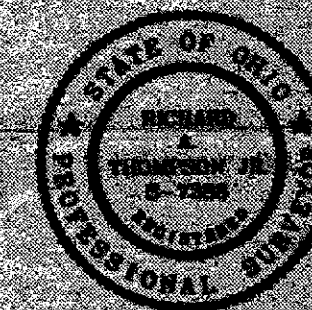

STATE SEAL

"AS BUILT" CERTIFICATION

I HEREBY CERTIFY THAT THE CIRCLED INFORMATION IS EXISTING AS OBTAINED ON THE BEST SITE 1998 AND IS CORRECT TO THE BEST OF MY KNOWLEDGE AND BELIEF.

NAME


LEGEND

STORM MANHOLE
SANITARY MANHOLE
EXISTING CONTOURS
PROPOSED CONTOURS
DRAINAGE DIRECTION
DIRECTION OF SURFACE DRAINAGE

DRAWN BY	SCALE
JRP/TOPO.dwg	1"=20'
CHECKED BY	DATE
RAT	APRIL 7, 1998
1	
2	



BENCHMARK

TBM - Rim Sanitary Manhole in Front of S/L 1
Elevation: 698.90

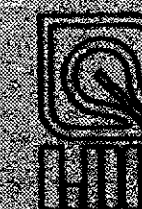

WHEEC1-9801

GRAPHIC SCALE

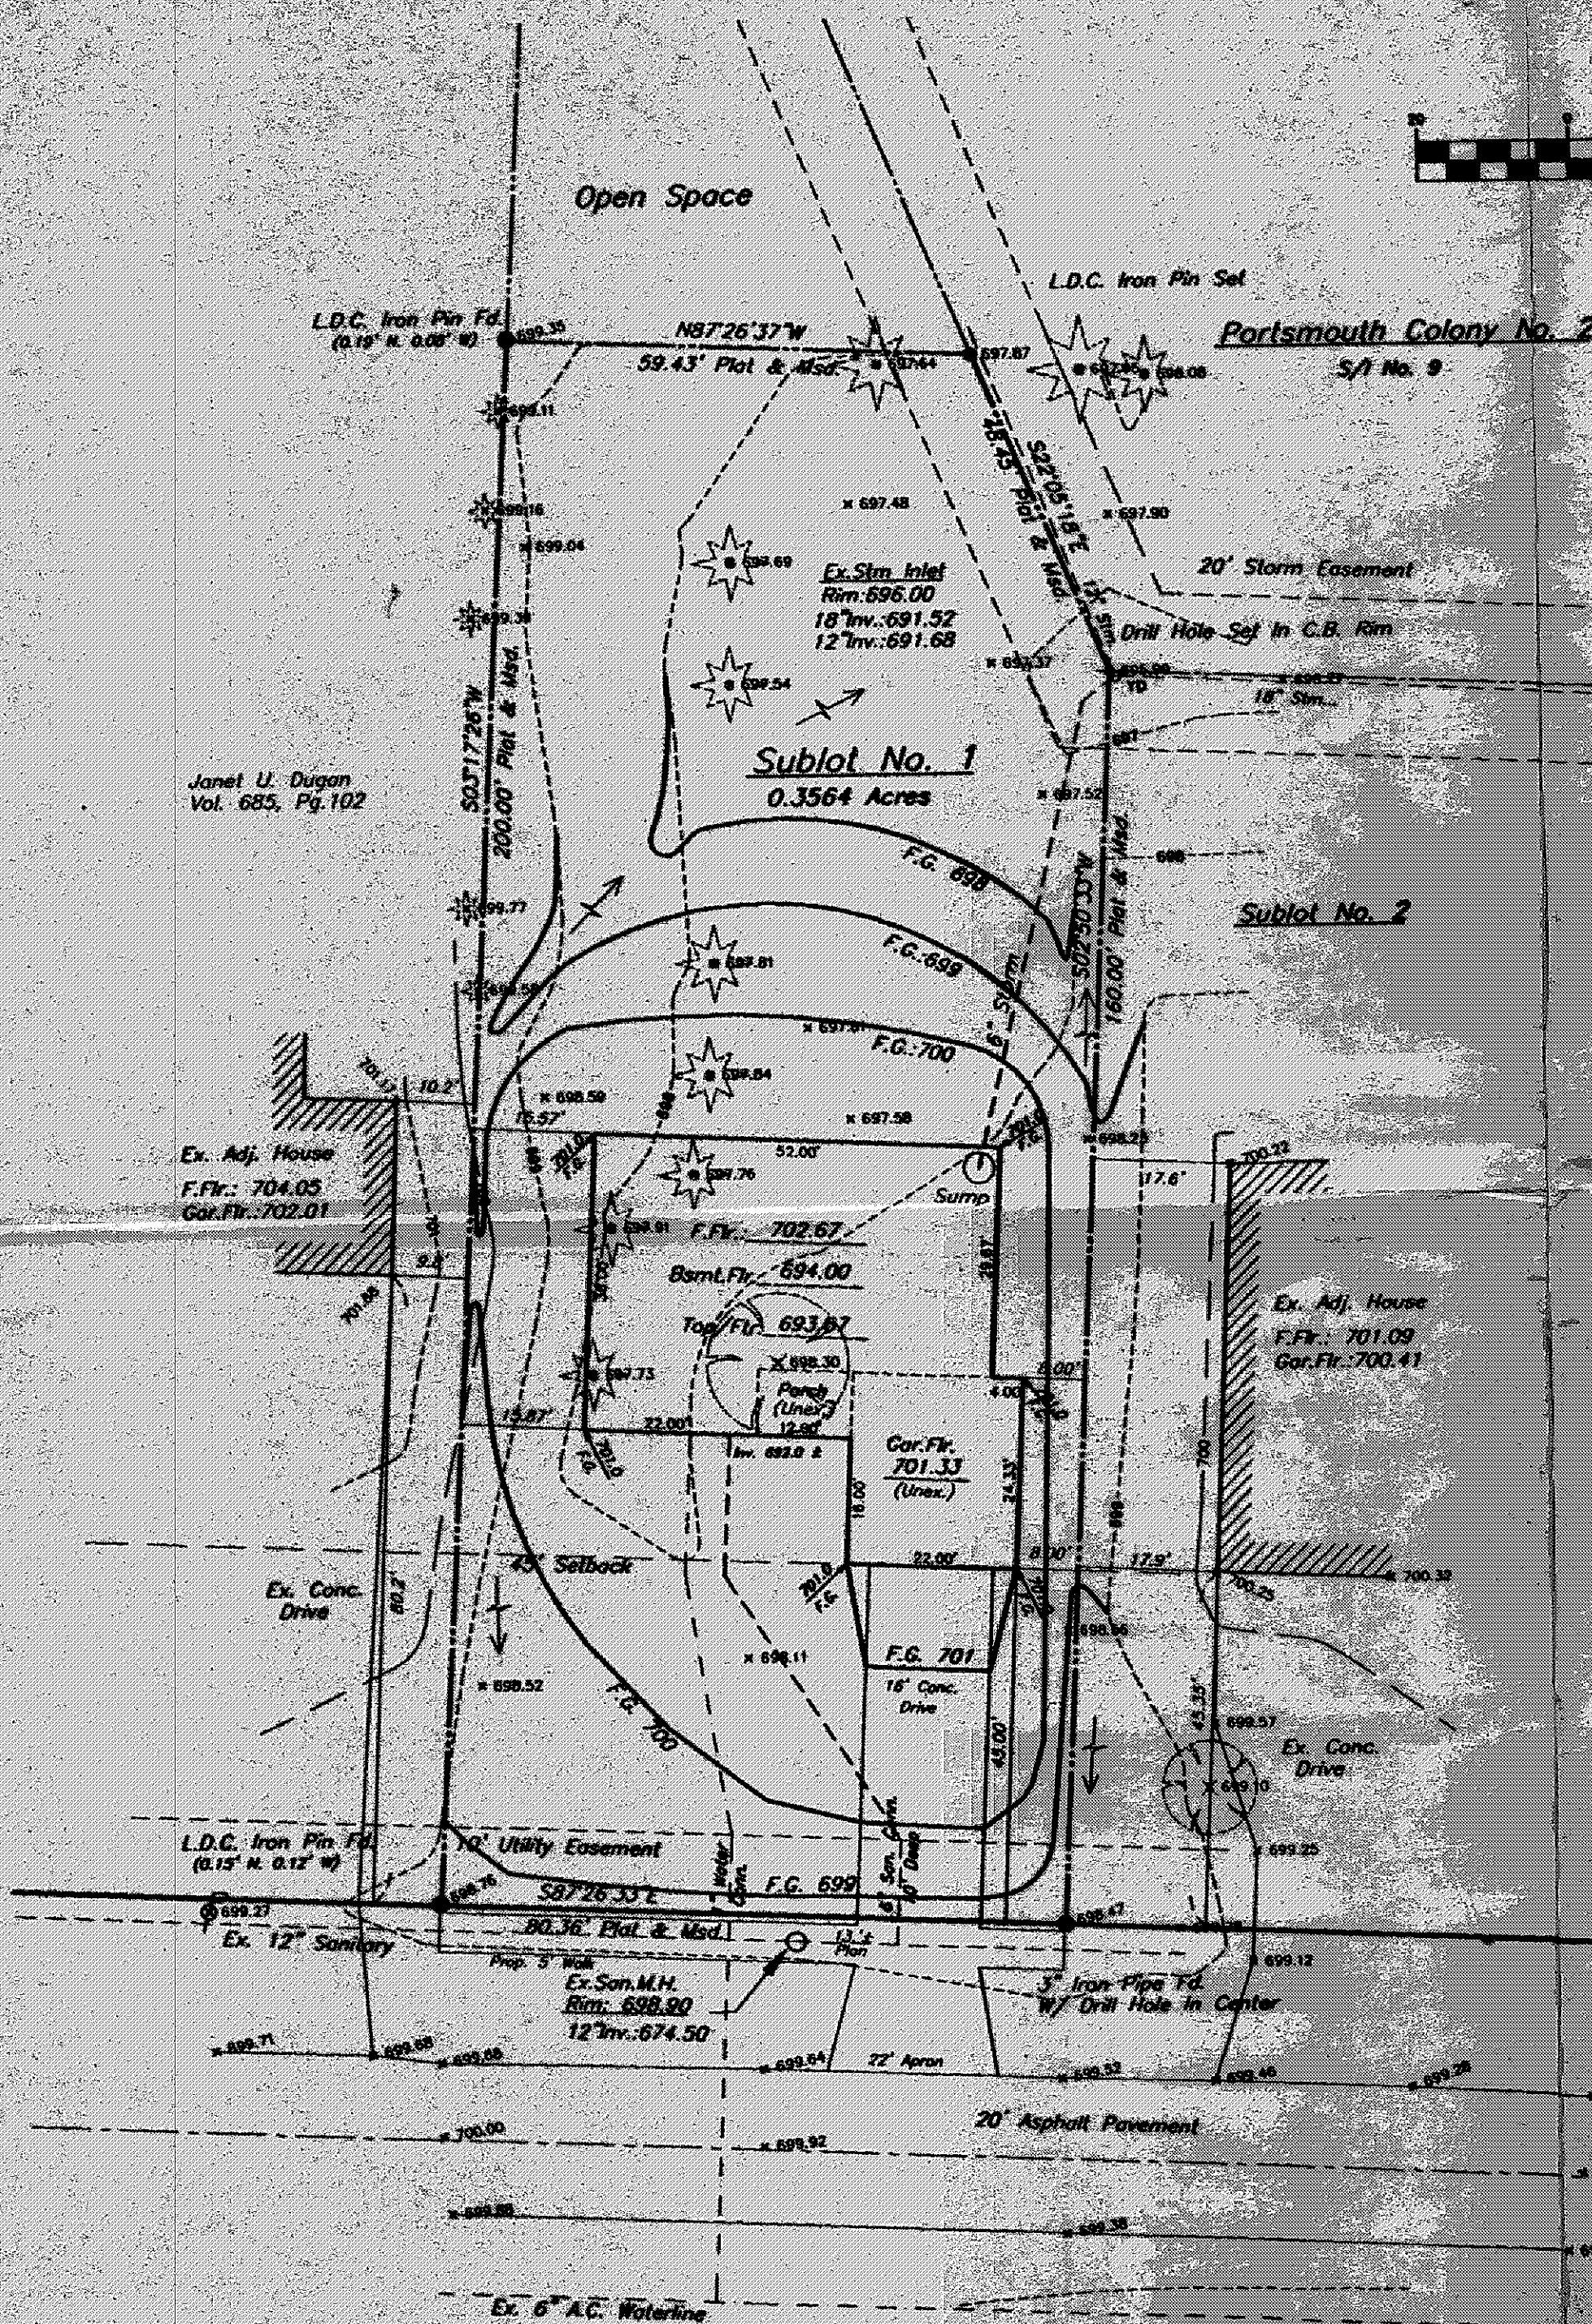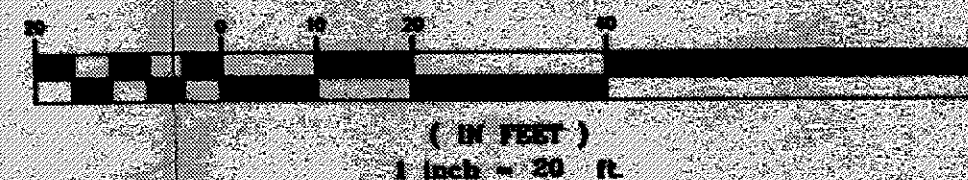

Note: Builder Shall Verify Ground Water Table Prior To Establishing Basement Floor Elevation.

See Architects Plans For Complete House Dimensions

I, THE UNDERSIGNED, HEREBY CERTIFY THAT THIS TOPOGRAPHY, INDICATED BY 6', 1', OR 2' CONTOURS, AND ELEVATIONS SHOWN HEREON, REPRESENT AN ACTUAL FIELD SURVEY MADE BY ME ON THE DAY OF APRIL 1998 AND THAT THE ELEVATIONS WERE TAKEN AT APPROPRIATE INTERVALS AND THAT AS OF THAT DATE THEY EXISTED AS INDICATED HEREON.

(NAME)

Grading Plan Approved as shown and/or noted
THOMAS P. GILLES, P.E.
Lake County Engineer

By 6/14 Date 4-14-98

MANCHESTER ROAD 60'