

I, THE UNDERSIGNED HEREBY CERTIFY THAT THE TOPOGRAPHY SHOWN HEREON, INDICATED BY ONE FOOT CONTOURS & ELEVATIONS REPRESENTS AN ACTUAL FIELD TOPOGRAPHIC SURVEY MADE BY ME ON THE 23RD DAY OF JULY, 1991 AND THAT THE ELEVATIONS WERE TAKEN AT APPROP. INTERVALS AND THAT, AS OF THAT DATE, THEY EXISTED AS SHOWN HEREON

Jim Ritz

Reviewed and Accepted
LAKE COUNTY GENERAL HEALTH DISTRICT
Date 8.1.91

JOEL LUCA, R. S. M. P. H.
Health Commissioner

By N. Williams

SEWAGE DISPOSAL PERMIT MUST BE OBTAINED BY A LAKE COUNTY LICENSED INSTALLER BEFORE INSTALLATION IS STARTED.

- A. To be brought to finished grade
1. Septic tank manhole covers
 2. Splitter box cover
 3. Distribution box cover
- B. No footer drains or downspouts to be discharged into septic tanks
- C. All waste water to be discharged into septic tanks

Grading Plan Approved
as shown and/or noted
THOMAS P. GILLES, P.E.
Lake County Engineer
By GJH Date 8/1/91

LOW YIELD WATER
FIXTURES REQUIRED
ON ALL:

Shower Head
Toilet

SITE PLAN

FOR

DAVE WELCH

5/4 24 RUSTIC VILLAGE SORD. #2

PERRY VILLAGE, LAKE CO, OHIO

PLAT BK "Y" PG. 13



JULY 24, 1991

REV 30, JULY 1991

---99--- EXISTING ELEVATION

---100--- PROPOSED ELEVATION

JIM PETER LAND SURVEY
4759 CROSBY-COOK RD
ROME, OHIO 44085

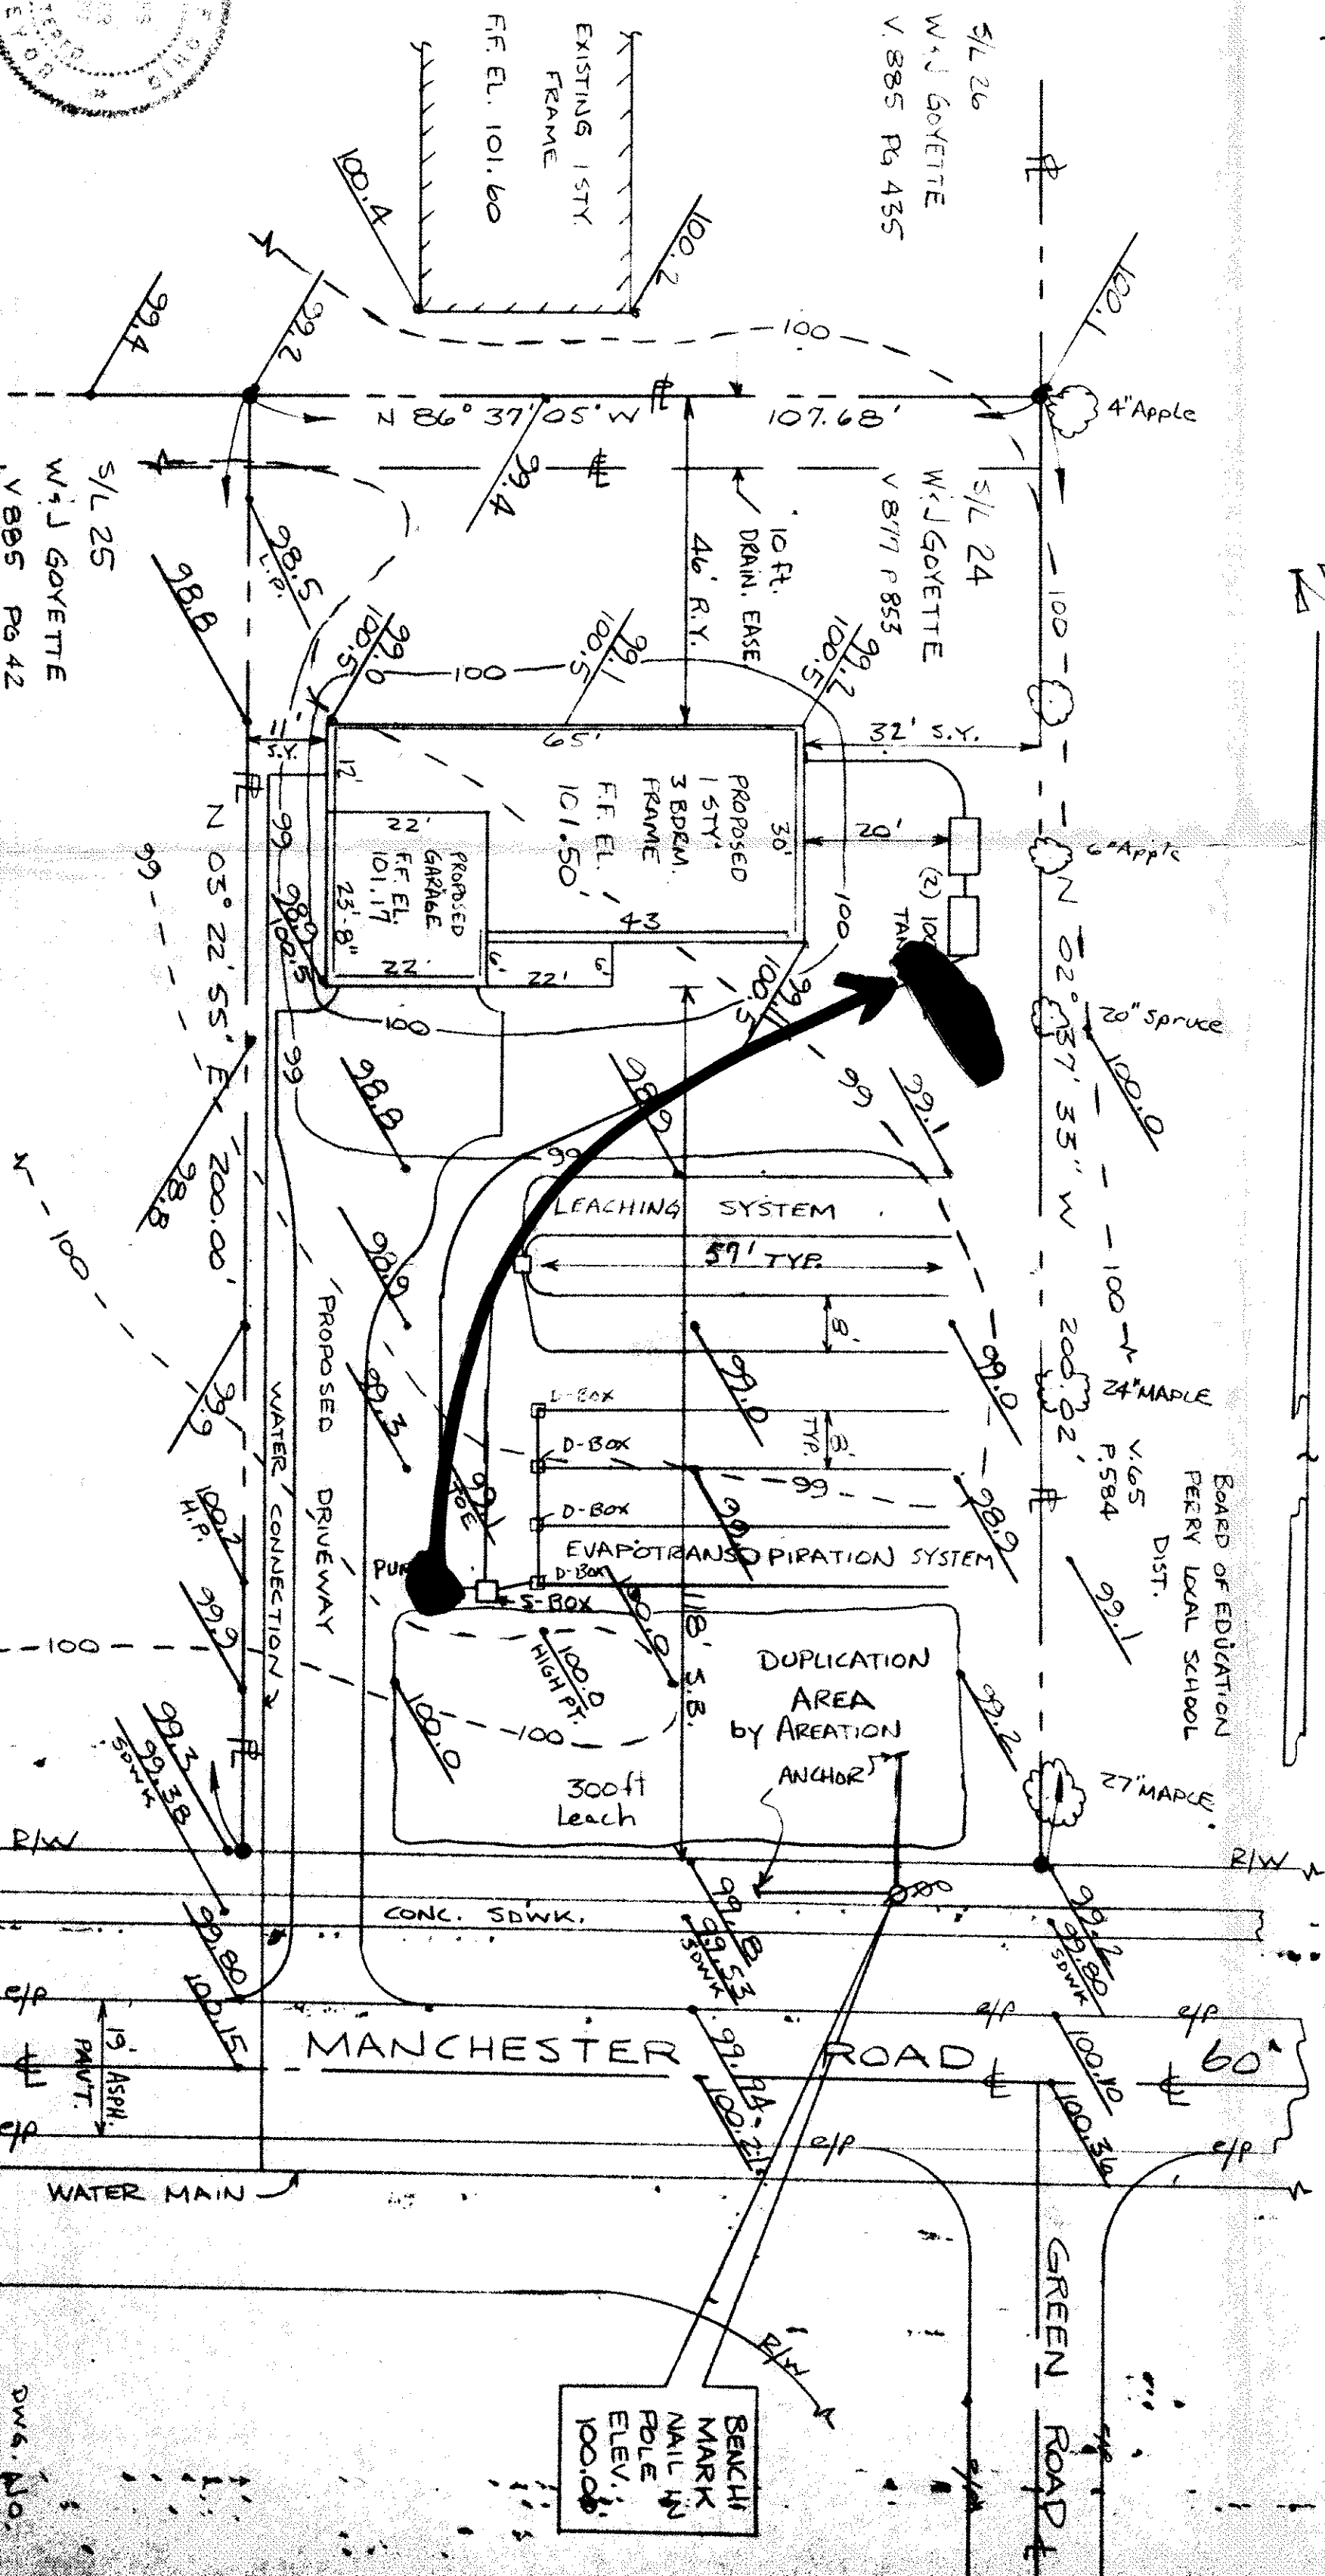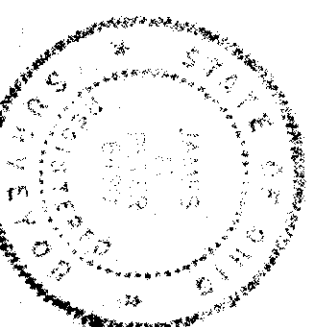

SEPTIC SYSTEM PROFILE

