


## SURVEY AND SITE PLAN DAVID & DEBORAH ROSTOCIL

BEING S/L 28 PORTSMOUTH COLONY SUBDIVISION  
PHASE II IN THE VILLAGE OF PERRY COUNTY OF  
LAKE AND STATE OF OHIO PLAT VOL. 166, P. 19  
PAGE 30 LCRM.

PLAT  
BEARINGS

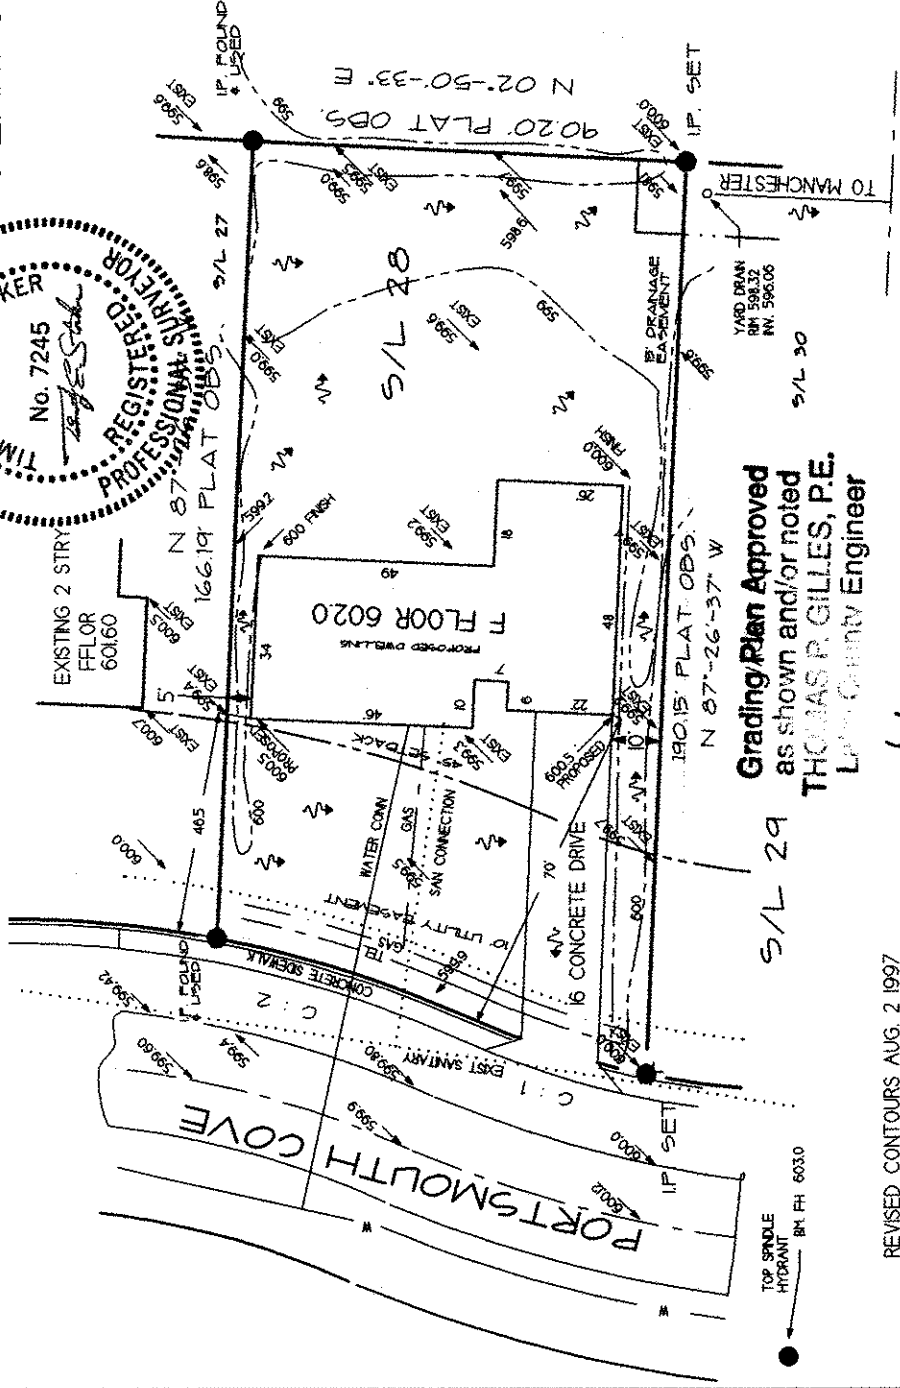


REVISED CONTOURS AUG. 2 1997

By 6JH 8.5.97

| CURVE DATA PER PLAT |         |                |              |
|---------------------|---------|----------------|--------------|
| CURVE #             | RADIUS  | BEARING        | CHORD LENGTH |
| C 1                 | 170.00' | N 17°-51'-37\" | 38.77'       |
| C 2                 | 230.00' | N 17°-34'-54\" | 54.67'       |

SCALE 1 INCH = 40 FEET

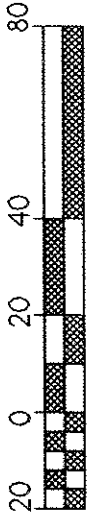

THIS SURVEY WAS PERFORMED TO AN ACCURACY  
AS SET FORTH IN THE OHIO ADMINISTRATIVE CODE  
4733-37 AND ALTA URBAN ACCURACY.

ORDER AS SAVED 1626PLOT  
SAID SURVEY PERFORMED JULY 1997  
COPYRIGHT 1997 CRABBS' SURVEYING SERVICE

CHICAGO TITLE ORDER NO. 800240-E

### LEGEND

- MEAS. IRON PIN FOUND\SET
- ODS. IRON PIPE FOUND\SET
- CALC. MEASURED
- DEED. CALCULATED
- PLAT. DEED RECITED

UTILITY POLE  
RUNOFF DIRECTION