

for: ROY LAKATOS

ADD

STREET

CITY

5

LSAC LSAC

and

1000

THE NORTH COASTSM ENGINEERING AND SURVEYING CO., INC.
2570 SUPERIOR AVE., SUITE 501
CLEVELAND, OHIO 44114
TEL. (216) 241-7070 FAX (216) 241-7071

CHECK LIST

LOT DIMENSIONS & BEARINGS
TIE TO NEAREST STREET
SUBLOT No. (Parcel No.)
SURROUNDING OWNERS
BUILDING DIMENSIONS
SETBACK, SIDEYARD, REARYARD
FINISHED GRADDES
DRIVE & ABBON TYPE, WIDTH, THICKNESSES
SIDEWALK TYPE, WIDTH, THICKNESS
CULVERT TYPE, DIAM., LENGTH
WATER MAIN SIZE, LOCATION
SAN, SEWER SIZE, GRADE, LOCATION
SAN, MAIN CAST ELEV., INY. ELEV.
SAN, CONN. SIZE, GRADE, LOCATION
STORM SEWER SIZE, GRADE, LOCATION
STORM M.H. CAST ELEV., INY. ELEV.
PAV'T. TYPE, GRADE, CURBS
GAS LINE LOC., SIZE
SEPTIC SYSTEM & DUPLICATION
WELL LOCATION & ISOLATION RADIIUS

DESIGN CERTIFICATION

THIS PLAT WAS PREPARED BY ME, AND IS CORRECT
TO THE BEST OF MY KNOWLEDGE

NAME

—

"AS-BUILT" CERTIFICATION

I HEREBY CERTIFY THAT THE CIRCLED INFORMATION IS EXISTING
AS OBTAINED ON THE SITE 19 AND IS
CORRECT TO THE BEST OF MY KNOWLEDGE AND BELIEF.

LEGEND

STORM MANHOLE 0
SANITARY MANHOLE 0
EXISTING CONTOURS ---
PROPOSED CONTOURS ---
EXIST. ELEV. 100.0
100.0 PROP. ELEV.
DIRECTION OF SURFACE DRAINAGE →

BENCHMARK: RIM OF STAD. M.H. SIL 38-39
ELEV. 105.10

I THE UNDERSIGNED HEREBY CERTIFY THAT THE TOPOGRAPHY SHOWN HEREON INDICATED BY 2 FOOT CONTOURS AND ELEVATIONS REPRESENT AN ACTUAL FIELD TOPOGRAPHIC SURVEY MADE BY ME ON THE 8th DAY OF AUGUST, 1998 AND THAT THE ELEVATIONS WERE TAKEN AT APPROXIMATE INTERVALS AND THAT AS OF THAT DATE THEY ENDED AS INDICATED HEREON.


Grading Plan Approved
as shown and/or noted
THOMAS P. GILLES, P.E.
Lake County Engineer
By GDH Date 8/1

By

Date 8

DEAD SPOTS SHALL BE
SPRASH BLOCKED.

HYDRAULIC PROFILE
H: 1" = 30'
V: 1" = 5'

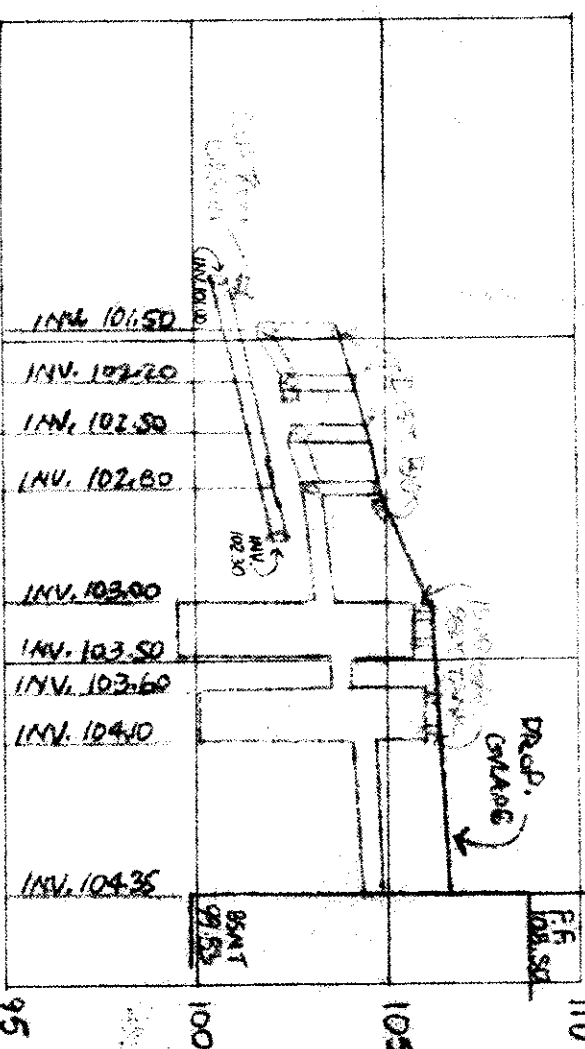

Reviewed and Accepted _____

 LAKE COUNTY GENERAL HEALTH DISTRICT

 Date _____

 JOEL LUCIA, R. S., M. P. H.
 Health Commissioner

 BY _____

Received and Accepted
 LANE COUNTY GENERAL HEALTH DISTRICT
 Date 8-14-91

 JOEL LUCIA, R. S., M. P. H.
 Health Commissioner
 BY David Deane Thurman

SEWAGE DISPOSAL PERMIT MUST BE
OBTAINED BY A LAKE COUNTY LICENSED
INSTALLER BEFORE INSTALLATION IS
STARTED.

LOW YIELD WATER
FIXTURES REQUIRED
ON ALL:

Shower Head

1994

5/1/39

5141

R/W CURVE DATA

E	= 62.00"
Δ	= 48° 53' 16"
A	= 51.17'
C	= 49.44'
S	= 65° 46' 35" E.

TRENCH DETAIL

