


10' DRIVEWAY
EXISTING


5/4.40
UNCURNT

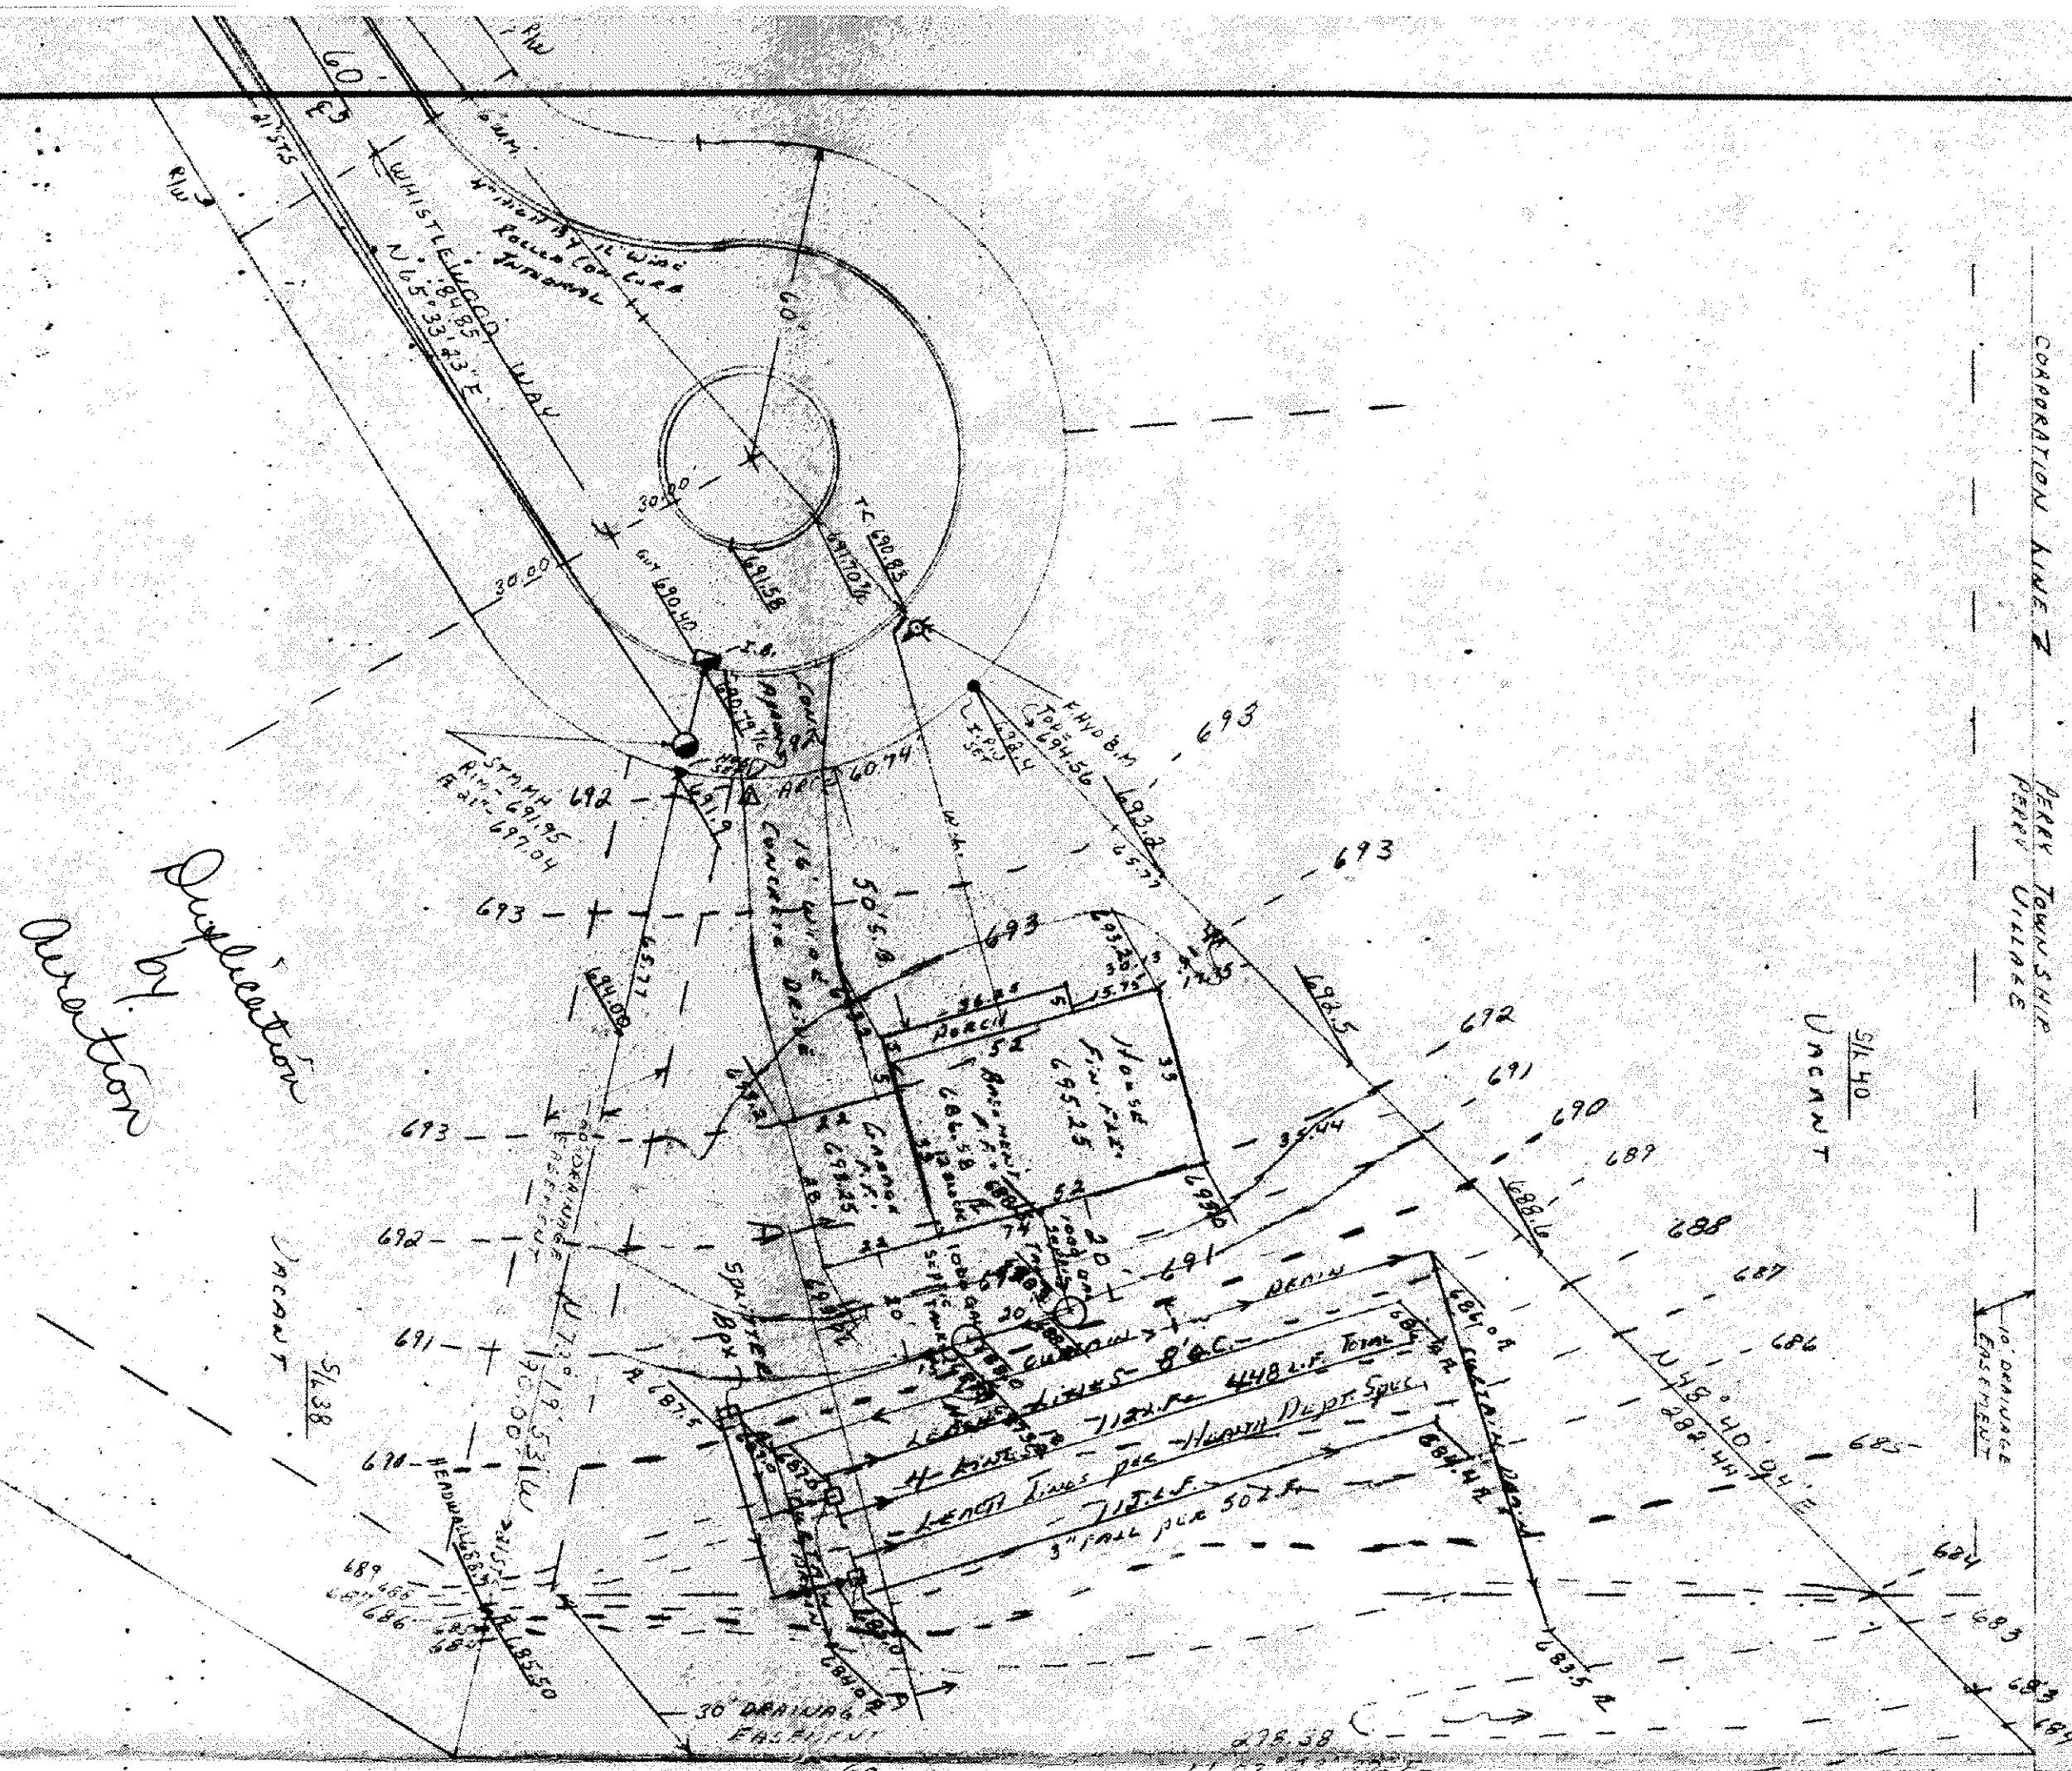

A. PLU CURVE DATA
ARC=60.74 CHORD=58.18
RADIUS=60.00 Δ=58°00'03"
CH BEARINGS=518°00'05"E

EXISTING CONTOUR
PROPOSED CONTOUR
100.00 EXISTING ELEVATION
100.00 PROPOSED ELEVATION
DIRECTION OF SURFACE
DRAINAGE

HOUSE ELEV. 695.25

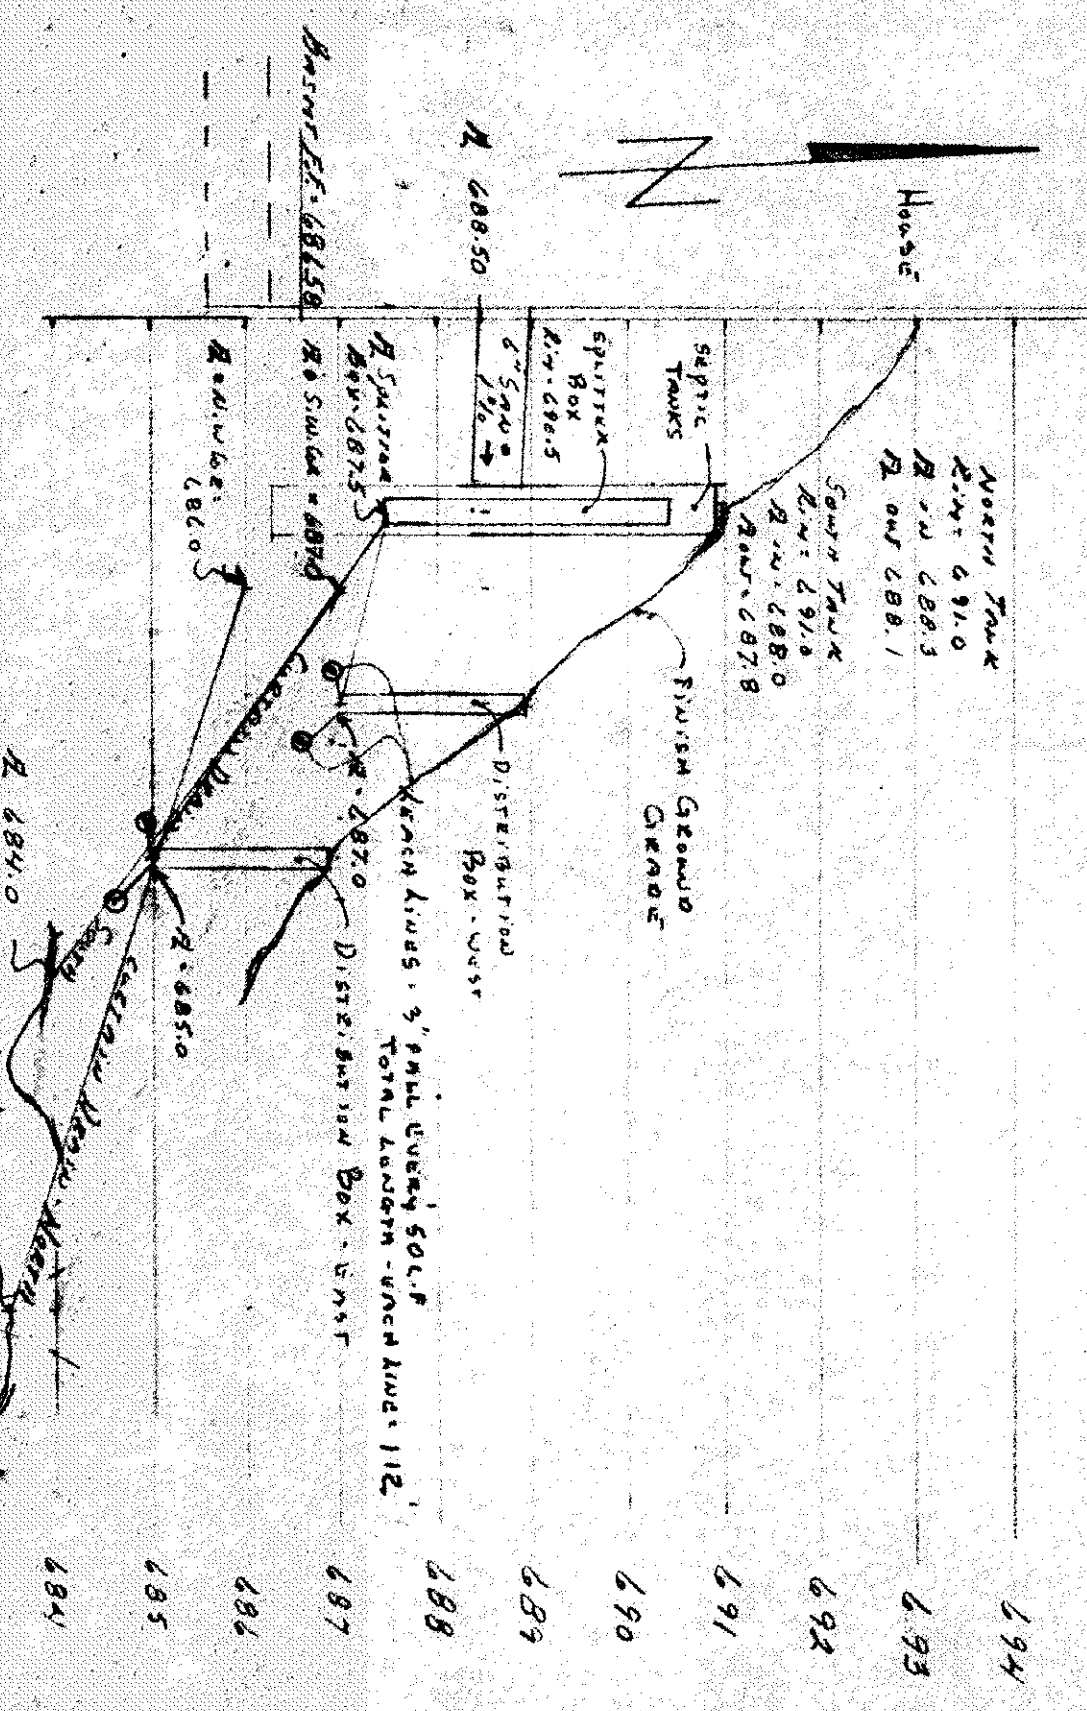

DISTRIBUTION
BOXES

PERFORATED PIPE 1" DIA. 1' DIA. 1' DIA.

SEWAGE DISPOSAL PERMIT MUST BE
OBTAINED BY A LAKE COUNTY LICENSED
INSTALLER BEFORE INSTALLATION IS
STARTED.

Grading Plan Approved
as shown and/or noted
THOMAS P. GILLES, P.E.
Lake County Engineer


JOEL LUGA, R.S., M.P.H.
Health Commissioner
BY *[Signature]*
Date *9-19-88*

LOW YIELD WATER
FIXTURES REQUIRED
ON ALL:
Shower Head
Toilet

BEACH MATH - TOP OF EXISTING DIRT
HYDRAUT - FRONT OF SUBSTATION ELEV. 695.50

A. To be brought to finished grade
1. Septic tank manhole covers
2. Splitter box covers
3. Distribution box cover

B. No top or drains or downspouts
to be discharged into septic tanks.
All waste water to be discharged into
septic tanks

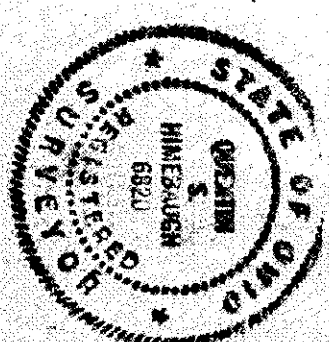

THIS PLAN WAS PREPARED BY ME AND IS
CORRECT TO THE BEST OF MY KNOWLEDGE
[Signature] 9-19-88

PLAN PREPARED BY QUENTIN HINERBAUGH
DRAWING NUMBER
WILLOUGHBY, OHIO 946-1761 88-100