

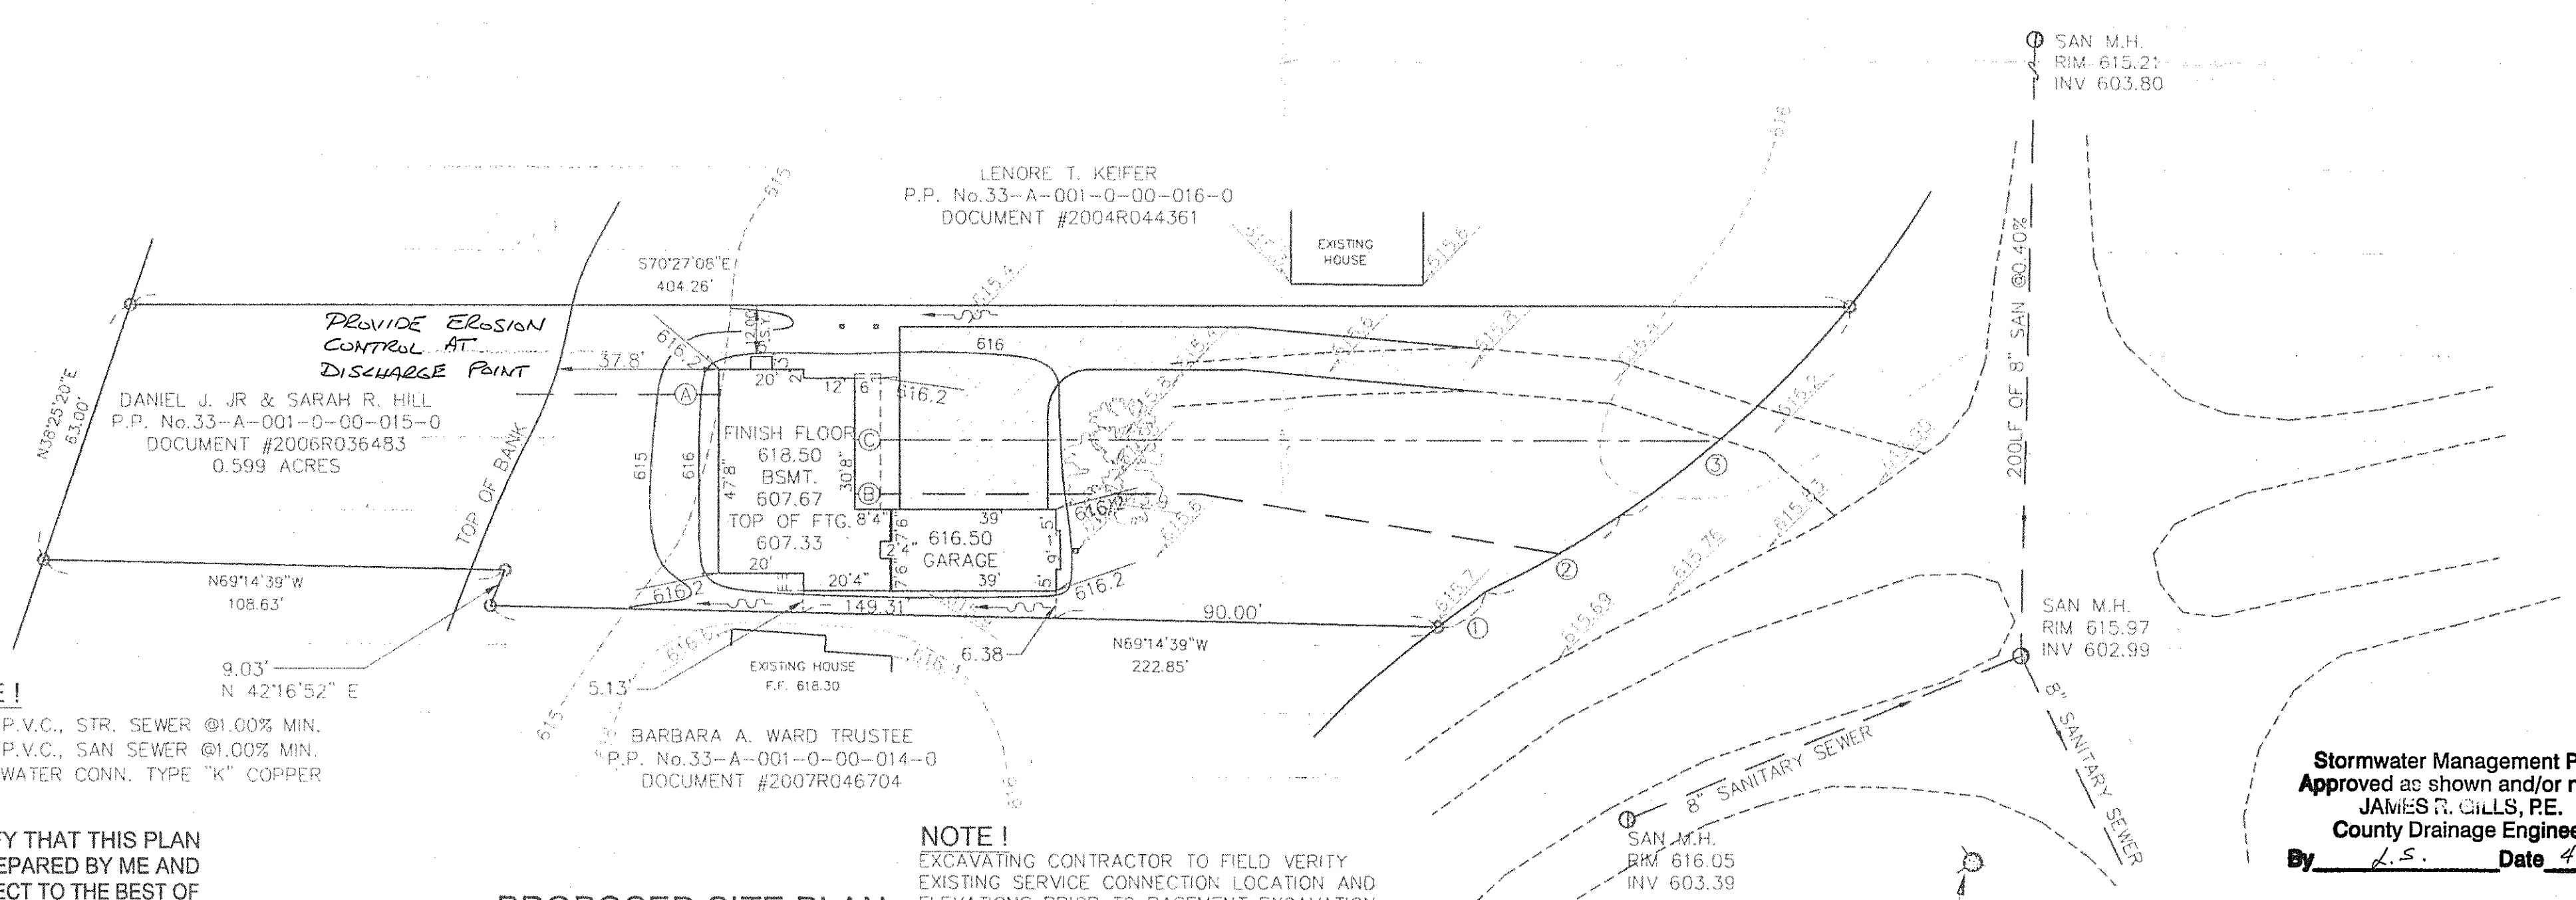


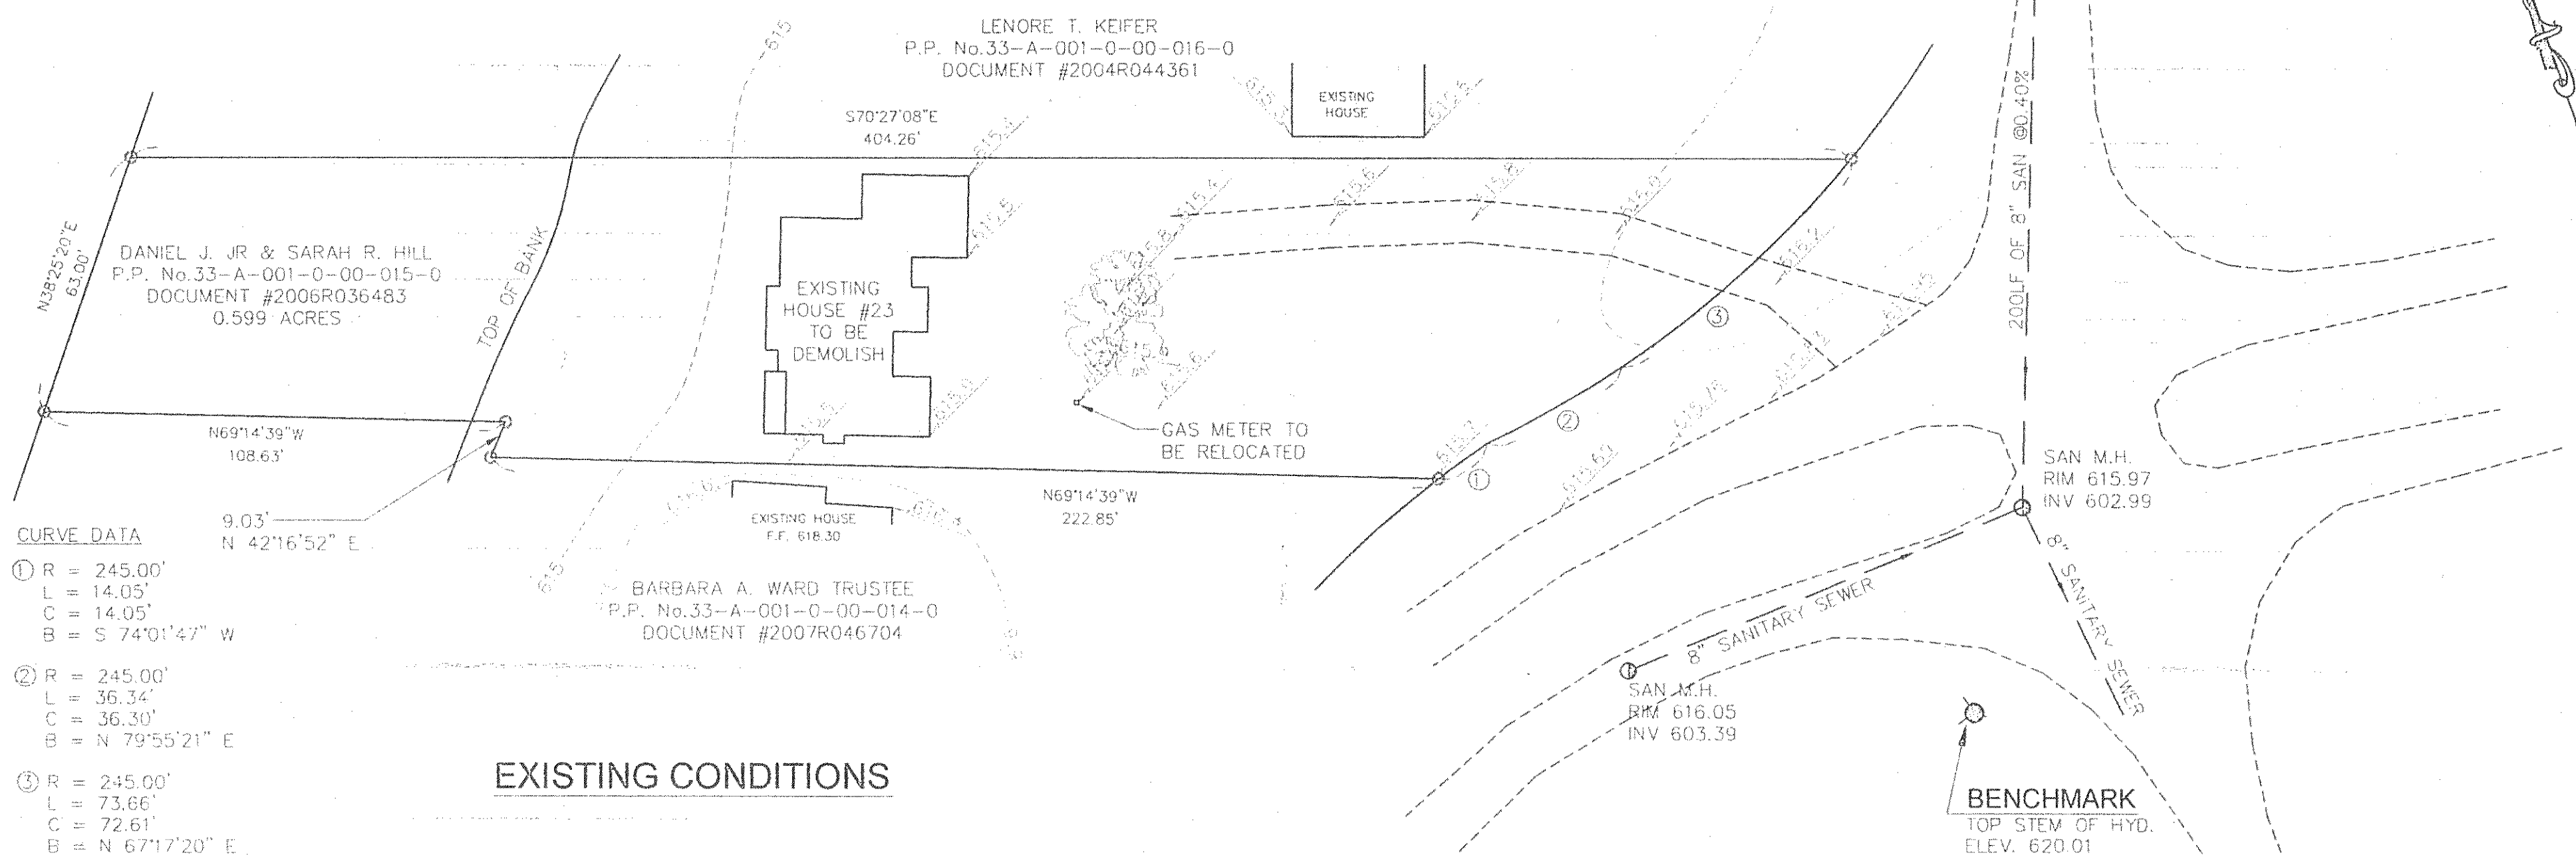

I CERTIFY THAT THIS PLAN WAS PREPARED BY ME AND IS CORRECT TO THE BEST OF MY KNOWLEDGE AND BELIEF

John C. Skonieczny
REG. SURVEYOR #8356

JOHN C. SKONIECZNY
7739 VIEWMOUNT DR.
PAINESVILLE, OHIO 44077
PH. 352-7742

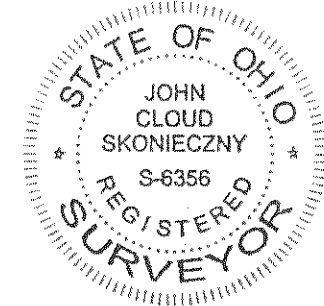


PROPOSED SITE PLAN



2 WORKING DAYS BEFORE YOU DIG

CALL TOLL FREE 800-362-2764

OHIO UTILITIES PROTECTION SERVICE

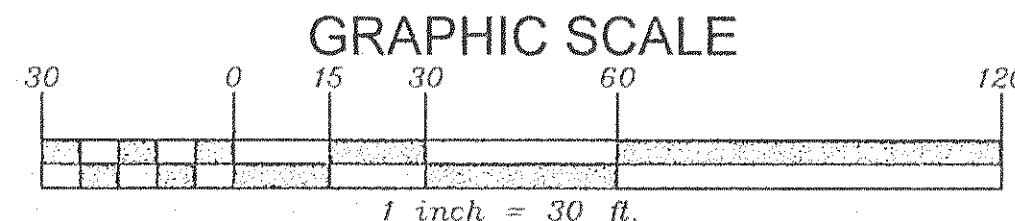

Stormwater Management Plan
Approved as shown and/or noted
JAMES T. GILLS, P.E.
County Drainage Engineer
By *L.S.* Date 4-22-08

SITE PLAN FOR:		DAN & SARA HILL 23 EAST SHORE	
SCALE: 1" = 30'	APPROVED:	DRAWN BY: SWC	REVISED:
DATE: MAR. 08			
KNOWN AS S/L 12 & PART OF S/L 11, BLOCK 1 OF THE LAKE SHORE BOULEVARD ESTATES SUB. AS RECORDED IN VOL. D PG. 55 OF THE L.C.R.P. VILLAGE OF TIMBERLAKE - COUNTY OF LAKE - STATE OF OHIO			
JOB# 08-4655		DRAWING NUMBER 08-2867	