


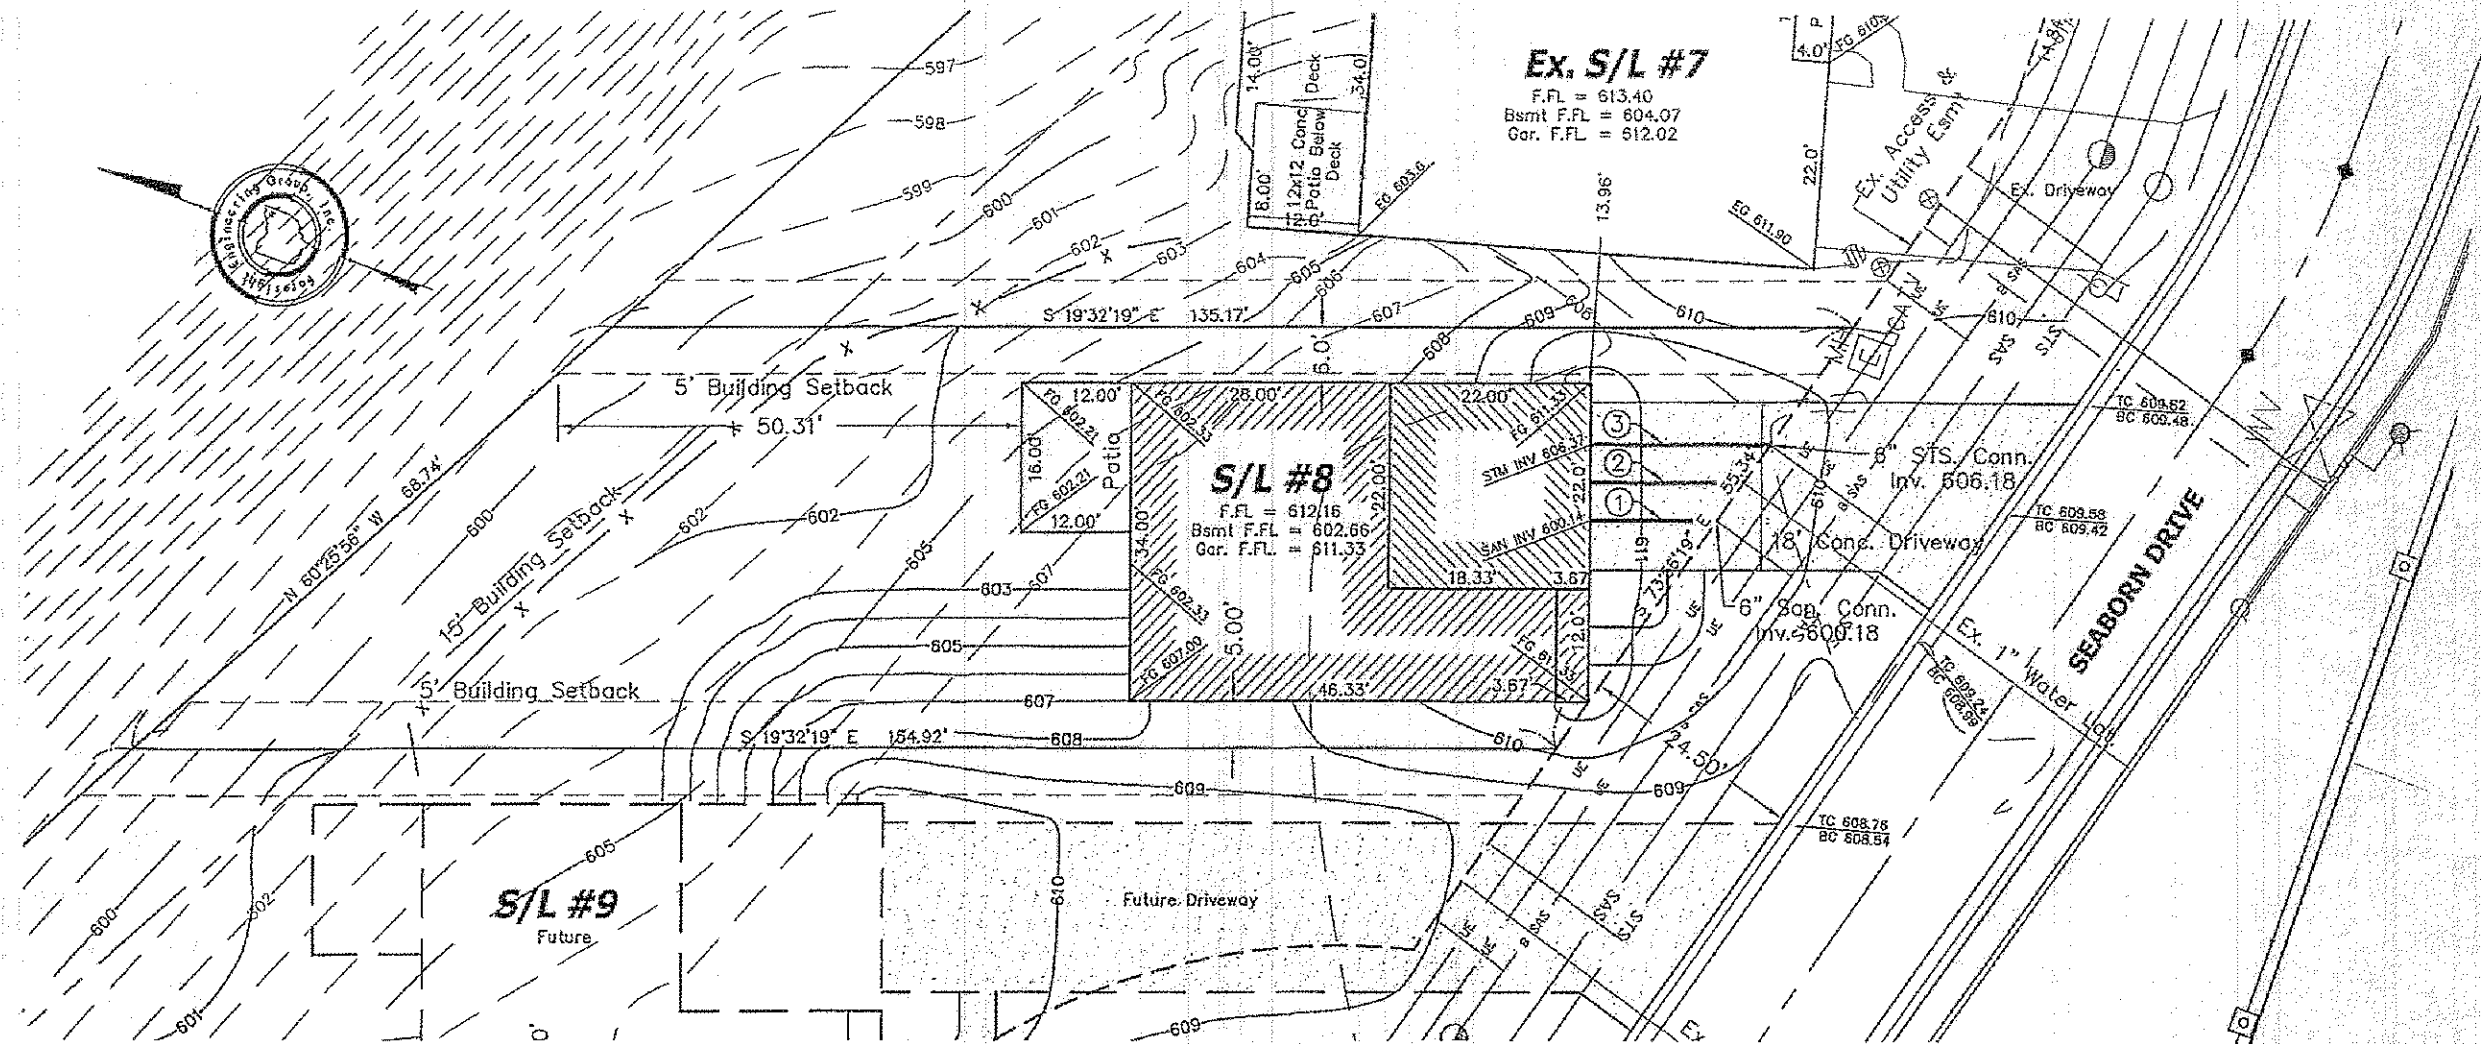

CONSTRUCTION SCHEDULE FOR EROSION CONTROL PLAN

1. Establish silt fences and/or combination barriers at top of proposed fill sections and any proposed temporary storm water discharge ditches, to allow for filtering of all storm water exiting the site.
2. Install Construction Entrance.
3. Install combination barriers around all Manholes and Catch Basins as they are constructed.
4. Clear and grade the construction area as necessary.
5. Accomplish all rough grading required for cuts and fills, and for House and Utility requirements.
6. Begin House Construction
7. Temporary seed all disturbed areas outside of proposed House and driveway areas.
8. Install Underground Utilities -- Sanitary Sewer Connection, Water Service, Electric, Phone, Cable.
9. Fine grade and seed entire project site.

- ① 14' ~ 6" San. Conn.
⊙ 1.0% Min.
- ② 17' ~ 1" Water Conn.
- ③ 20' ~ 6" STM. Conn.
⊙ 1.0% Min.

GENERAL NOTES:

1. Project Bench Mark -- Ex. Hydrant top of stem elevation = 618.84. Located at the intersection of Lake Shore Blvd. & Seaborn Drive.

Bench Mark -- Ex. Hydrant top of Stem elevation = 619.24. Located along Seaborn Drive at the future intersection across from units 41/42.
2. Proposed Drive ways shall be 6" Thick Concrete.
3. Permanent Down Spouts shall be connected to the storm sewer system.
4. Contractor shall field verify location and elevation of all existing lateral inverts that will service the proposed building prior to foundation excavation.
5. "Cleanout" refers to typical City Willowick Test Tee.
6. Contractor shall ensure positive storm drainage between buildings.


Stormwater Management Plan
Approved as shown and/or noted
JAMES R. GILLS, P.E.
County Drainage Engineer

By A.S. Date 5/28/13


CONTOUR LEGEND

Existing 1' Contours
Existing 5' Contours
Proposed 1' Contours
Proposed 5' Contours

EROSION CONTROL SYMBOLS

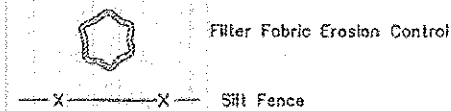

GRAPHIC SCALE

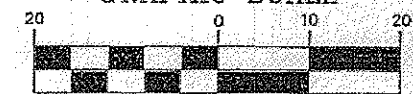


(IN FEET)
1 inch = 20 ft.

As-Built Certification

I, hereby certify that the circled grades and information represents as built conditions checked in the field on November 22, 2010 and are correct to the best of my knowledge.

Steven N. Roessner, P.S. 7070 Date

Chad E. Graber, P.E. 5/20/13 Pdlr

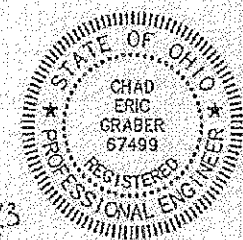

LARIMAR LAKEFRONT NEIGHBORHOOD
SUBLOT B
City of Willowick - Lake County - Ohio
Site Plan

SHEET NO.

 $1/2$

Foresight Engineering Group
Engineers & Surveyors
440 226-1100
226-1034 Fax
250 Bloor Street, Unit F
Toronto, Ont. M5G 1A5