

# GRAPHIC SCALE



( IN FEET )  
1 inch = 30 ft.

CURVE	LENGTH	RADIUS	CHORD	CHORD	BEARING	DELTA
C1	73.90	375.40	37.07	73.78	N 89°50'31"E	117°43'
C2	73.90	375.40	37.07	73.78	S 89°50'31"W	117°43'
C41	88.30	288.41	44.58	87.90	S 26°51'00"W	185°26'
C42	88.30	288.41	44.58	87.90	N 26°51'00"E	14°30'
C43	32.40	28.00	28.05	28.37	S 72°53'35"E	90°07'44"

**APPROVED AS NOTED**  
WILLOWICK BUILDING DEPT.

Signature

Date **5.10.07**

Water Management Plan  
Approved as shown and/or noted  
**JAMES R. GILLS, P.E.**  
County Drainage Engineer



By **J.S.** Date **5/14/07**

SITE PLAN FOR:  
SUBLOT No. 2 259 E 293 S  
**SHORELAND CROSSINGS No.2**  
CITY OF WILLOWICK - LAKE COUNTY - OHIO

## SURVEYOR CERTIFICATION

I HEREBY CERTIFY THAT I HAVE SURVEYED THE PREMISES AND PREPARED THE ATTACHED PLAT IN ACCORDANCE WITH THE PROVISIONS OF CHAPTER 4733-37 OF THE OHIO ADMINISTRATIVE CODE AND THE DIMENSIONS OF THE LOTS AND ROAD ARE IN FEET AND DECIMAL PARTS THEREOF, ALL OF WHICH ARE CORRECT TO THE BEST OF MY KNOWLEDGE AND BELIEF, IRON MONUMENTS OR PINS AS INDICATED WERE FOUND OR SET AS SHOWN HEREON.

DANIEL LAUX P.S. 7087 DATE **5-2-07**

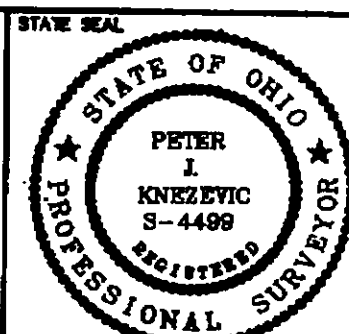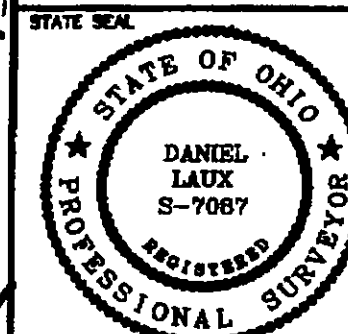

## DESIGN CERTIFICATION

THIS PLAN WAS PREPARED BY ME,  
AND IS CORRECT TO THE BEST  
OF MY KNOWLEDGE AND BELIEF.

PETER J. KNEZEVIC, P.S. 4499 DATE **5-2-07**

## "AS-BUILT" CERTIFICATION

I HEREBY CERTIFY THAT THE CIRCLED INFORMATION  
IS EXISTING AS OBTAINED ON THE SITE  
AND IS CORRECT TO THE BEST OF MY KNOWLEDGE  
AND BELIEF.

NAME \_\_\_\_\_ DATE \_\_\_\_\_

Prepared By:  
**PETER J. KNEZEVIC, P.S.**  
30102 Rickey Lane  
Wickliffe, Ohio 44092  
(440)944-3794

Prepared For:  
**B.R. Knez Construction, Inc.**  
3375 Blackmore Road  
Perry Township, Ohio 44061  
(440)259-0087

## BENCHMARK:

B.M. = T.B.M Set On Rim Ex. San. Manhole  
Located In Front Of Adj. S/L 1  
Elevation 617.44

DATE: **5/1/07**  
SCALE: HOR. **1"=30'**  
VERT. **1"=5'**  
FILENAME: **sublot 2.txd**  
COMPUTER: **SS**  
CADD: **SS**

## CONTRACT No.

**07087-S/L 2**

SHEET **1** OF **1**

NOTE:  
Backflow Preventor Required  
For Sanitary Connections.

EXISTING UNDERGROUND UTILITIES NOTE:  
THE SIZE AND LOCATION, BOTH HORIZONTAL AND VERTICAL  
OF THE UNDERGROUND UTILITIES SHOWN HEREON, HAVE BEEN  
OBTAINED BY A SEARCH OF AVAILABLE RECORDS. VERIFICATION  
BY FIELD OBSERVATION HAS BEEN CONDUCTED WHERE PRACTICAL.  
HOWEVER, DESIGNER DOES NOT GUARANTEE THE COMPLETENESS  
NOR ACCURACY THEREOF.

**2 WORKING DAYS  
BEFORE YOU DIG**  
CALL TOLL FREE **800-362-2764**  
OHIO UTILITIES PROTECTION SERVICE  
NON-MEMBERS MUST BE CALLED DIRECT

