


GRAPHIC SCALE

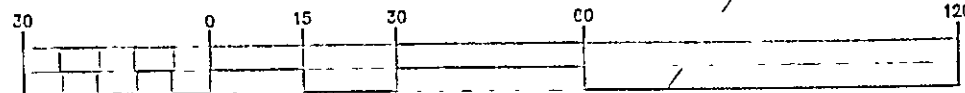

(IN FEET)
1 inch = 30 ft.

Not a Professional Engineer
Chuck Spivey 3/11/08
Memo
This Review is for general plan & scope only and does not
relate to the author of these documents from professional
responsibility for accuracy of design conforming to
applicable ordinances and codes or errors.

Lake Shore Blvd. (80')


BLOCK A
37,018 sq. ft.
0.8498 acres

UTILITY CONNECTIONS NOTE:
-Water Connections To Be 1";
-Sanitary Connections Shall Be
6" At Minimum 1.0%;
-Storm Connections Shall Be
6" At Minimum 1.0%.

CURVE DATA					
CH	STATION	PC	PT	PI	EA
61	51.71	73.50	25.67	51.14	53.12

APPROVED AS NOTED
WILLOWICK BUILDING DEPT

Signature: *[Signature]*
Date: 4-7-08

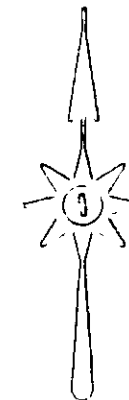


SITE PLAN FOR:
UNIT No's. 107, 108, 109 Add. #320, 318, 316
PPN: 28-A-041-N-00-107, 108 & 109-0
SHORELAND CROSSINGS No. 2
CITY OF WILLOWICK - LAKE COUNTY - OHIO

SURVEYOR CERTIFICATION


I HEREBY CERTIFY THAT I HAVE SURVEYED THE PREMISES AND PREPARED
THE ATTACHED PLAN IN ACCORDANCE WITH THE PROVISIONS OF CHAPTER
4733-37 OF THE OHIO ADMINISTRATIVE CODE AND THE DIMENSIONS OF
THE LOTS AND ROAD ARE IN FEET AND DECIMAL PARTS THEREOF, ALL OF
WHICH ARE CORRECT TO THE BEST OF MY KNOWLEDGE AND BELIEF, FROM
MONUMENTS OR PINS AS INDICATED WERE FOUND ON SITE AS SHOWN HEREON

[Signature] 3/12/08
DATE

STATE SEAL

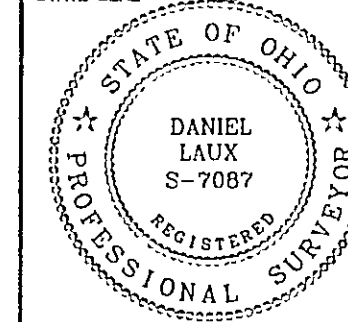

STATE SEAL

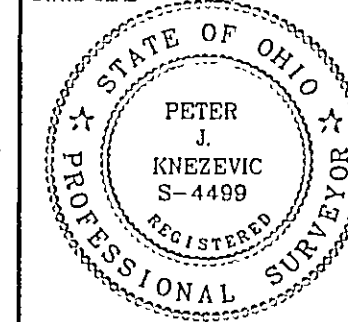

DESIGN CERTIFICATION

THIS PLAN WAS PREPARED BY ME,
AND IS CORRECT TO THE BEST
OF MY KNOWLEDGE AND BELIEF.

[Signature] 5/12/08
DATE
PETER J. KNEZEVIC, P.S. 4499

"AS-BUILT" CERTIFICATION

I HEREBY CERTIFY THAT THE CIRCLED INFORMATION
IS EXISTING AS OBTAINED ON THE SITE
AND IS CORRECT TO THE BEST OF MY KNOWLEDGE
AND BELIEF.

NAME _____ DATE _____

Prepared By:
PETER J. KNEZEVIC, P.S.
30102 Rickay Lane
Wickliffe, Ohio 44092
(440) 944-3794

Prepared For:
B.R. Knez Construction, Inc.
3375 Blackhawk Road
Perry Township, Ohio 44081
(440) 259-0057

BENCHMARK:

B.M. = T.B.M Set On Top Of Hydrant
Located As Noted
Elevation 618.56

DATE: 2/6/07
SCALE: HOR. 1"=30'
VERT. _____
FILE NAME: Unit 107-109.dwg
COMPUTER: S
CREW CHIEF: B.D.V.

CONTRACT No.

07067-S/L107-109

SHEET	OF
1	1

NOTE: HOUSE DIMENSIONS AND FLOOR
ELEVATIONS TO BE VERIFIED BY
ARCHITECT & BUILDER.

NOTE:
Backflow Preventor Required
For Sanitary Connections.

Site & Grade Unit 2-7-09

EXISTING UNDERGROUND UTILITIES NOTE
THE SIZE AND LOCATION, BOTH HORIZONTAL AND VERTICAL
OF THE UNDERGROUND UTILITIES SHOWN HEREON, HAVE BEEN
OBTAINED BY A SEARCH OF AVAILABLE RECORDS. VERIFICATION
BY FIELD OBSERVATION HAS BEEN CONDUCTED WHERE PRACTICAL
HOWEVER, DESIGNER DOES NOT GUARANTEE THE COMPLETENESS
NOR ACCURACY THEREOF

Stormwater Management Plan
Approved as shown & noted
JAMES R. GILLS, P.E.

County Drainage Engineer

**2 WORKING DAYS
BEFORE YOU DIG**
CALL TOLL FREE 800-362-2764
OHIO UTILITIES PROTECTION SERVICE
NON-MEMBERS MUST BE CALLED DIRECT