


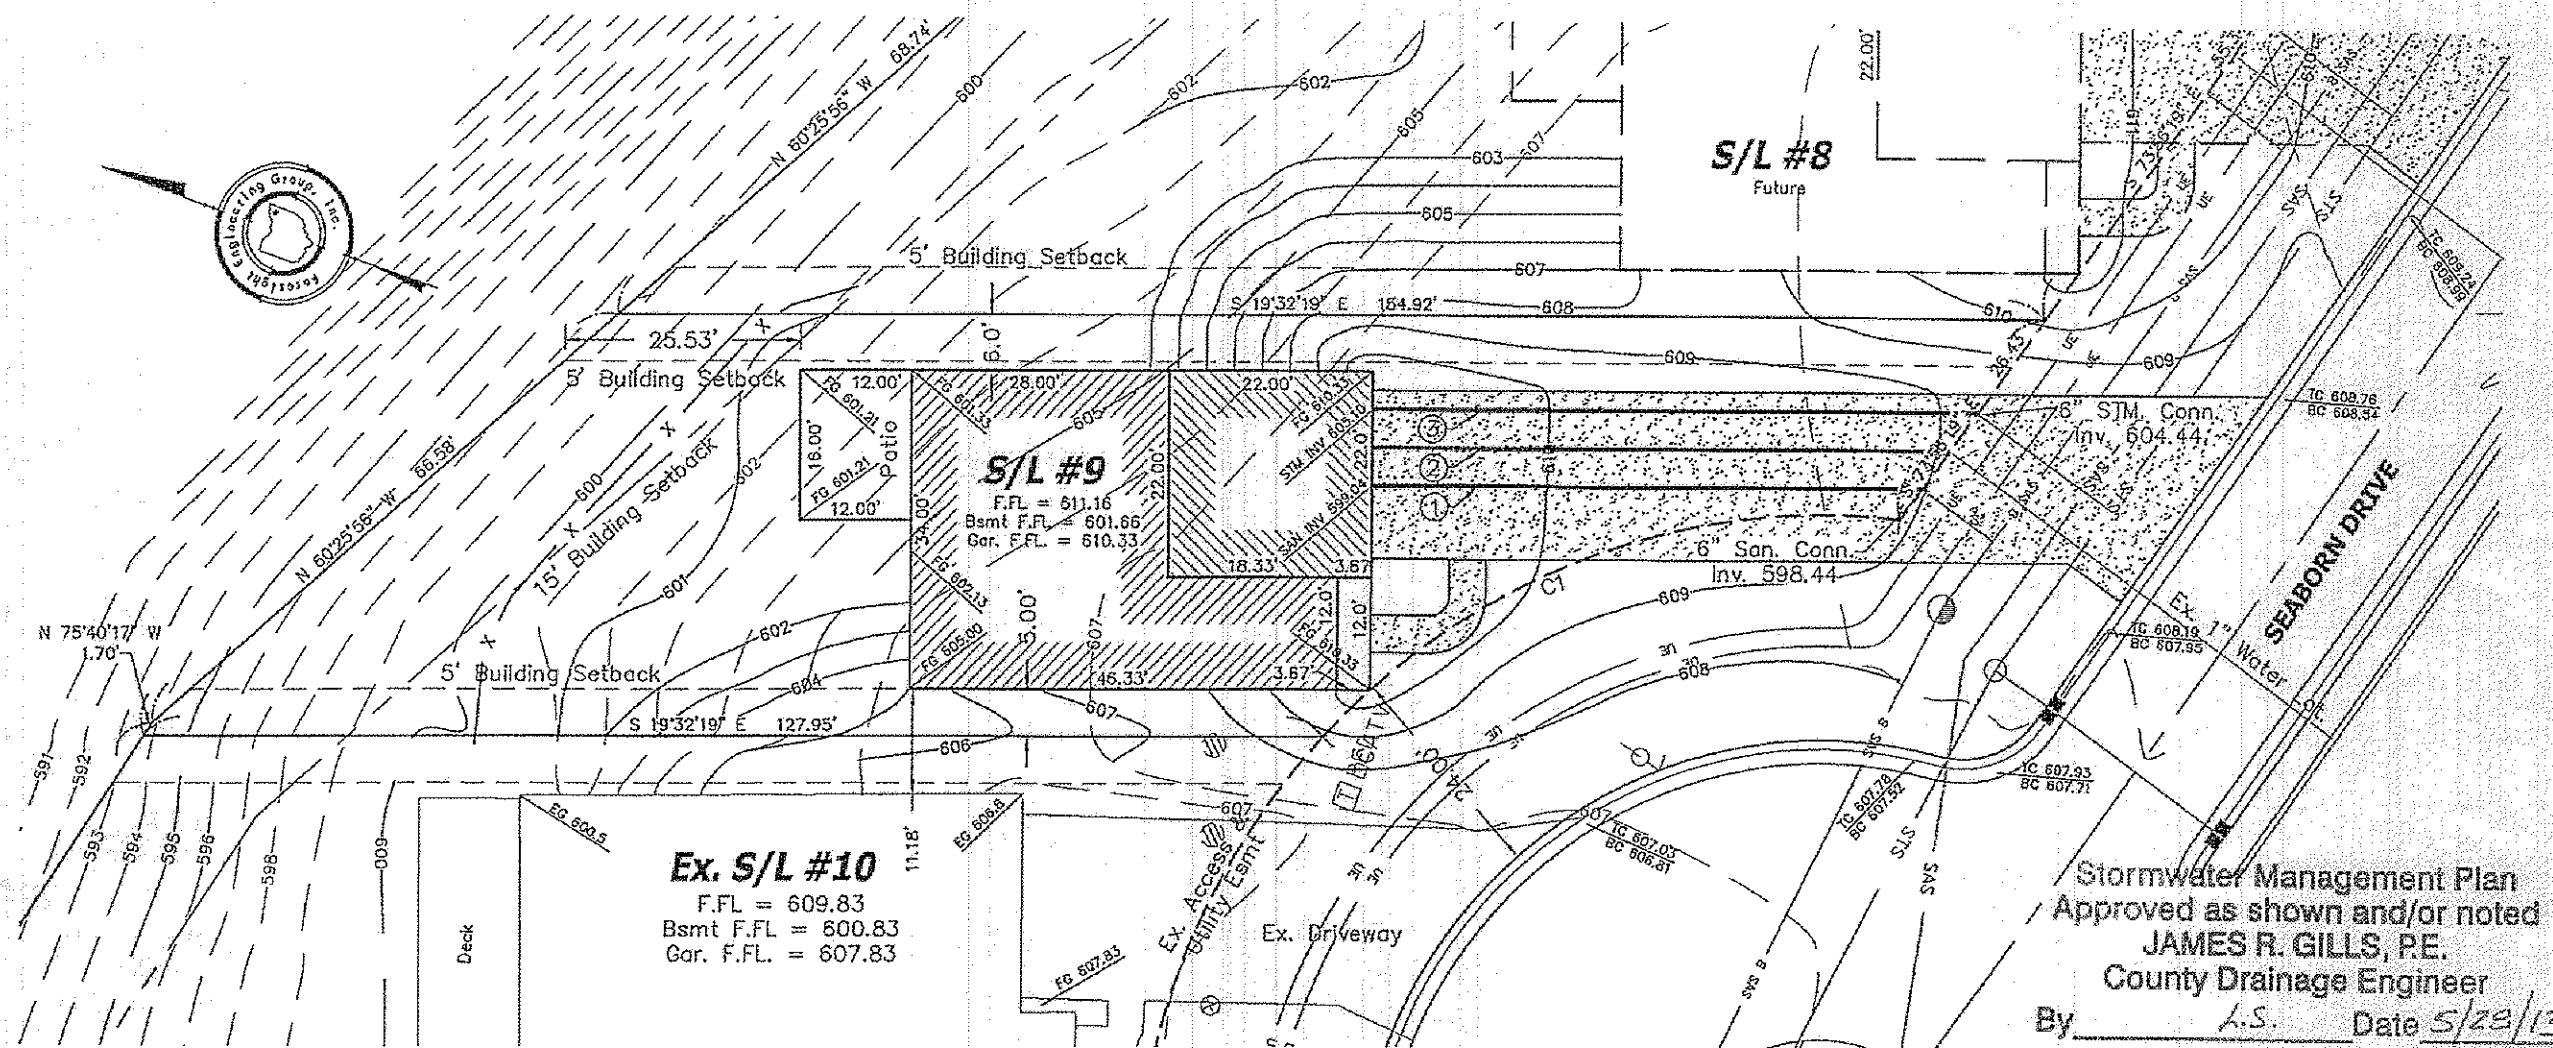

CONSTRUCTION SCHEDULE FOR EROSION CONTROL PLAN

1. Establish silt fences and/or combination barriers at top of proposed fill sections and any proposed temporary storm water discharge ditches, to allow for filtering of all storm water exiting the site.
2. Install Construction Entrance.
3. Install combination barriers around all Manholes and Catch Basins as they are constructed.
4. Clear and grade the construction area as necessary.
5. Accomplish all rough grading required for cuts and fills, and for House and Utility requirements.
6. Begin House Construction
7. Temporary seed all disturbed areas outside of proposed House and driveway areas.
8. Install Underground Utilities - Sanitary Sewer Connection, Water Service, Electric, Phone, Cable.
9. Fine grade and seed entire project site.

- ① 60' ~ 6" San. Conn. @ 1.0% Min.
- ② 63' ~ 1" Water Conn.
- ③ 66' ~ 6" STM. Conn. @ 1.0% Min.

GENERAL NOTES:

1. Project Bench Mark - Ex. Hydrant top of stem elevation = 618.84. Located at the intersection of Lake Shore Blvd. & Seaborn Drive.
Bench Mark - Ex. Hydrant top of Stem elevation = 619.24. Located along Seaborn Drive at the future intersection across from units 41/42.
2. Proposed Drive ways shall be 6" Thick Concrete.
3. Permanent Down Spouts shall be connected to the storm sewer system.
4. Contractor shall field verify location and elevation of all existing lateral inverts that will service the proposed building prior to foundation excavation.
5. "Cleanout" refers to typical City Willowick Test Tee.
6. Contractor shall ensure positive storm drainage between buildings.


CURVE TABLE						
CURVE	Delta	Length	Radius	Tangent	Chord Bearing	Chord Distance
C1	53°32'25"	69.62'	74.50'	37.58'	N40°02'42"W	67.11'

CONTOUR LEGEND

- Existing 1' Contours
- Existing 5' Contours
- Proposed 1' Contours
- Proposed 5' Contours

EROSION CONTROL SYMBOLS


- Filter Fabric Erosion Control
- Silt Fence

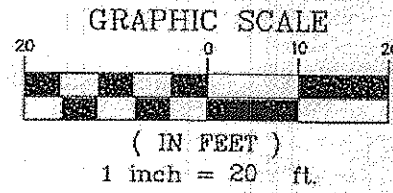

As-Built Certification
I, hereby certify that the circled grades and information represents as built conditions checked in the field on November 22, 2010 and are correct to the best of my knowledge.

Steven N. Roessner, P.S. 7070 Date

[Signature]
Chad E. Graber, P.E. 5/20/13 Date

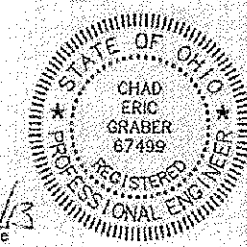

LARIMAR LAKEFRONT NEIGHBORHOOD
SUBLOT 9
City of Willowick - Lake County - Ohio
Site Plan

Foresight Engineering Group
Engineers & Surveyors
140 248-1000
140 248-1001
140 248-1002
Chardon, Ohio 44024

SCALE: Horiz. 1"=20'	Vert. 1"=20'
FILE NAME: W020001\SP S/L 9	DATE: May 20, 2013