


GRAPHIC SCALE



(IN FEET)
1 inch = 30 ft.

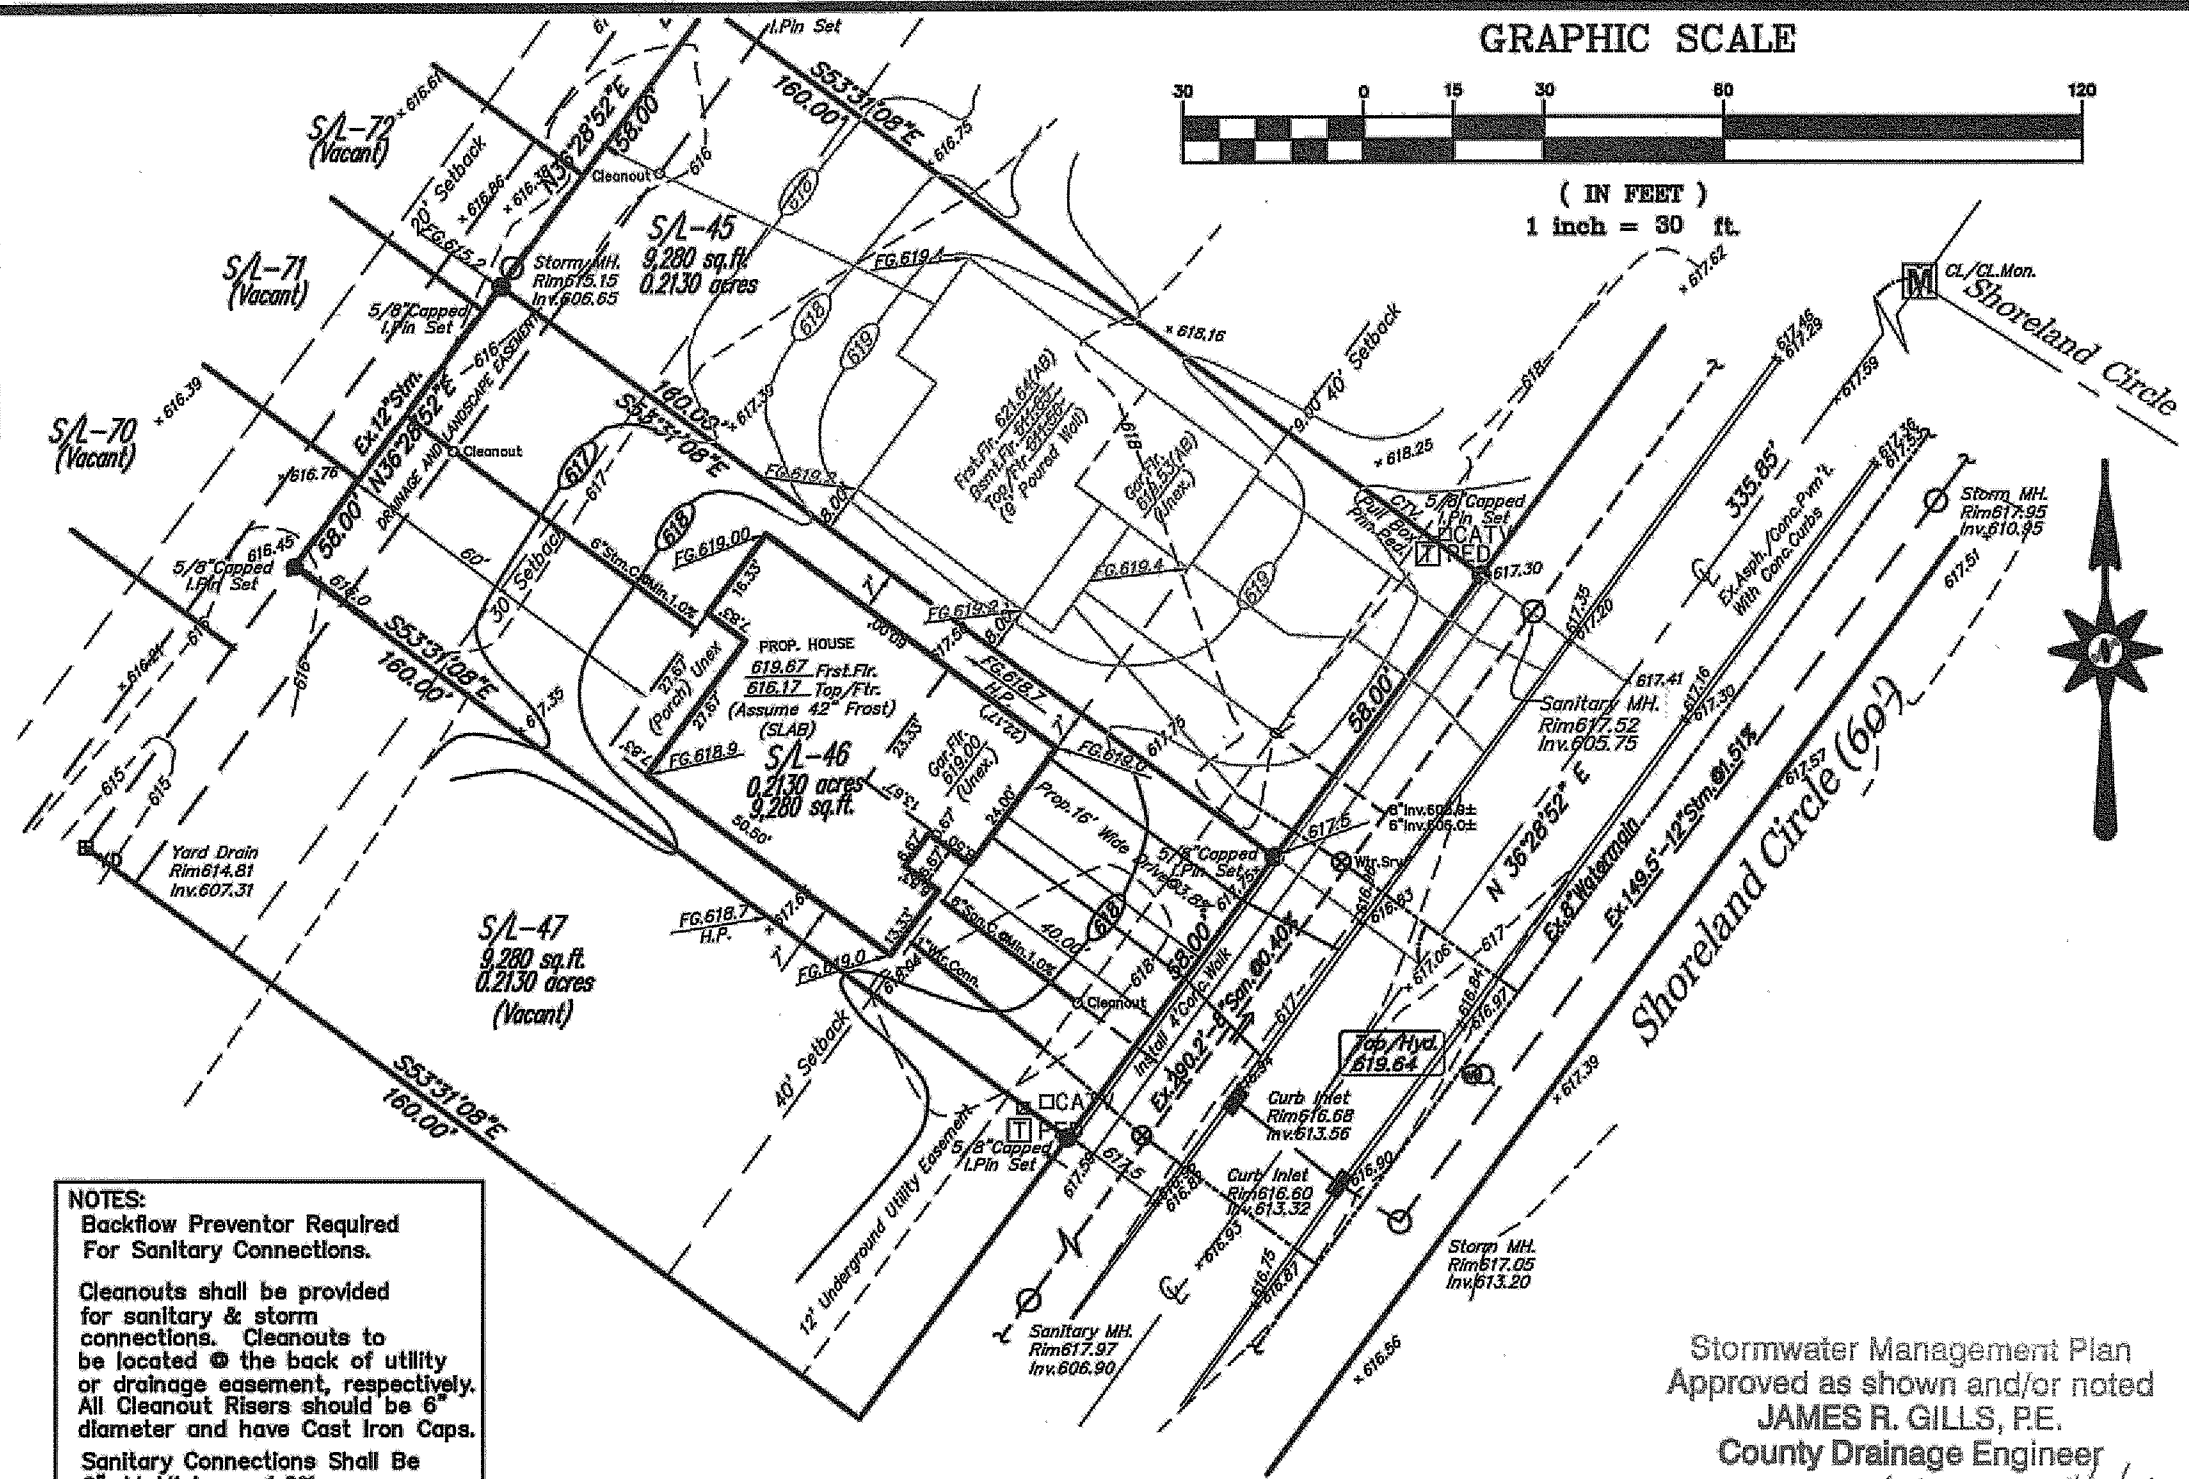

NOTES:
Backflow Preventor Required For Sanitary Connections.
Cleanouts shall be provided for sanitary & storm connections. Cleanouts to be located @ the back of utility or drainage easement, respectively. All Cleanout Risers should be 6\"/>

REVIEWED BY:
Polaris Engineering & Surveying, Inc.
Chuck Szym 4/3/14
Name _____ Date _____
This Review is for general plan & scope only and does not relieve the author of these documents from professional responsibility for accuracy of design conformity to applicable ordinances and errors or omissions.



NOTE: HOUSE DIMENSIONS AND FLOOR ELEVATIONS TO BE VERIFIED BY ARCHITECT & BUILDER.

Stormwater Management Plan
Approved as shown and/or noted
JAMES R. GILLS, P.E.
County Drainage Engineer
By L.S. Date 4/7/14

EXISTING UNDERGROUND UTILITIES NOTE:
THE SIZE AND LOCATION, BOTH HORIZONTAL AND VERTICAL OF THE UNDERGROUND UTILITIES SHOWN HEREON, HAVE BEEN OBTAINED BY A SEARCH OF AVAILABLE RECORDS. VERIFICATION BY FIELD OBSERVATION HAS BEEN CONDUCTED WHERE PRACTICAL. HOWEVER, DESIGNER DOES NOT GUARANTEE THE COMPLETENESS NOR ACCURACY THEREOF.

SITE PLAN FOR:
SUBLOT No.46, Add.#194
PPN: 28-A-041-N-00-045-0
SHORELAND CROSSINGS No.2
CITY OF WILLOWICK - LAKE COUNTY - OHIO

SURVEYOR CERTIFICATION
I HEREBY CERTIFY THAT I HAVE SURVEYED THE PREMISES AND PREPARED THE ATTACHED PLAN IN ACCORDANCE WITH THE PROVISIONS OF CHAPTER 4733-37 OF THE OHIO ADMINISTRATIVE CODE AND THE DIMENSIONS OF THE LOTS AND ROAD ARE IN FEET AND DECIMAL PARTS THEREOF, ALL OF WHICH ARE CORRECT TO THE BEST OF MY KNOWLEDGE AND BELIEF. IRON MONUMENTS OR PINS AS INDICATED WERE FOUND OR SET AS SHOWN HEREON.
Daniel Laux
DANIEL LAUX P.S. #7087 DATE _____

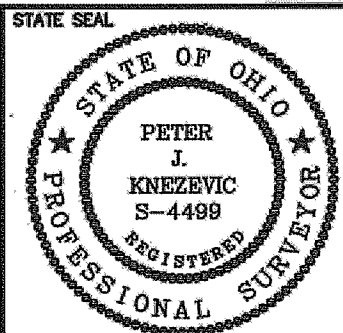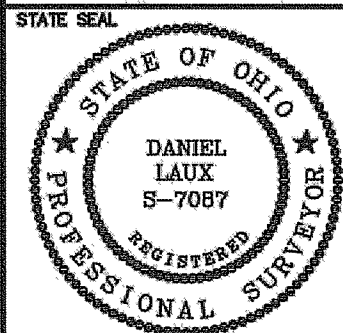

DESIGN CERTIFICATION
THIS PLAN WAS PREPARED BY ME, AND IS CORRECT TO THE BEST OF MY KNOWLEDGE AND BELIEF.
Peter J. Knezevic
PETER J. KNEZEVIC, P.S.4499 DATE _____

"AS-BUILT" CERTIFICATION
I HEREBY CERTIFY THAT THE CIRCLED INFORMATION IS EXISTING AS OBTAINED ON THE SITE AND IS CORRECT TO THE BEST OF MY KNOWLEDGE AND BELIEF.

NAME _____	DATE _____
Prepared By: PETER J. KNEZEVIC, P.S. 30102 Rickey Lane Wickliffe, Ohio 44092 (440)944-3794	Prepared For: B.R. Knez Construction, Inc. 8023 Crile Road Unit 250 Concord Township, Ohio 44077 (440)710-0711

BENCHMARK:
B.M. = T.B.M Set On Top Of Hydrant
Located As Noted
Elevation 619.64

DATE: <u>4/3/14</u>	CONTRACT No. 07067-S/L46
SCALE: HOR. 1"=30' VERT. 1"=0'	
FILENAME: <u>sublot 46.dwg</u>	SHEET <u>1</u> OF <u>1</u>
COMPUTER: <u>S</u>	
CREW CHIEF: <u>R.D.W.</u>	

2 WORKING DAYS BEFORE YOU DIG
CALL TOLL FREE 800-362-2764
OHIO UTILITIES PROTECTION SERVICE
NON-MEMBERS MUST BE CALLED DIRECT