

RECEIVED

SEP 04 2007

POLARIS ENGINEERING
& SURVEYING

APPROVED AS NOTED

WILLOWICK BUILDING DEPT.

Signature

Date

Stormwater Management Plan
Approved as shown and/or noted
JAMES R. GILLS, P.E.
County Drainage Engineer

By L.S. Date 9/14/07

NOTE: HOUSE DIMENSIONS AND FLOOR
ELEVATIONS TO BE VERIFIED BY
ARCHITECT & BUILDER.

NOTE:
Backflow Preventor Required
For Sanitary Connections.


SITE PLAN FOR:
SUBLOT No. 5
SHORELAND CROSSINGS No.2
CITY OF WILLOWICK - LAKE COUNTY - OHIO

SURVEYOR CERTIFICATION

I HEREBY CERTIFY THAT I HAVE SURVEYED THE PREMISES AND PREPARED
THE ATTACHED PLAT IN ACCORDANCE WITH THE PROVISIONS OF CHAPTER
4733-37 OF THE OHIO ADMINISTRATIVE CODE AND THE DIMENSIONS OF
THE LOTS AND ROAD ARE IN FEET AND DECIMAL PARTS THEREOF, ALL OF
WHICH ARE CORRECT TO THE BEST OF MY KNOWLEDGE AND BELIEF, IRON
MONUMENTS OR PINS AS INDICATED WERE FOUND OR SET AS SHOWN HEREON.

Dan Laux 8/9/07
DANIEL LAUX P.S. #7087 DATE

STATE SEAL

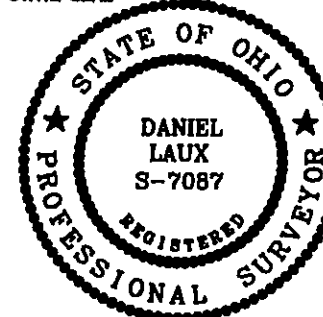

STATE SEAL



DESIGN CERTIFICATION

THIS PLAN WAS PREPARED BY ME,
AND IS CORRECT TO THE BEST
OF MY KNOWLEDGE AND BELIEF.

Peter J. Knezevic 9-7-07
PETER J. KNEZEVIC, P.S.4499 DATE

"AS-BUILT" CERTIFICATION

I HEREBY CERTIFY THAT THE CIRCLED INFORMATION
IS EXISTING AS OBTAINED ON THE SITE
AND IS CORRECT TO THE BEST OF MY KNOWLEDGE
AND BELIEF.

NAME

DATE

Prepared By:

PETER J. KNEZEVIC, P.S.
30102 Riskey Lane
Wickliffe, Ohio 44092
(440)944-3794

Prepared For:

B.R. Knez Construction, Inc.
3375 Blockmore Road
Perry Township, Ohio 44081
(440)259-0087

BENCHMARK:

B.M. = T.B.M Set On Top Of Hydrant
Located In Front Of Adj. S/L 5&6
Elevation 620.71

DATE: 8/10/07

SCALE: HOR. 1"=30'

VERT. 1"=6'

FILENAME: sublot 5 topo.dwg

COMPUTER: SE

CREW CHIEF: P.J.S.

CONTRACT No.

07067-S/L 5

SHEET

1

OF

1

EXISTING UNDERGROUND UTILITIES NOTE:
THE SIZE AND LOCATION, BOTH HORIZONTAL AND VERTICAL
OF THE UNDERGROUND UTILITIES SHOWN HEREON, HAVE BEEN
OBTAINED BY A SEARCH OF AVAILABLE RECORDS. VERIFICATION
BY FIELD OBSERVATION HAS BEEN CONDUCTED WHERE PRACTICAL.
HOWEVER, DESIGNER DOES NOT GUARANTEE THE COMPLETENESS
NOR ACCURACY THEREOF.



2 WORKING DAYS
BEFORE YOU DIG



CALL TOLL FREE 800-362-2764

OHIO UTILITIES PROTECTION SERVICE
NON-MEMBERS MUST BE CALLED DIRECT

Yard Drain
Rim 616.50 (Plan)
Inv. 610.93 (Plan)

Site & Grade Hse. 8-10-07